

2041

SURVEY OF LOTS 12077, 12078, 11626, & 11696

MASSILLON, STARK, OHIO


FOR AVERY CALHOUN

DATE JAN. 11, 1962

R.F. WAGONER

BY ~~REGISTERED~~ - REGISTERED ~~SURVEYOR~~ SURVEYOR #4787

SCALE: 1"=50'

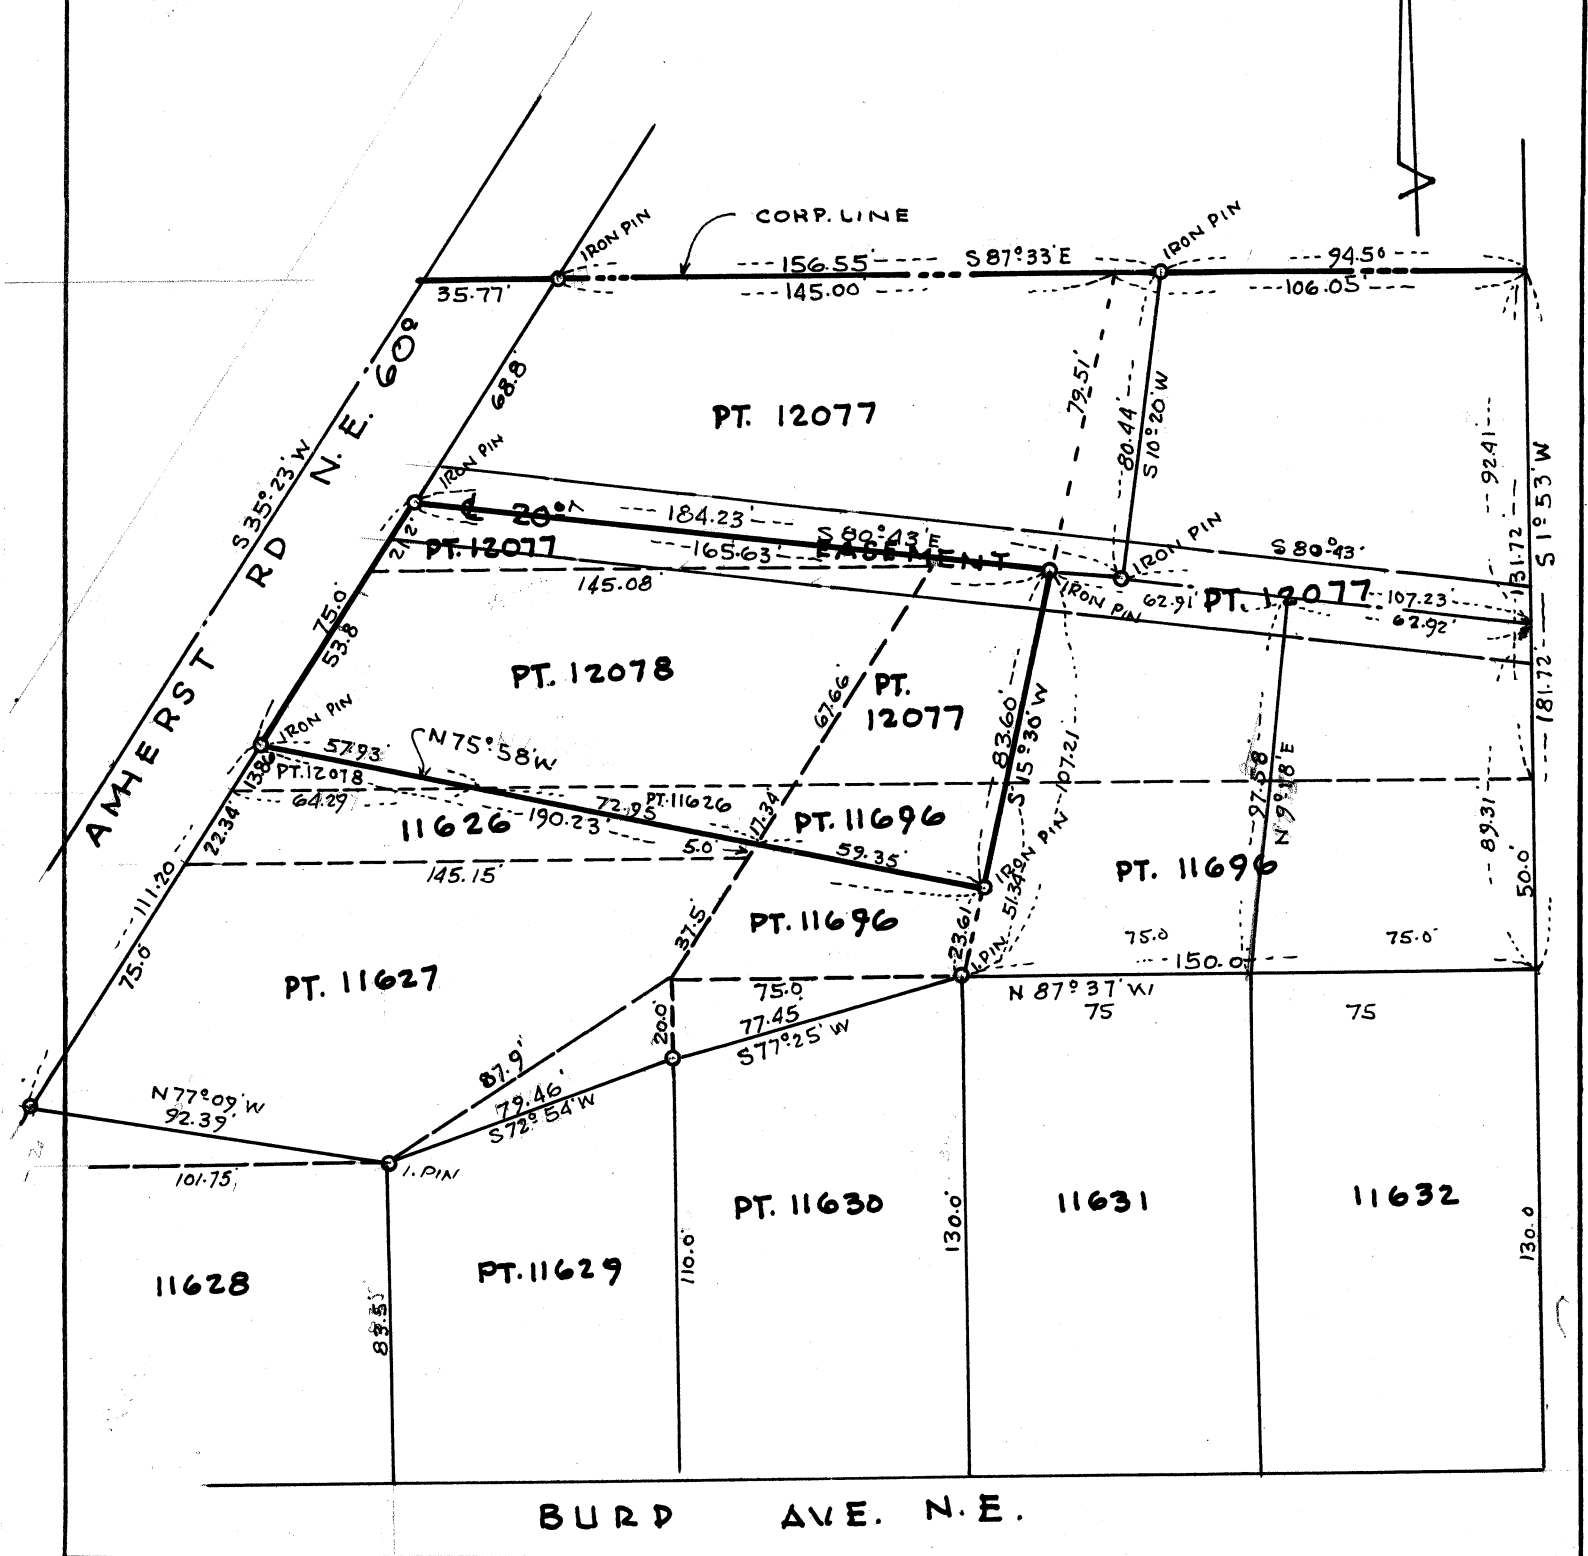

SURVEY OF PT. LOT NO. 11630


MASSILLON, STARK, OHIO

FOR AVERY CALHOUN

DATE Nov. 1961

R.F. WAGONER
BY ~~XXXXXXXXXX~~ - REGISTERED ~~XXXXXXXXXX~~ SURVEYOR

SCALE: 1" = 30'

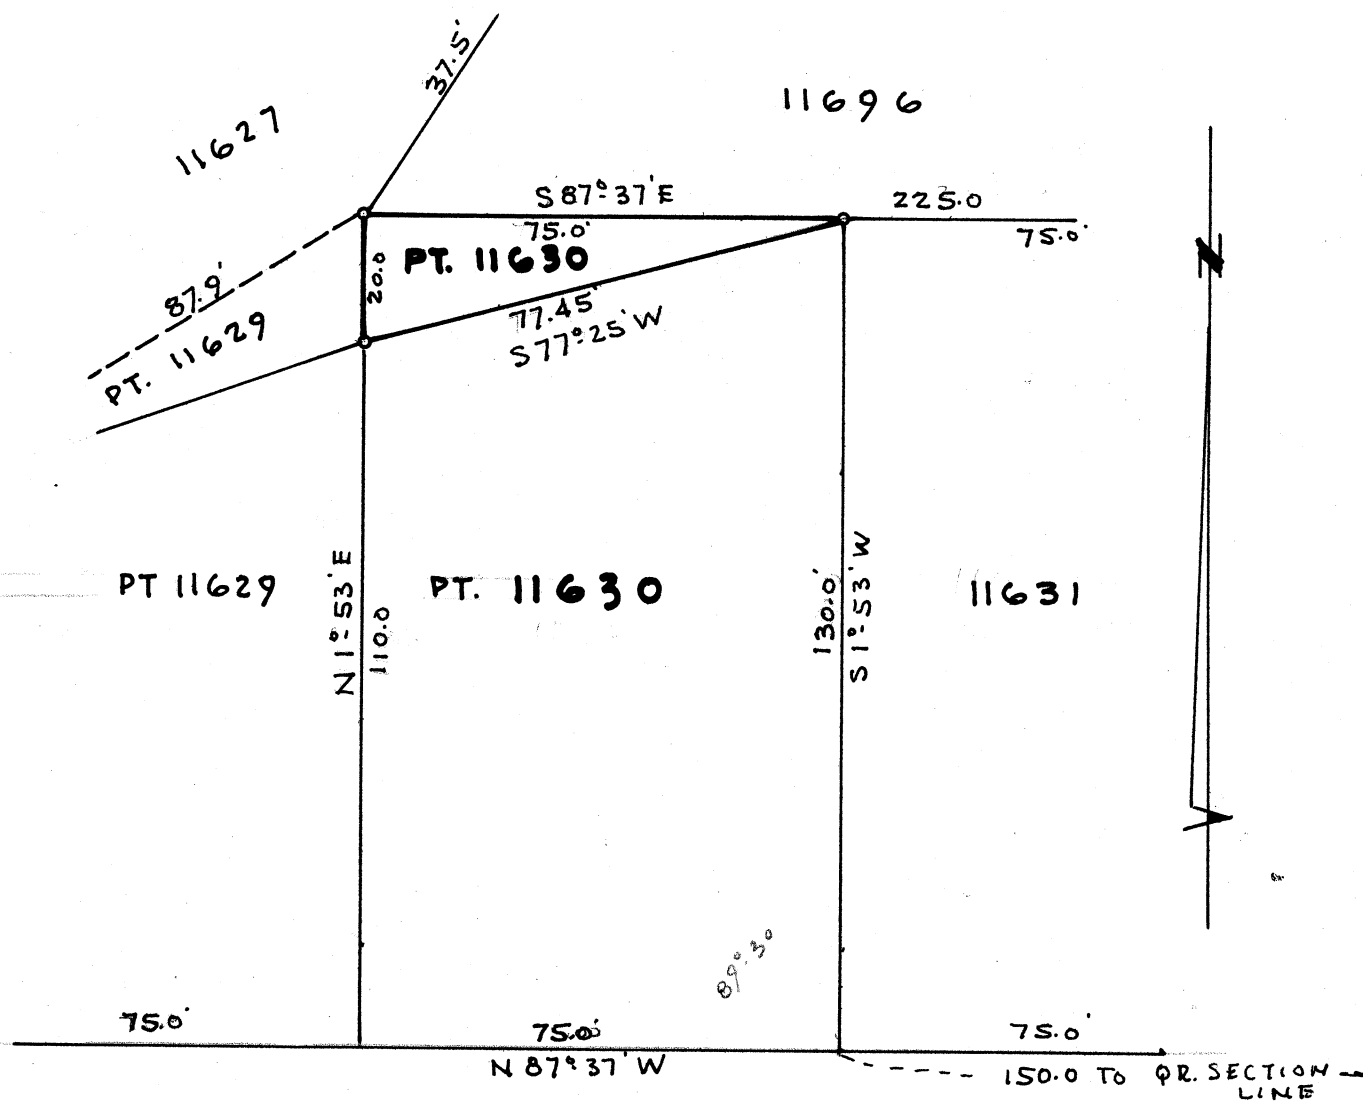

~~BURD AVE. N. E. 50'~~