



~~STATE~~ ~~AVE.~~ ~~N.E.~~ ~~60°~~

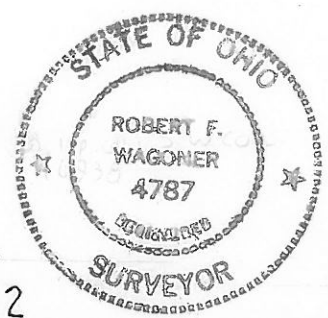

SURVEY OF LOT 1412
SCALE 1"=30' JUNE 12, 1995
BY ROBERT F. WAGONER REG SURVEYOR 4787

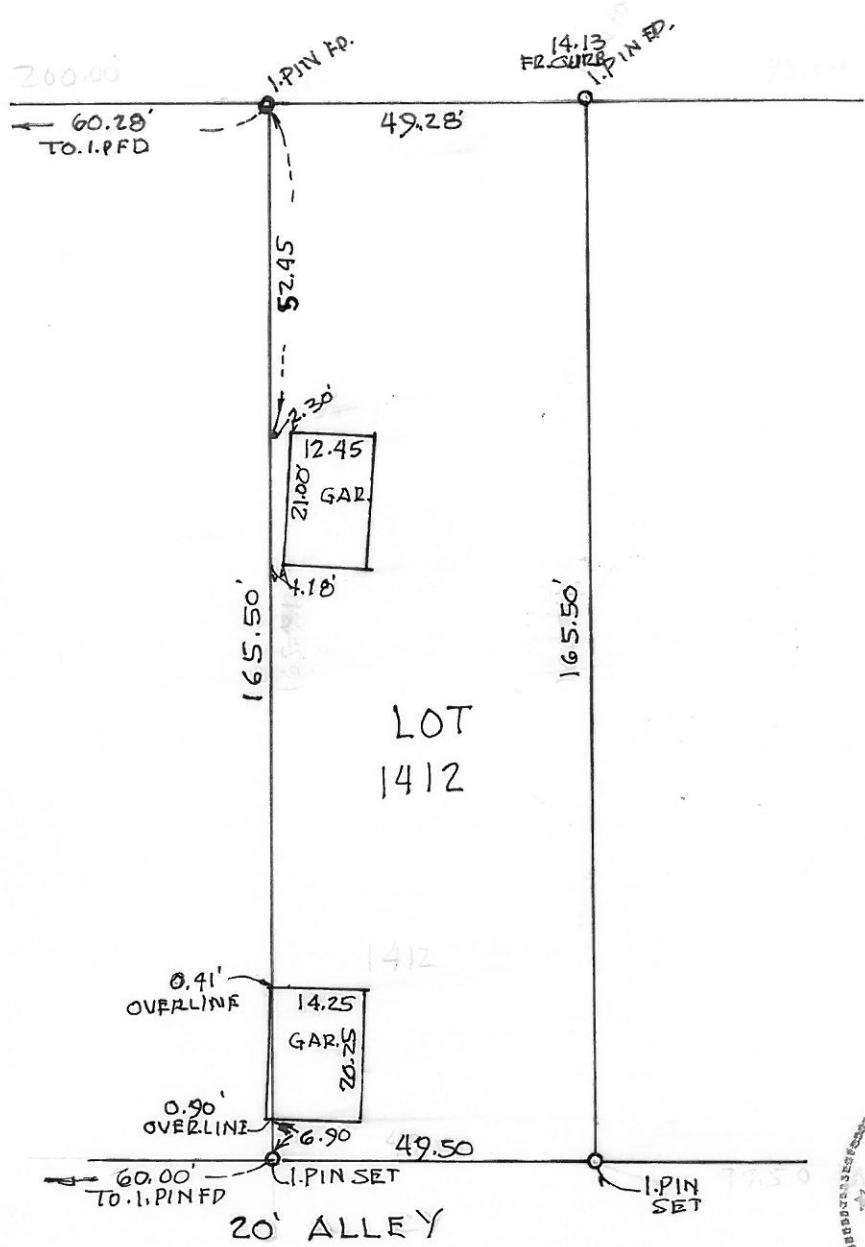