

# SURVEY OF PT LOT NO'S 5881 & 5882


MASSILLON, STARK, OHIO

FOR Mrs. Blaga

DATE 5-15-'54

BY H. M. PIPER - REGISTERED ENGINEER AND SURVEYOR

SCALE: 1" = 30'

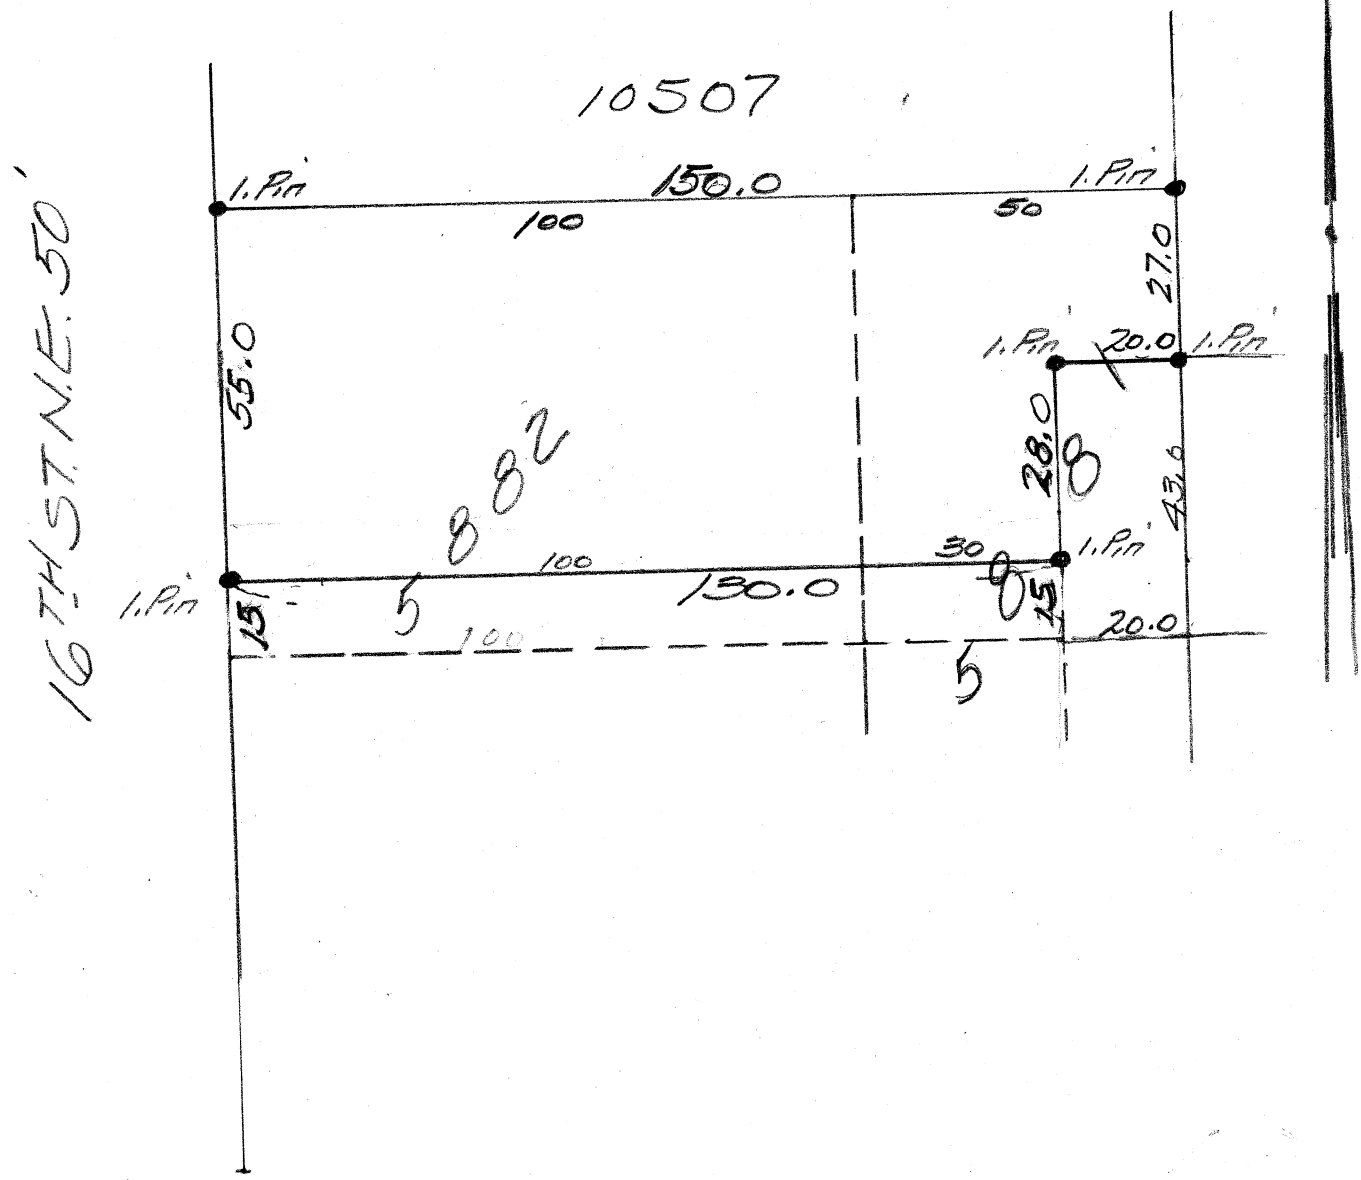

Description for Mrs. Blaga

Pt. Lot Nos. 5881 & 5882.

Known as and being a Pt. of Lot No's. 5881 and 5882 in the City of Massillon, Ohio, according to the present numbering of lots in said City and being more fully described as follows:

Beginning at an iron pin on the northwest corner of Lot No. 5882, said point being the true place of beginning of the parcel here-in conveyed; thence easterly 150.0 feet to the northeast corner of Lot No. 5881; thence southerly along the east line of Lot No. 5881 a distance of 27.0 feet to an iron pin; thence westerly parallel to the south line of Lot No. 5881 20.0 feet to an iron pin; thence southerly parallel to the east line of Lot No. 5881 ~~28.0~~ 28.0 feet to an iron pin; thence westerly parallel to the north line of Lot No's. 5882 and 5881 a distance of 130.0 feet to an iron pin on the west line of Lot No. 5882, also being on the east line of 16th St. N. E.; thence northerly along the east line of 16th St. N. E. ~~55.0~~ 55.0 feet to the place of beginning containing 0.185 acres of which 0.135 acres is a pt. of Lot No. 5882 and 0.05 is a part of Lot No. 5881.