


384

MASSILLON - OHIO

May 8 1937

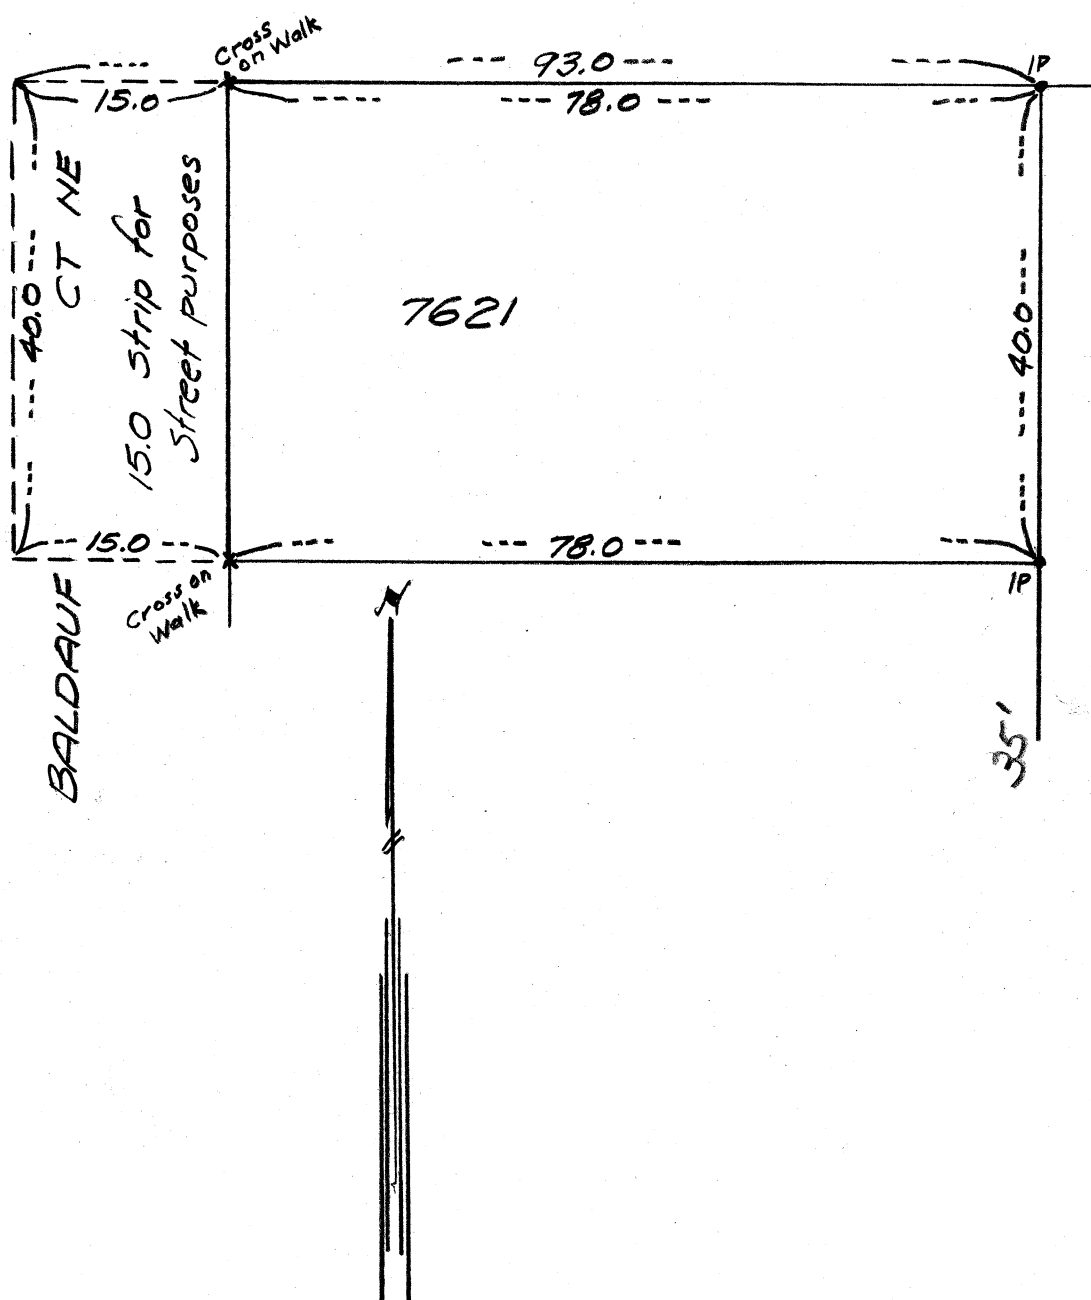


CITY OF
MASSILLON

DEPT. OF
ENGINEERING

LOCATION _____
SUBJECT _____
COMPUTED BY _____ DATE _____ CHECKED BY _____ DATE _____

JOB NO.

FILE NO.
273
SHEET NO.

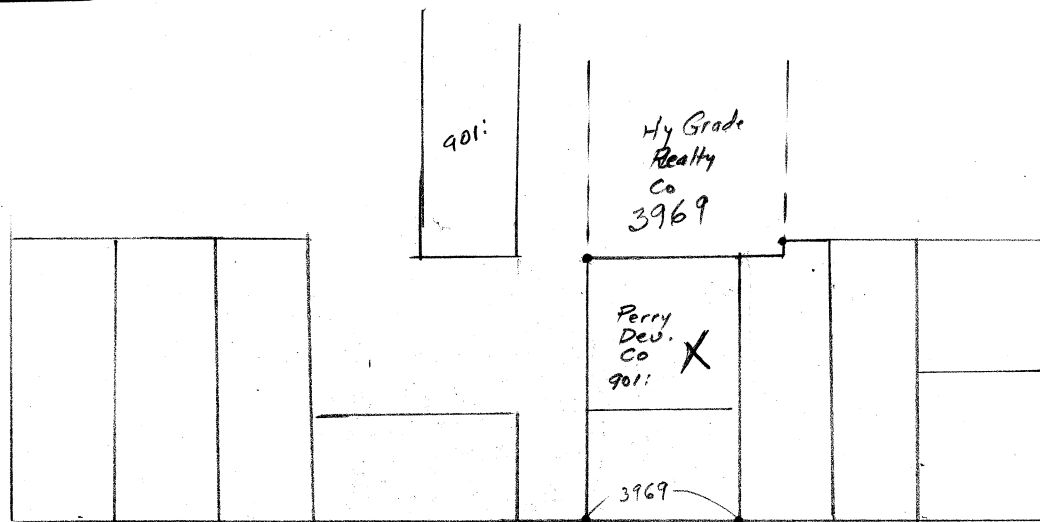

WILLARD AVE NE 40.4

901:462: being pt of lot 3969 des as follow
st. at the SE Cor of sd lot + proceeding Nly al the E -
of sd lot 35.3 ft to true pl. of Beg. th Nly 40 ft al
the E - of sd lot; th Wly 93 ft ~~to~~ to the N L of said
lot th Sely 40 ft = to w ~~to~~ of sd lot, th Ely 93 ft
to place of Beg. res. 15 ft off the west E of the henc
des. pre ~~to~~ the use of the public for driveway