


E

279

444

SURVEY OF LOT # 196
CITY OF MASSILLON
LINCOLN WAY WEST

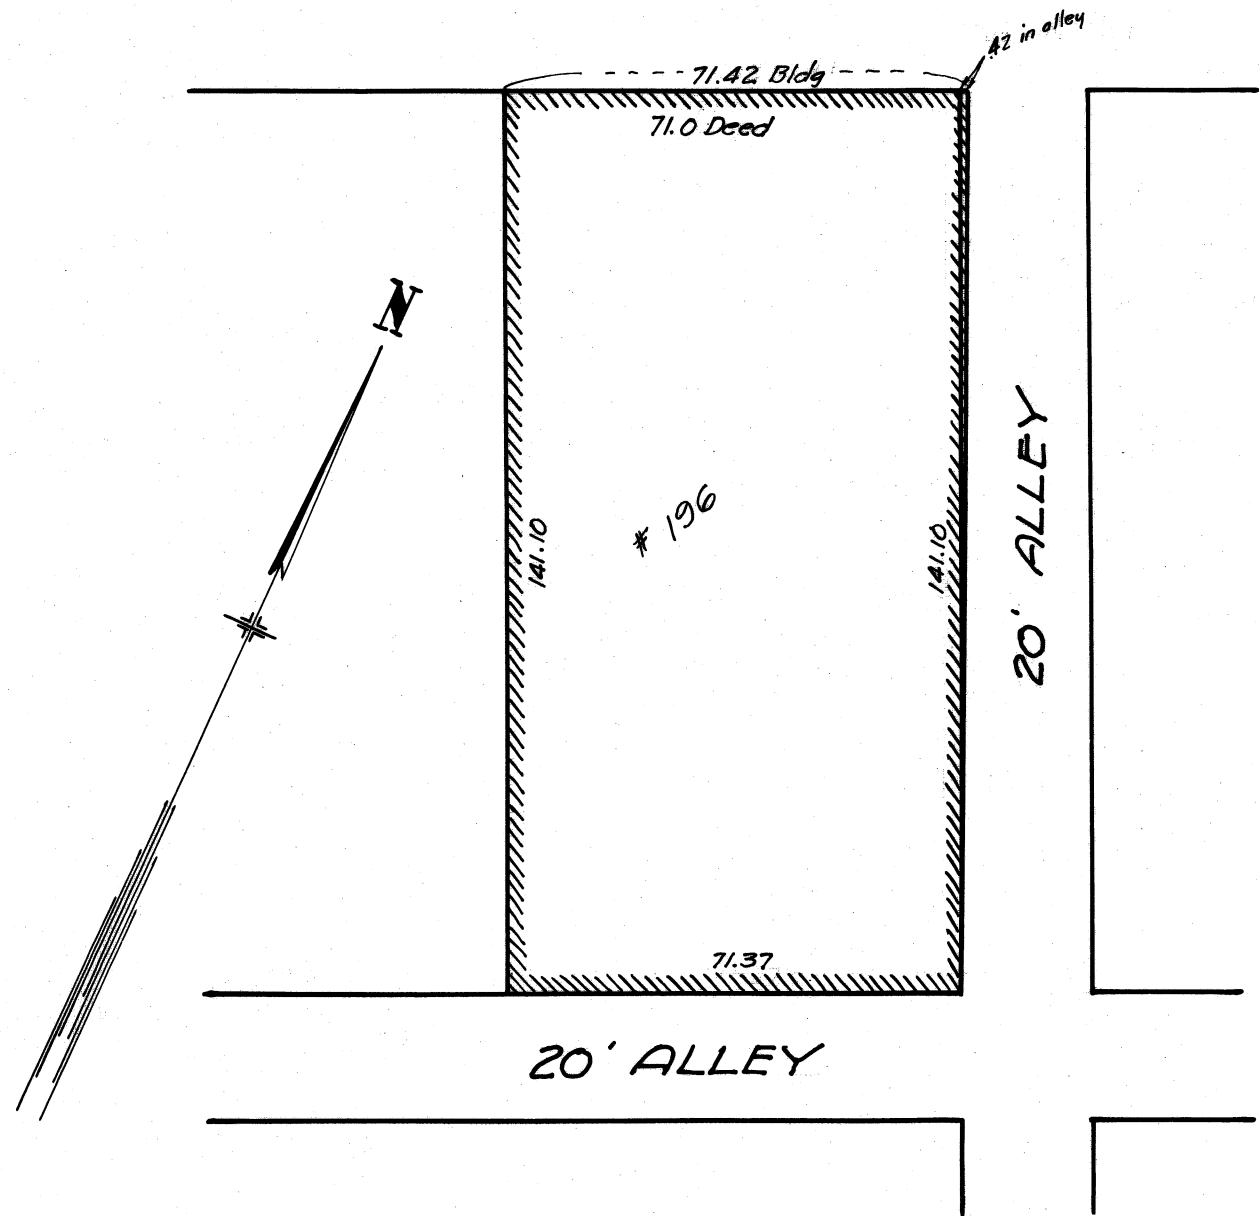

I hereby certify that the above is a true and correct plat of a survey made by me this 11th day of March 1931 - That the building has no encroachments except as shown.

Survey made for
1st Saving & Loan Co.

Geo. C. Wallace
Civil Engineer.

LINCOLN WAY W 100'

E

27

444

CROSS ON WALK
21' 50'

PLAT OF SURVEY FOR
HARRY HOWELLS OF LOT
76 & PT LOT 75 MASS O.

JULY 14 1928 SCALE 1"=20'
C.E. RICE C.E.

PT LOT ~~75~~
196

LOT ~~76~~
196

140' (DEED) 141.1' MEASURED

ALLEY 20'

IRON PIN SET
MEASURES 71.37'
21' DEED 50' DEED

DIAMOND CT. S. W.

20'