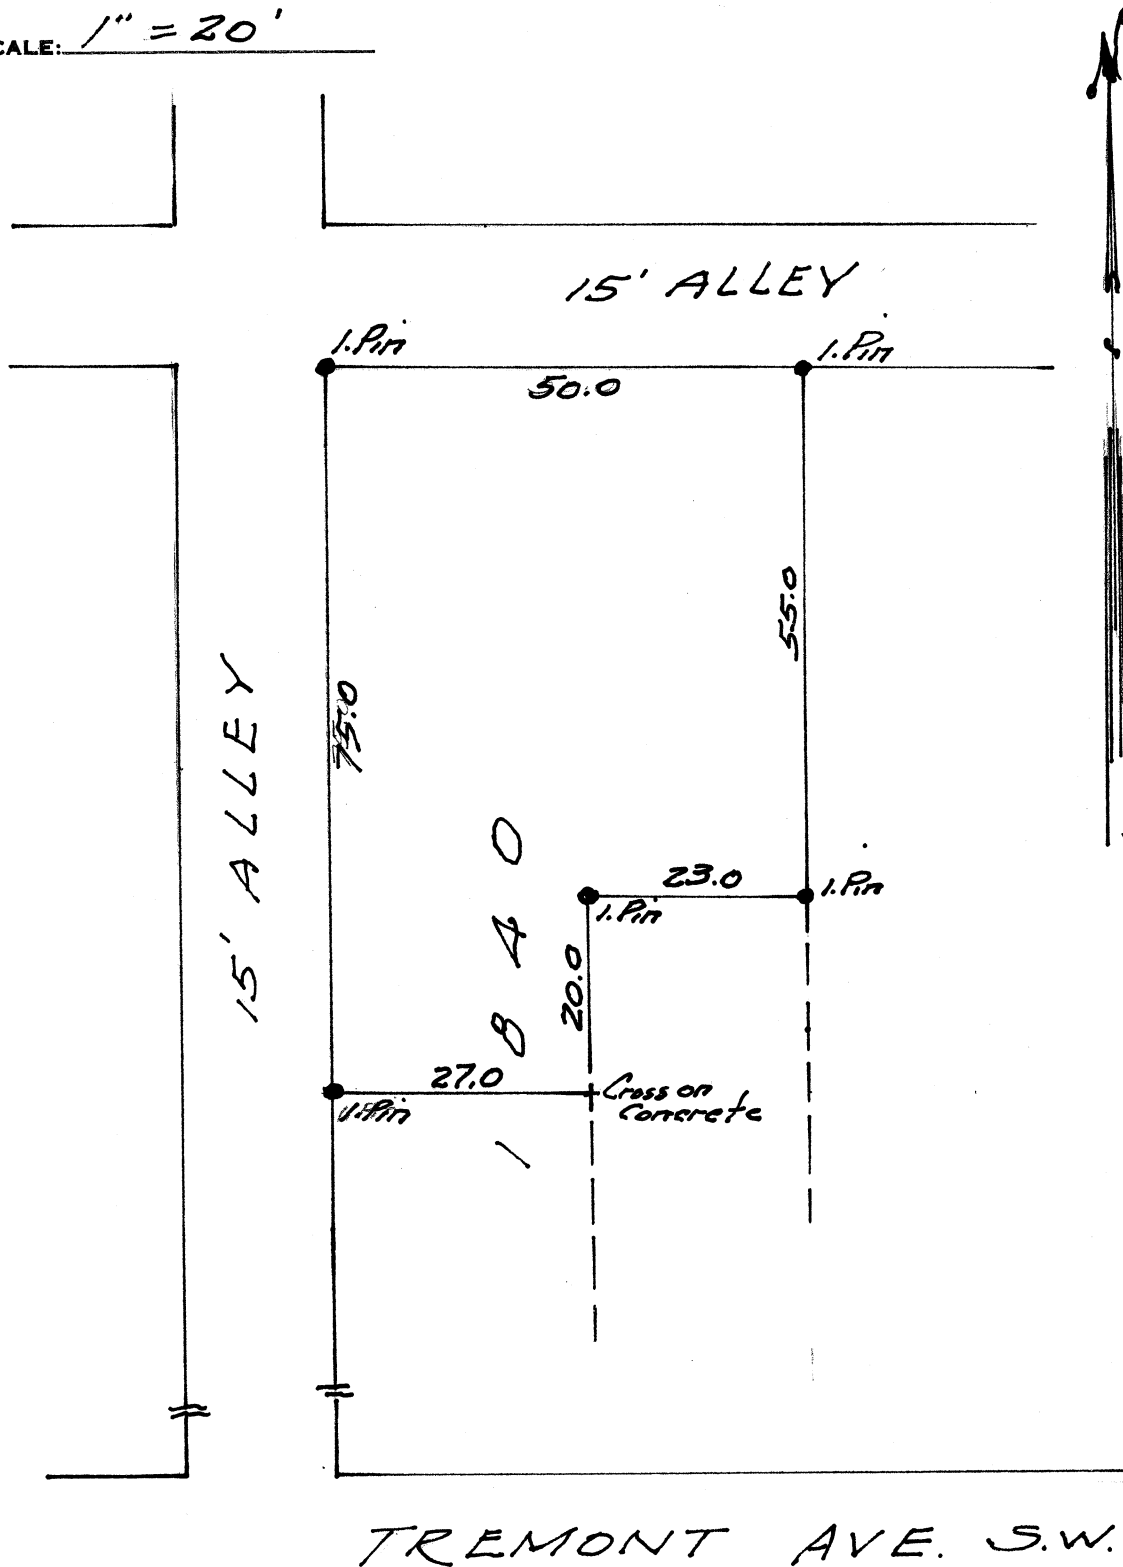


SURVEY OF PT. LOT NO. 1840

MASSILLON, STARK, OHIO

FOR Elson WeflerDATE 3-23-61

BY H. M. PIPER - REGISTERED ENGINEER AND SURVEYOR

SCALE: 1" = 20'

Description of Pt. Lot No. 1840

Massillon, Ohio

Known as and being a Part of Lot No. 1840 in the City of Massillon, Ohio, according to the present numbering of lots in said City and being more fully described as follows:

Beginning at the true place of beginning of the tract here-in described, said point being the Northwest corner of Lot No. 1840; thence easterly along the North line of said Lot 50.0 feet to an iron pin on the Northeast corner of said Lot; thence southerly 55.0 feet along the East line of said Lot to an iron pin; thence westerly parallel to the North line of Lot No. 1840 a distance of 23.0 feet to an iron pin; thence southerly parallel to the West line of said Lot 20.0 feet to a cross cut in concrete; thence westerly 27.0 feet parallel to the North line of said Lot to an iron pin on the West line of Lot No. 1840; thence northerly along the West line of said Lot 75.0 feet to the place of beginning containing 0.075 acres.




279
GEO. C. WALLACE
103 WOODLAND AVE. S. E.
PHONE 4654

RICE & WALLACE
REGISTERED CIVIL AND MINING ENGINEERS
SURVEYORS
MASSILLON, OHIO

SURVEY OF PT. LOT NO. 1840
MASSILLON, O.
FOR BYRON GILTZ
9/11/43

483

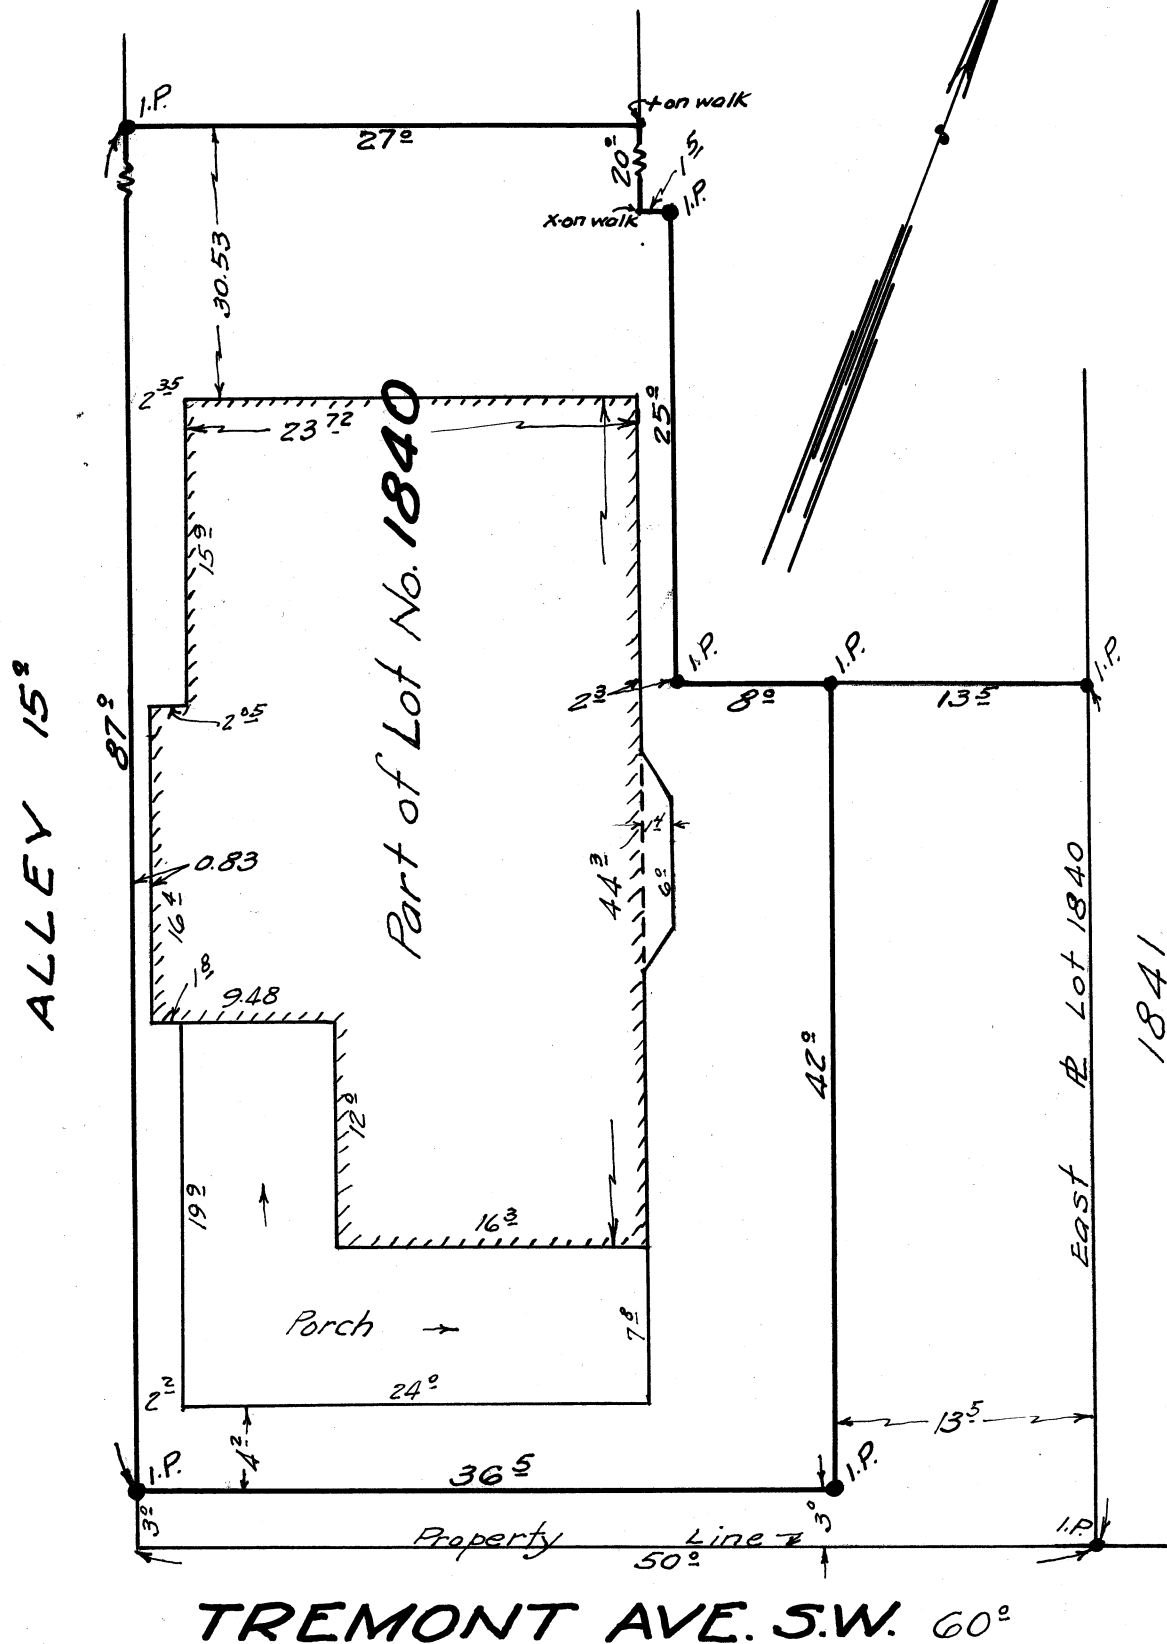

1841

Deed description for Mr. Giltz.

9-13 1943.


Being part of lot No 1840 in the city of Massillon, Stark county state of Ohio described as follows: "beginning at an iron pin in the west line of lot No 1840 said pin being three (3) feet north of the south west corner of lot No 1840; thence northerly along the west line of lot No 1840 eighty seven (87) feet to an iron pin; thence easterly on a line parallel to the south line of lot No. 1840 twenty seven (27) feet to a cross in a concrete walk; thence southerly on a line parallel to the west line of lot No 1840 twenty (20) feet to a cross in a concrete walk; thence easterly on a line parallel to the south line of lot No 1840 one and five tenths (1.5) feet to an iron pin; thence southerly on a line parallel to the west line of lot No 1840 twenty five (25) feet to an iron pin; thence easterly on a line parallel to the south line of lot No 1840 eight (8) feet to an iron pin; thence southerly on a line parallel to the west line of lot No 1840 forty two (42) feet to an iron pin which point is also three (3) feet north of the south line of lot No 1840; thence west~~erly~~ on a line parallel to the south line of lot N o 1840 thirty ~~five~~ and six and five tenths (36.5) feet to the place of beginning containing sixty four thousandths (0.064) acres.

GEO. C. WALLACE
103 WOODLAND AVE. S. E.
PHONE 4654

279

**REGISTERED CIVIL AND MINING ENGINEERS
SURVEYORS**

MASSILLON, OHIO
SURVEYED 12-30-41

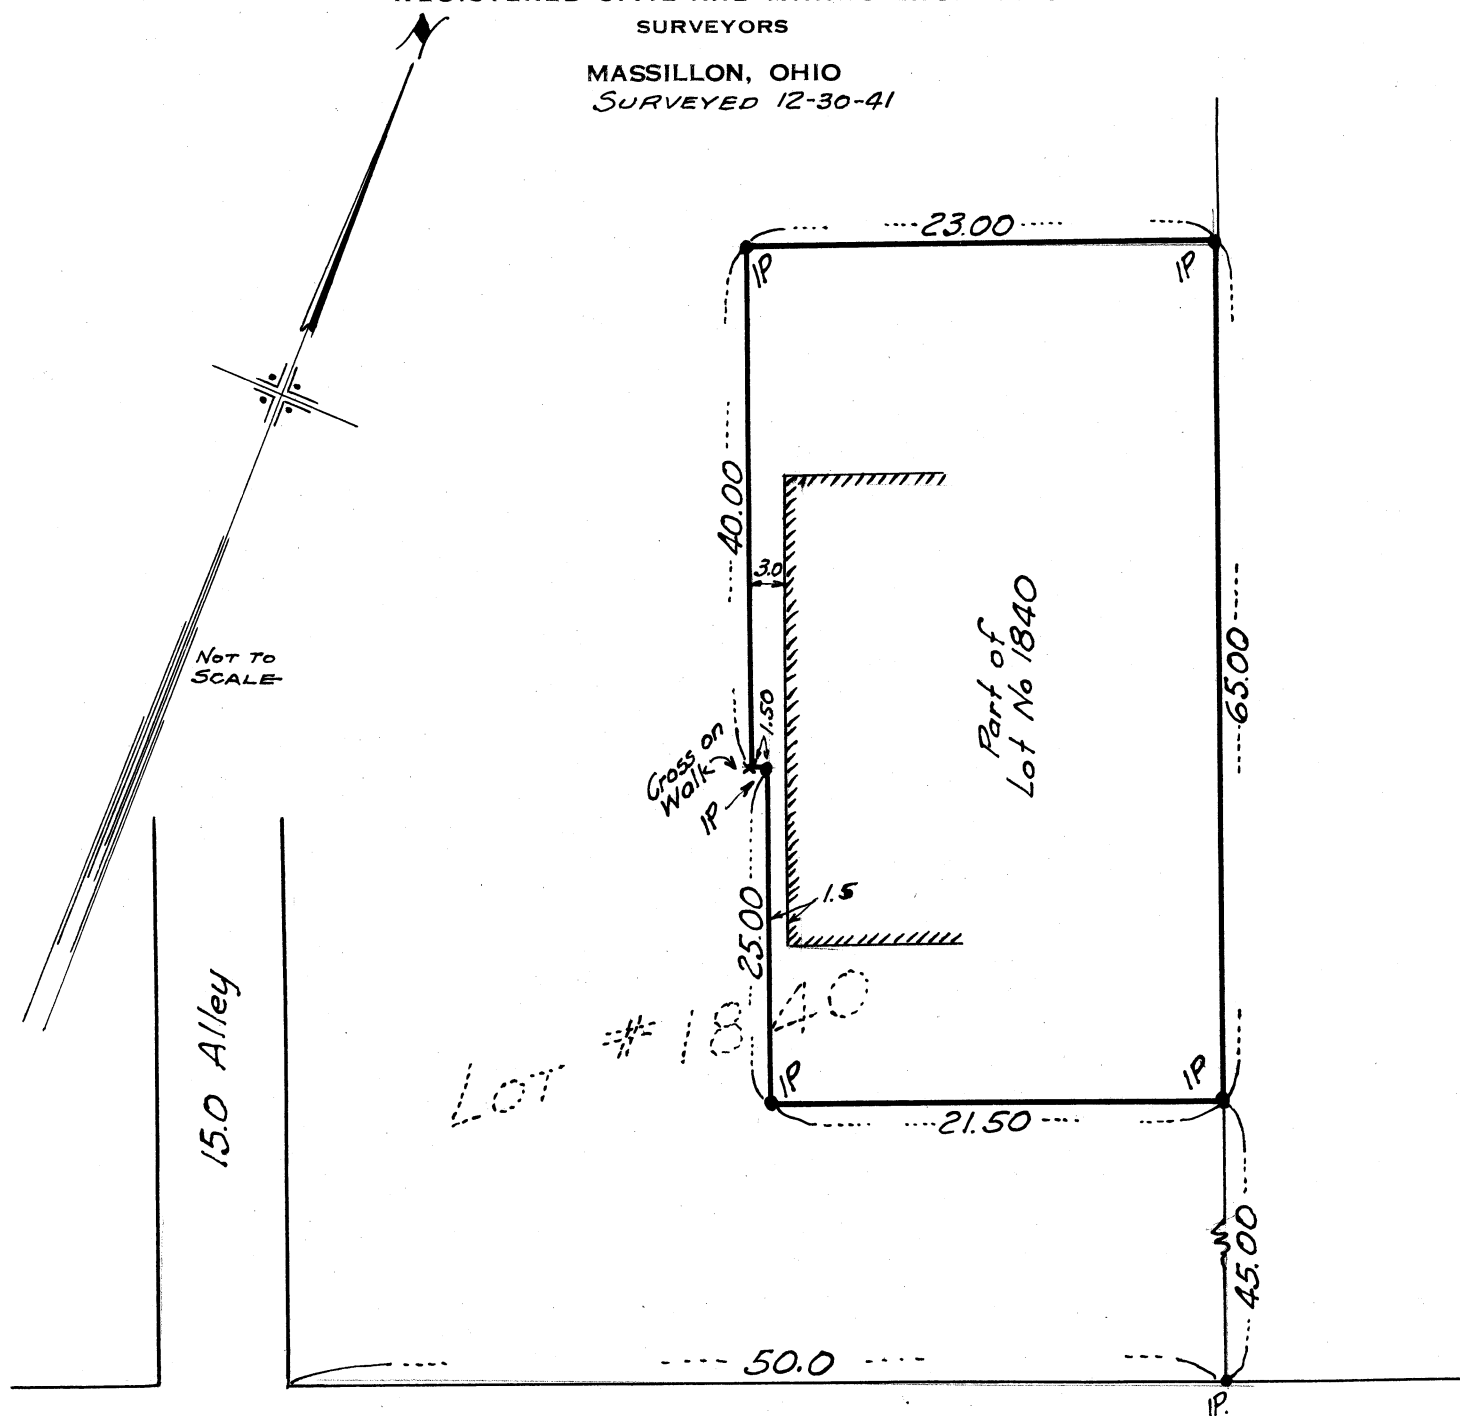

TREMONT AVE., SW.