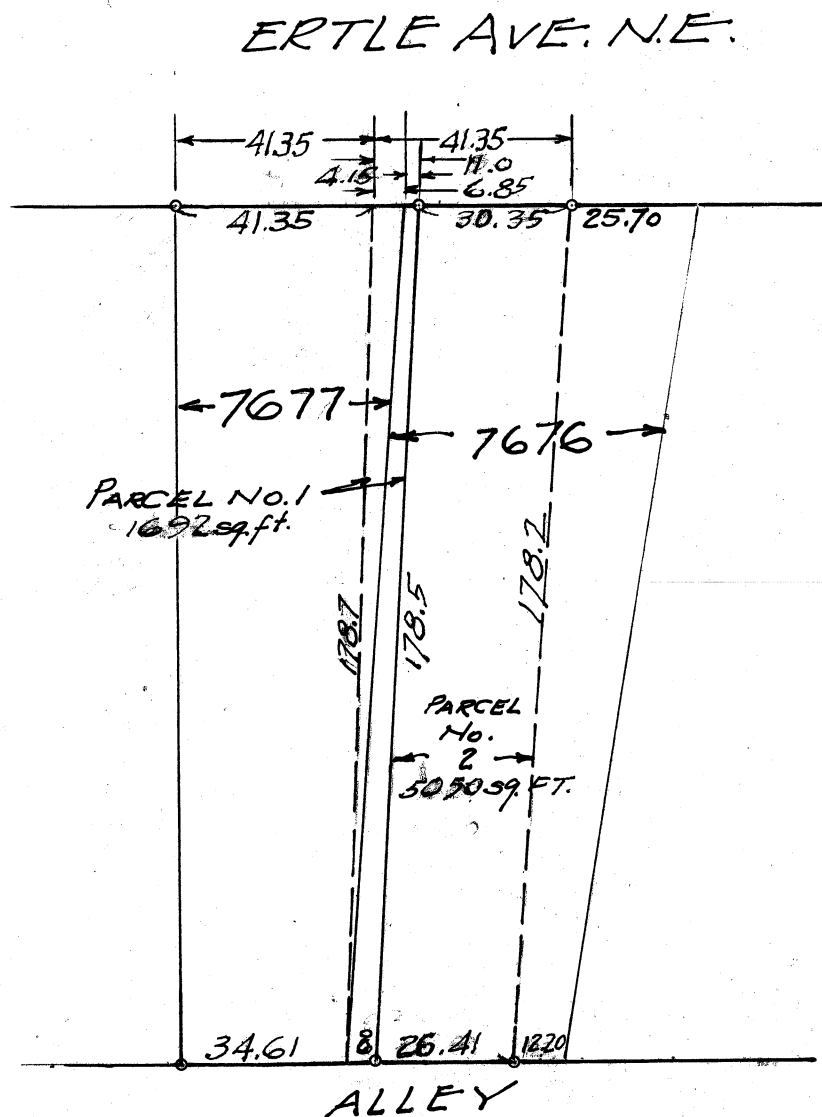


SURVEY OF PART LOT NOS. 7676 & 7677

MASSILLON, STARK, OHIO

FOR Sherlock EvansDATE 10-27-55

BY H. M. PIPER - REGISTERED ENGINEER AND SURVEYOR

SCALE: 1" = 40'

PARCEL NO. 1

Known as and being a Part of Lot No's. 7677 and 7676 in the City of
Massillon, Ohio, according to the present numbering of Lots in said City and
being more fully described as follows:

Beginning at a point on the north line of Lot No. 7677 6.85 feet west of the north east corner of Lot No. 7677, said point being the true place of beginning of the parcel here-in described; thence easterly along the north line of Lot No's. 7677 and 7676 ^{11.0}~~6.0~~ feet to an iron pin; thence southerly 178.5 feet to an iron pin on the south line of Lot No. 7676, said point being ^{8.0}~~6.0~~ feet east of the southwest corner of Lot No. 7676; thence westerly along the south line of Lot No. 7676, also being the north line of a public alley, ^{8.0}~~6.0~~ feet to the southwest corner of said Lot; thence 178.70 feet to the place of beginning containing ~~100~~ square feet.

1692

PARCEL NO. 2

Known as and being a Part of Lot No. 7676 in the City of Massillon, Ohio,
according to the present numbering of Lots in said City and being more fully
described as follows:

[illegible]

5050