

LINCOLN WAY EAST 100.0

U.S. ROUTE NO. 30


Center Line

Brick Pavement (old car tracks) Conc. Base
Surface treated with Asphalt.

18" San. Sewer Approx 100 deep

6" lateral for Long and Pietycker, laid Dec. 1928
when building was built. Permit #3108.

Asphalt Pavement

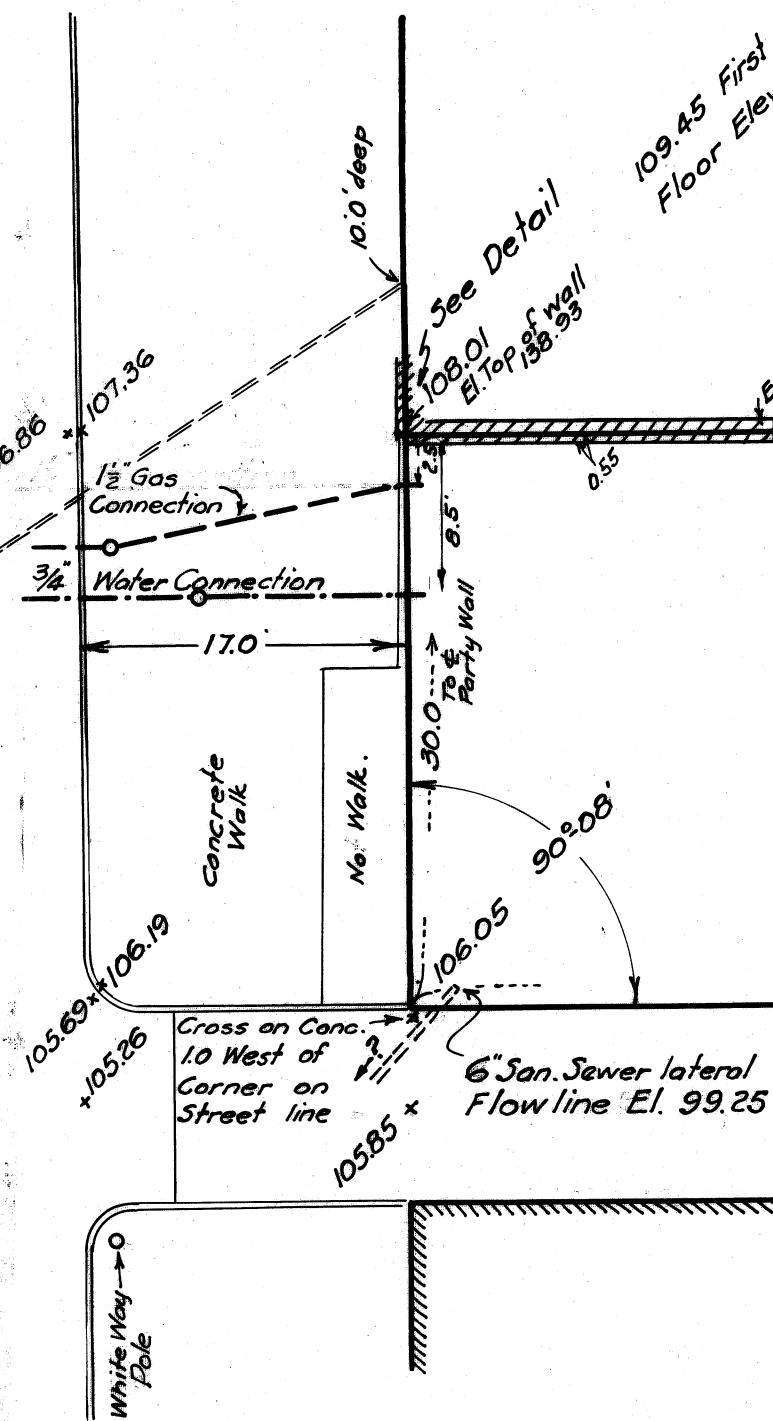

105.70 First Floor Elev.

**SURVEY OF LOT NO. 260
IN THE CITY OF MASSILLON, OHIO.**

By Rice & Wallace, Massillon Ohio
Reg. Eng. & Surveyors


March 1942

Scale 1" = 10 FT

Datum: City of Massillon datum used for elevations. B.M. highest point
on Hydrant #79, corner Conrad Place NE & Lincoln Way E., Elev. 104.74

East Ohio Gas Co. recommends a 2" line, they will
furnish service to curb line, property owner pays
from curb line to property line.

DETAIL OF NE
CORNER OF LOT

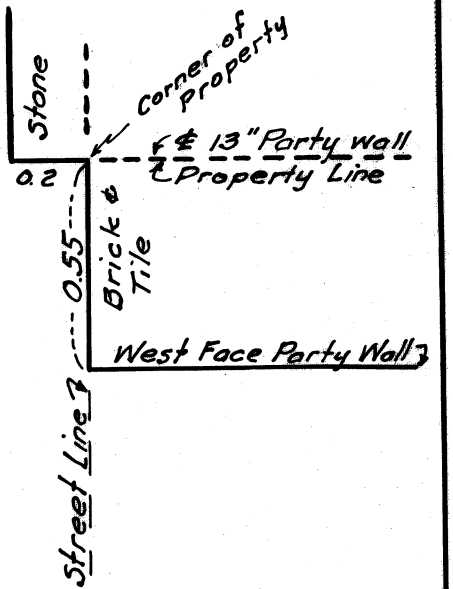

DIAMOND CT. SE. 20.0

Brick Pavement Gravel Base