

SURVEY OF ~~S~~ SPLIT LOT NO. 375


MASSILLON, STARK, OHIO

FOR CARL OSER

DATE 12-28-56

BY H. M. PIPER - REGISTERED ENGINEER AND SURVEYOR

SCALE: 1" = 30'

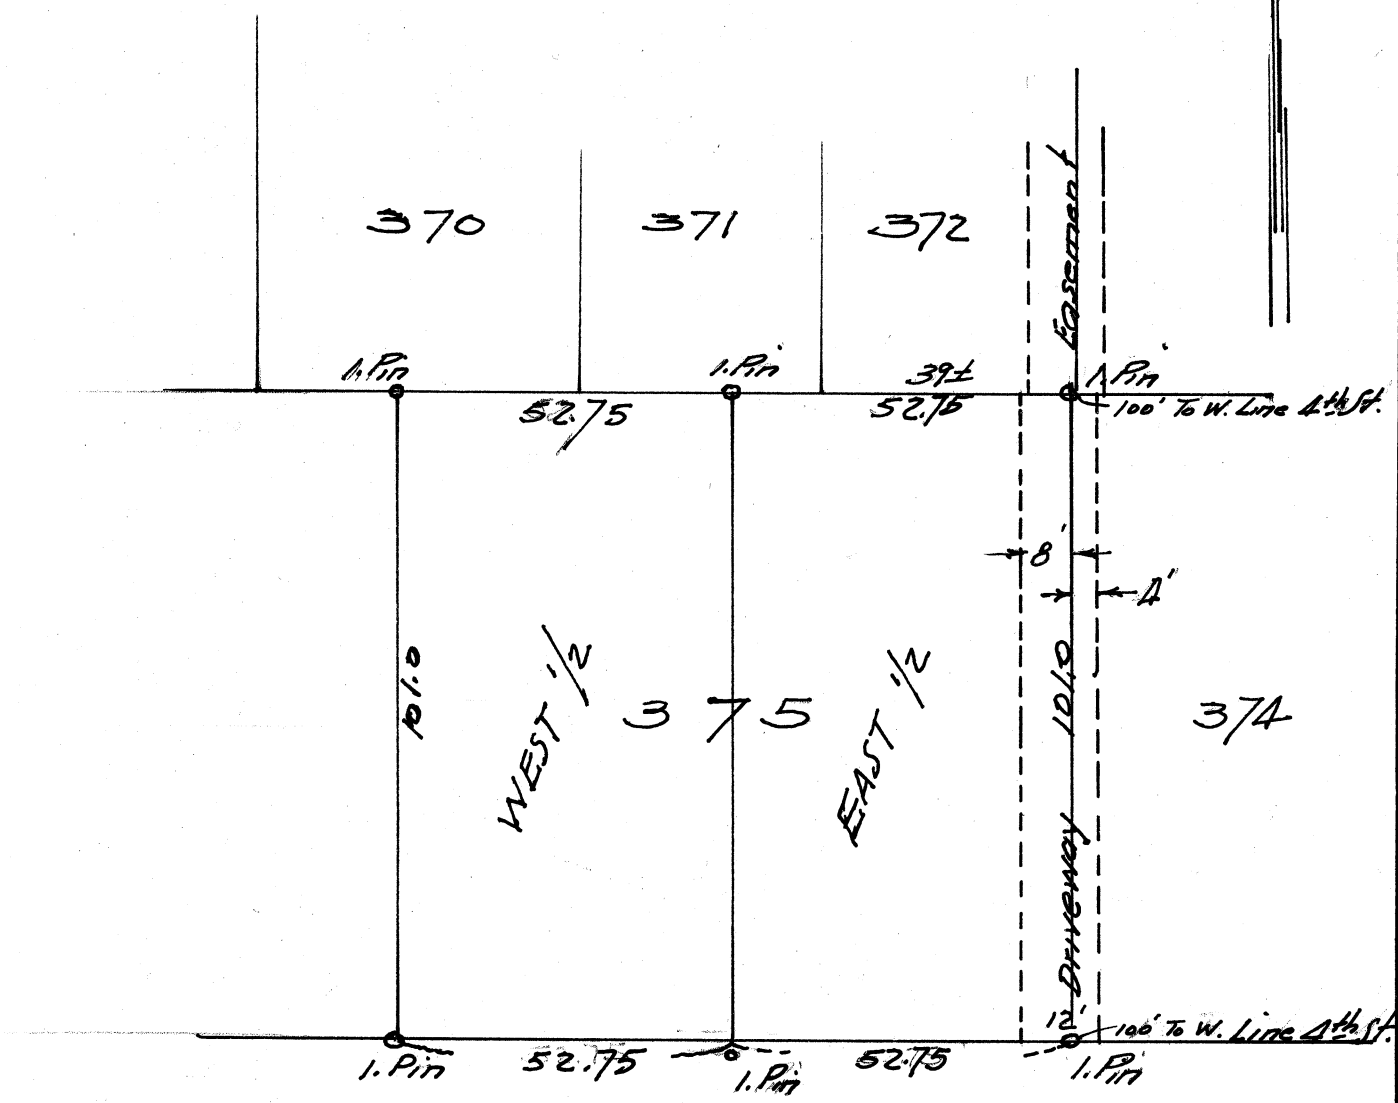

FEDERAL AVE. N.E. 66"

22

FOR J.A. SHADNAGLE JR. & CHAS. PAQUELET


DATE MAY 1963

R. F. WAGONER

BY ~~THE ENGINEER~~ - REGISTERED ~~ENGINEER~~ SURVEYOR

SCALE: 1" = 30'



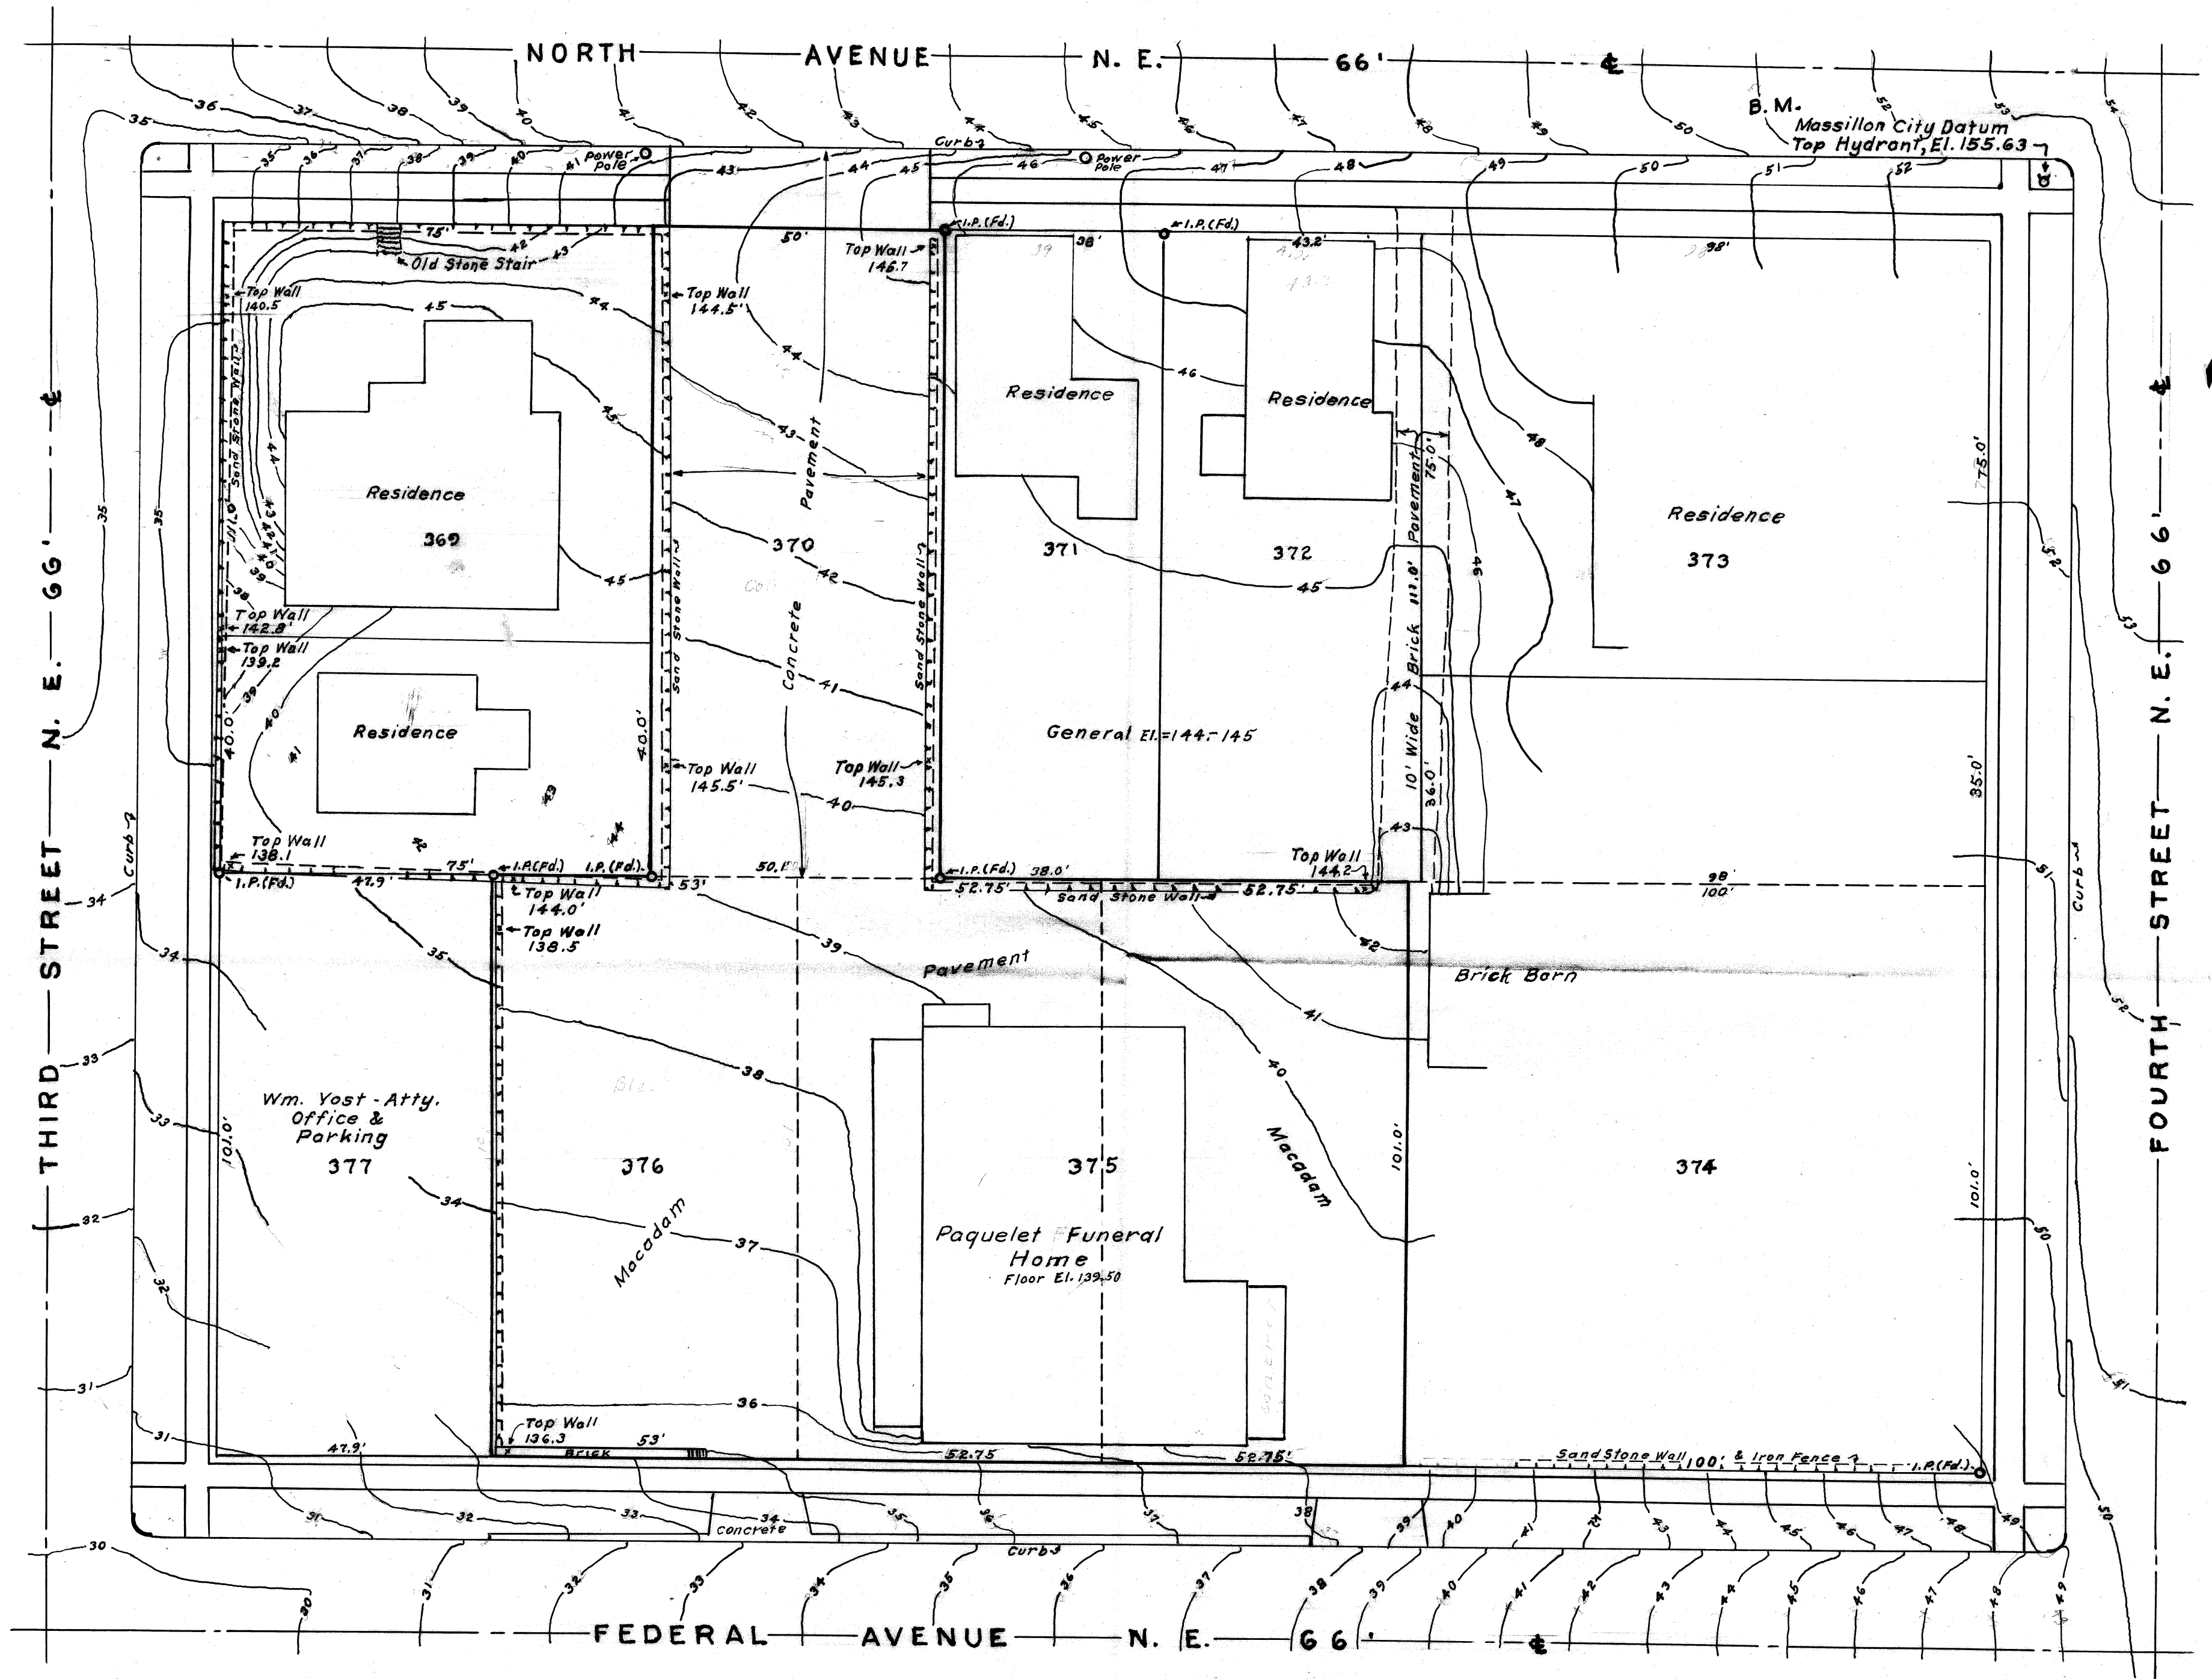

Note:-
 Utilities are available but records in
 this older section of the City are undependable.
 Suggest probe in area for necessary facilities
 at time of design.

**TOPOGRAPHY SURVEY OF
 PAQUELET FUNERAL HOME BLOCK
 EAST OF THIRD STREET & NORTH OF
 FEDERAL AVENUE N. E.
 MASSILLON, OHIO.**

Scale: 1 inch = 20 Feet.
 Dr. By: M. J. Alter June 15, 1973.