

SURVEY OF LOT 138, PINE HILLS ALLOT. NO.2, PT. N.W. QR. SECT.15, PERRY TWP.


~~XXXXXXXXXX~~, STARK, OHIO

FOR DEVILLE LUMBER

DATE DEC. 10, 1962

BY D. F. WAGONER - REGISTERED ~~ENGINEER~~ SURVEYOR

SCALE: 1" = 30'

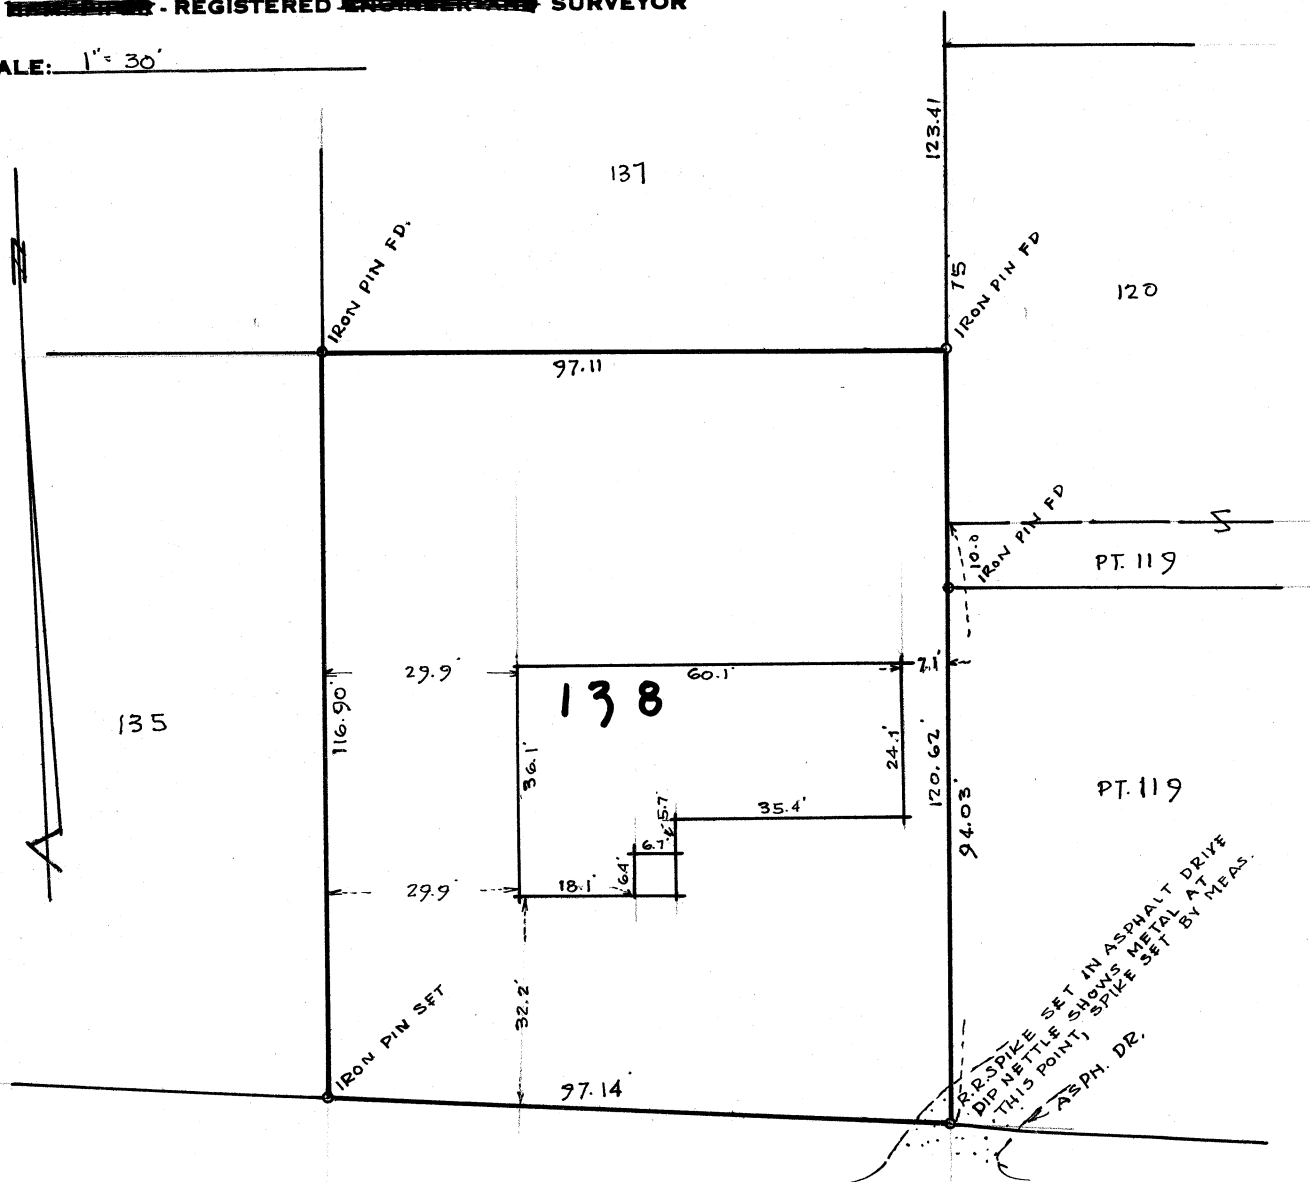

~~BUCKWALTER DR. S.W. 50°~~

I HEREBY CERTIFY THE ABOVE SURVEY WAS MADE BY ME, THERE ARE NO ENCR OACHMENTS BY ADJACENT BUILDINGS ON TO LOT NO.138 OR THERE ARE NO ENCR OACHMENTS BY BUILDINGS ON LOT NO.138 ONTO ADJACENT PROPERTIES.

Robert L. Weagure
REGISTERED SURVEYOR NO. 4787

AA

C. E. RICE
758 AMHERST RD. N. E.
PHONE 3450

285
GEO. C. WALLACE
103 WOODLAND AVE. S. E.
PHONE 4654

NE

242

RICE & WALLACE
REGISTERED CIVIL AND MINING ENGINEERS
SURVEYORS

MASSILLON, OHIO
SURVEY OF LOTS #137, #138
IN THE CITY OF MASSILLON, OHIO
BY RICE & WALLACE ON DEC. 3, 1938

NE.
3RD ST. DE. 66°

