

**SURVEY OF** PT. LOT NOS. 11183-11184 & PT. N.W. 1/4 Sec. 5 Perry Twp.  
in NORMANDY ALLOT.


**MASSILLON, STARK, OHIO**

FOR R. Richards

DATE 1-20-58

**BY H. M. PIPER - REGISTERED ENGINEER AND SURVEYOR**

**SCALE:** 1" = 50'

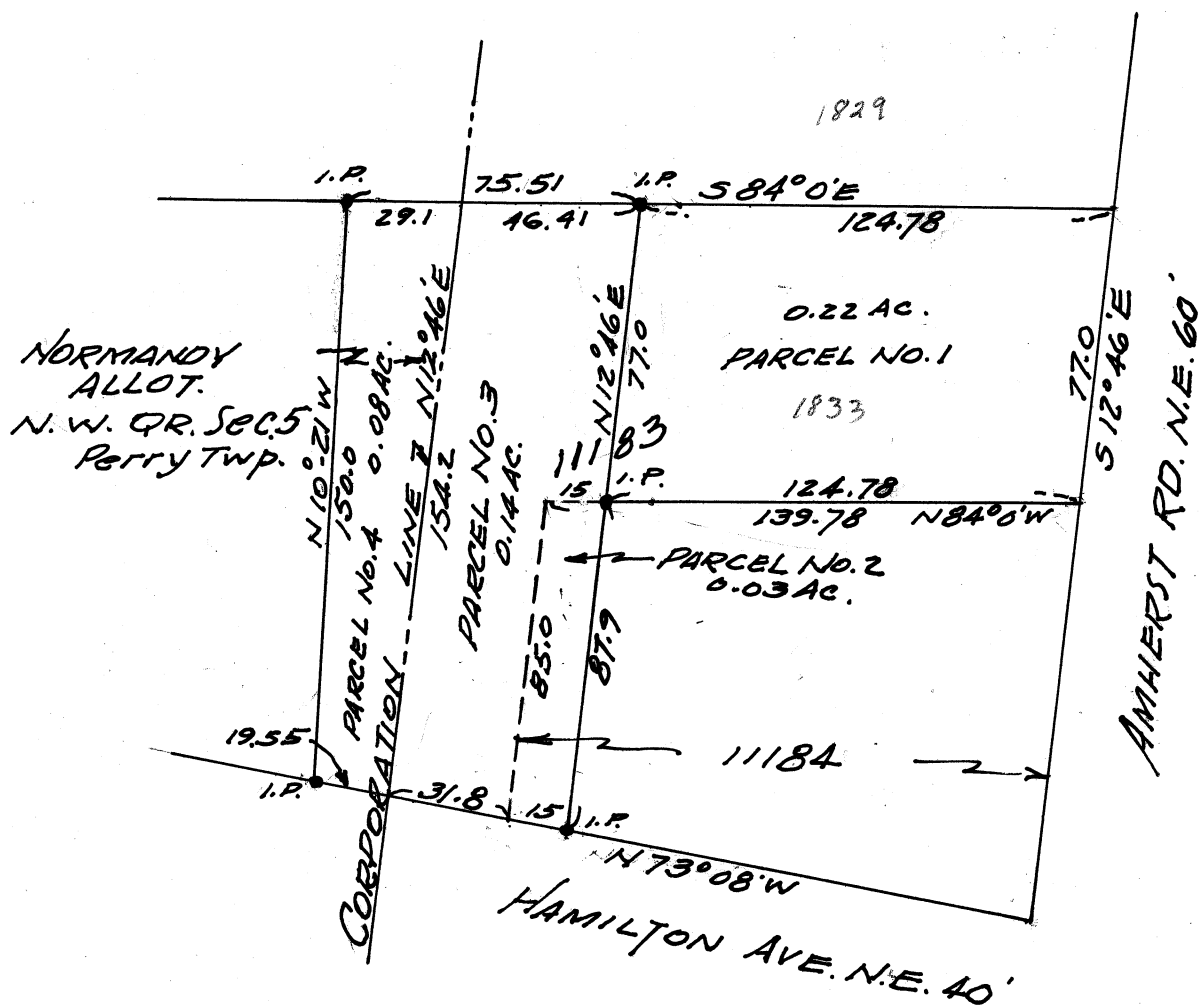

Parcel No. 1 (Part of Lot No. 11183)

Known as and being a Part of Lot No. 11183 in the City of Massillon, Ohio, according to the present numbering of Lots in said City and being more fully described as follows:

Beginning at an iron pin on the northeast corner of Lot No. 11183, said point being on the west line of Amherst Road N. E. and the true place of beginning of the parcel here-in described; thence S  $12^{\circ} 46'$  W along the west line of Amherst Road 77.0 feet to the northeast corner of Lot No. 11184; thence N  $84^{\circ} 0'$  W 124.78 feet along the north line of Lot No. 11184 to an iron pin 15.0 feet from the northwest corner of Lot No. 11184; thence N  $12^{\circ} 46'$  E 77.0 feet to an iron pin on the north line of Lot No. 11183; thence S  $84^{\circ} 0'$  E along the north line of Lot No. 11183 124.78 feet to the place of beginning containing 0.22 acres.

Description for Part of Lot Nos. 11183,

11184 and Pt. N. W. Qr. Sec. 5 Perry Twp. in Normandy Allot.

for R. Richards

Known as and being a Part of Lot No's. 11183, 11184 and a Part of  
*Normandy*  
~~Hamilton~~ Allotment No. 1 located in the Northwest Quarter of Section 5  
Perry Township, Stark County, Ohio, said parcels being more fully des-  
cribed as follows:

PARCEL NO. 2: (Part of Lot No. 11184 in City of Massillon, Ohio)

Beginning at the true place of beginning of the parcel here-in  
described, said point being an iron pin on the southwest corner of Lot  
No. 11184; thence N 12° 46' E along the west line of Lot No. 11184 a  
distance of 85.0 feet to an iron pin on the northwest corner of said Lot;  
thence S 84° 0' E along the north line of said lot a distance of 15.0  
feet to an iron pin; thence S 12° 46' W a distance of 87.9 feet to an  
iron pin on the north line of Hamilton Ave. N. E.; thence N 73° 08' W  
along the north line of Hamilton Ave. N. E. a distance of 15.0 feet to the  
place of beginning containing 1290 square feet or 0.03 Acres.

PARCEL NO. 3: (Part of Lot No. 11183)

Beginning at the northwest corner of Lot No. 11183, said point  
being on the Corporation line of the City of Massillon, Ohio, and the  
true place of beginning of the parcel here-in described; thence S 84° 0' E  
along the north line of said Lot 46.41 feet to an iron pin 124.78 feet  
from the northeast corner of said Lot; thence S 12° 46' W parallel to the  
west line of Amherst Rd. N. E. a distance of 77.0 feet to an iron pin on  
the north line of Lot No. 11184; thence N 84° 0' W along the north line  
of Lot No. 11184 15.0 feet to an iron pin on the northwest corner of Lot  
No. 11184; thence S 12° 46' W along the west line of Lot No. 11184 85.0  
feet to an iron pin on the southwest corner of said Lot No. 11184; said  
point being on the north line of Hamilton Ave. N. E.; thence N 73° 08' W

(Parcel No. 3 continued)

31.80  
along the north line of Hamilton Ave. N. E. ~~16.80~~ feet to the southwest corner of Lot No. 11183, said point also being on the Corporation line; thence N 12° 46' E 154.2 feet along the Corporation line, also being the west line of Lot No. 11183, to the place of beginning containing 0.14 acres.

*Normandy*  
PARCEL NO. 4 (Part of ~~Hamilton~~ Allotment in N. W. Qr. Sec. 5, Perry Twp.)

Beginning at the northwest corner of Lot No. 11183 said point being on the Corporation line and being the true place of beginning of the parcel here-in described; thence S 12° 46' W along the west line of Lot No. 11183 and the Corporation line 154.2 feet to the southwest corner of Lot No. 11183 on the north line of Hamilton Ave. N. E.; thence N 73° 08' W along the north line of Hamilton Ave. N. E. 19.55 feet to an iron pin; thence N 10° 21' E 150.0 feet to an iron pin; thence S 84° 0' E 29.1 feet to the place of beginning containing 0.08 acres.