


877

FOR EARL RUETZ

DATE 9-6-61

R.F. WAGONER
BY ~~IN THE FIELD~~ - REGISTERED ~~ENGINEER~~ SURVEYOR

SCALE: 1"=30'

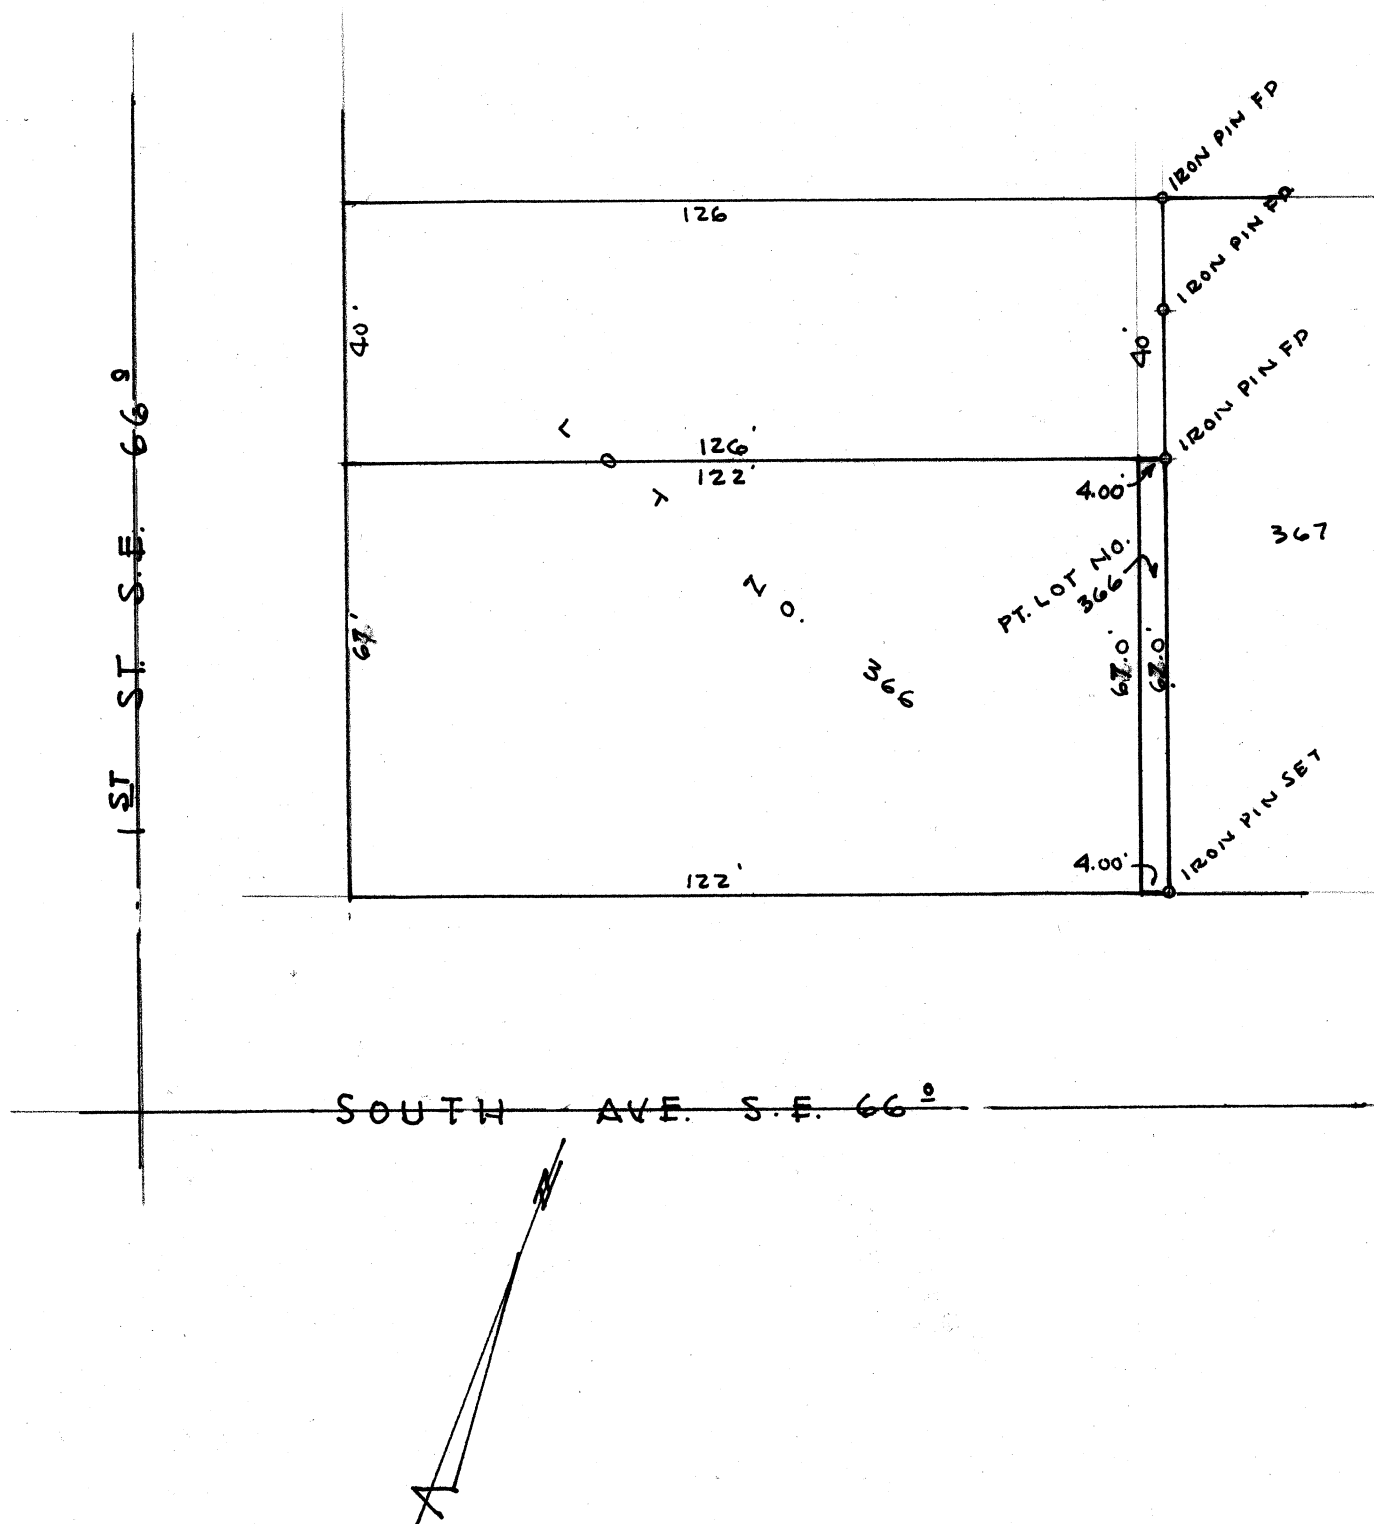

SURVEY OF LOT NO. 366 (PT.) SW


MASSILLON, STARK, OHIO

FOR H. Mallalieu

DATE 5-16-50

BY H. M. PIPER — REGISTERED ENGINEER AND SURVEYOR

SCALE: 1" = 20 FT.

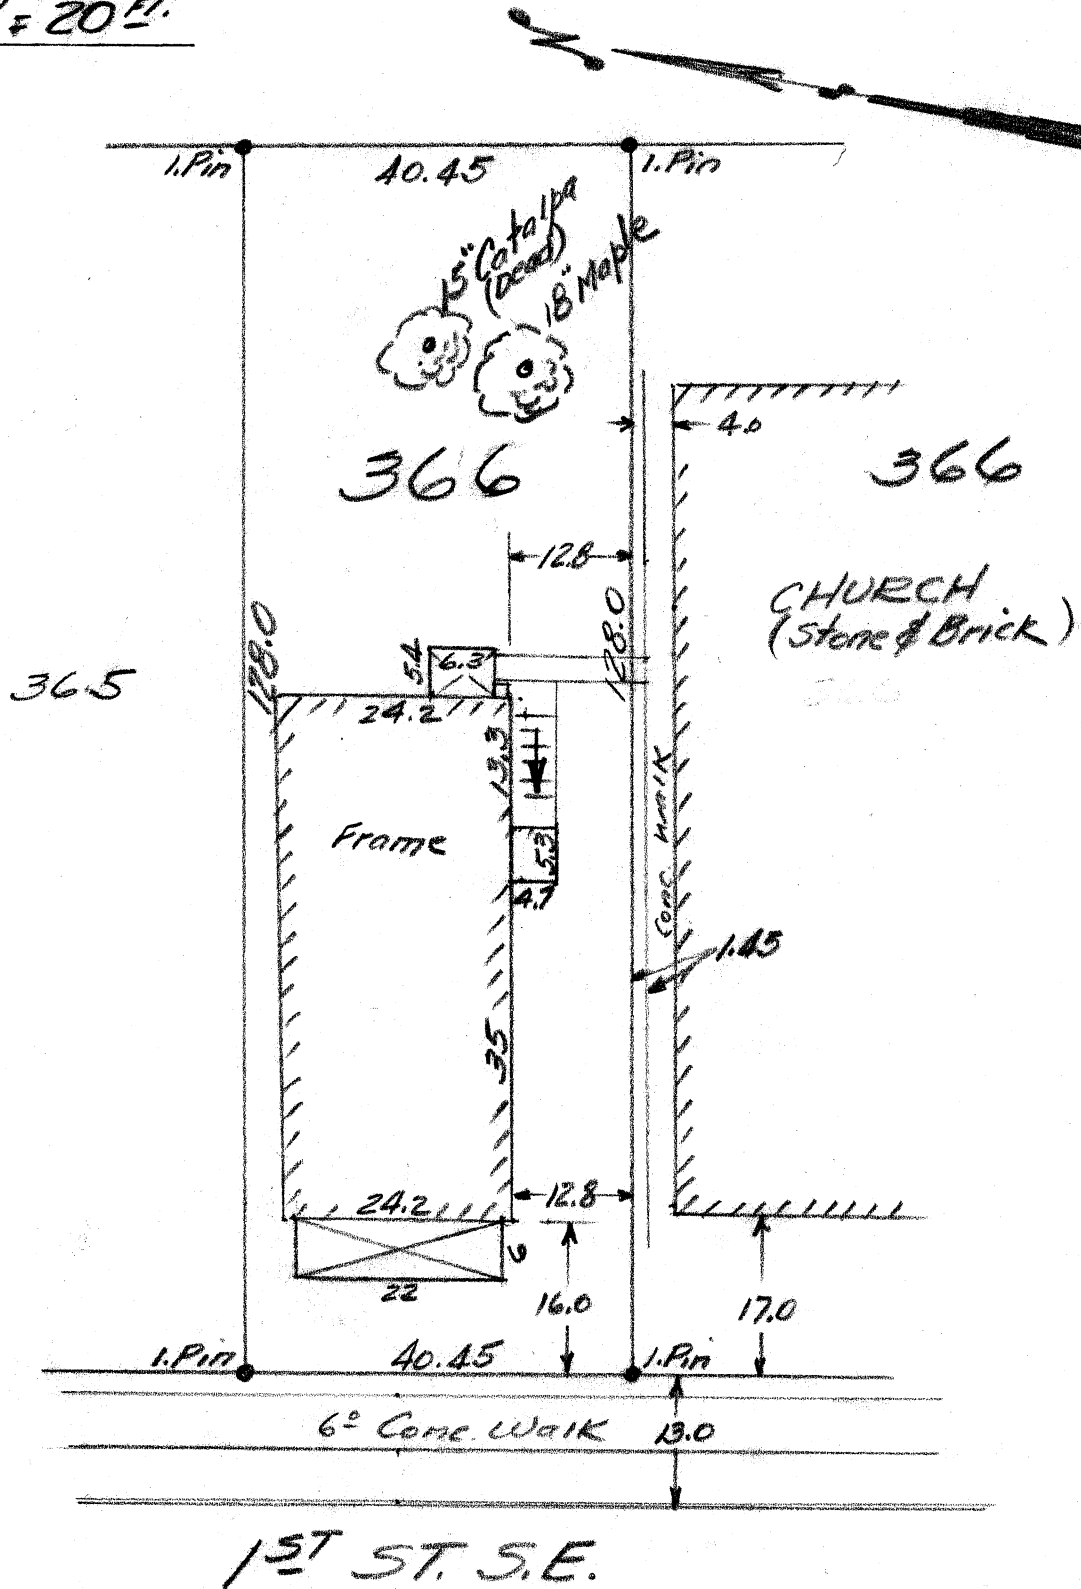

Part Lot No. 366

Massillon, Stark County, Ohio

For Earl Ruets

Known as and being part of Lot No. 366 in the City of Massillon,
Stark County, Ohio and being more fully described as follows:

Beginning at an iron pin at the Southeast corner of Lot No. 366
in said City, said point being the true place of beginning of the tract
herein described; thence Westerly along the South line of said Lot No. 366
4.00' to a point; thence Northerly and parallel to the East line of said
Lot, 67.0' to a point; thence Easterly along the North line of said Lot,
4.00' to an existing iron pin; thence Southerly along the East line of
said Lot 366, 67.0' to the true place of beginning containing 268' square
feet.