

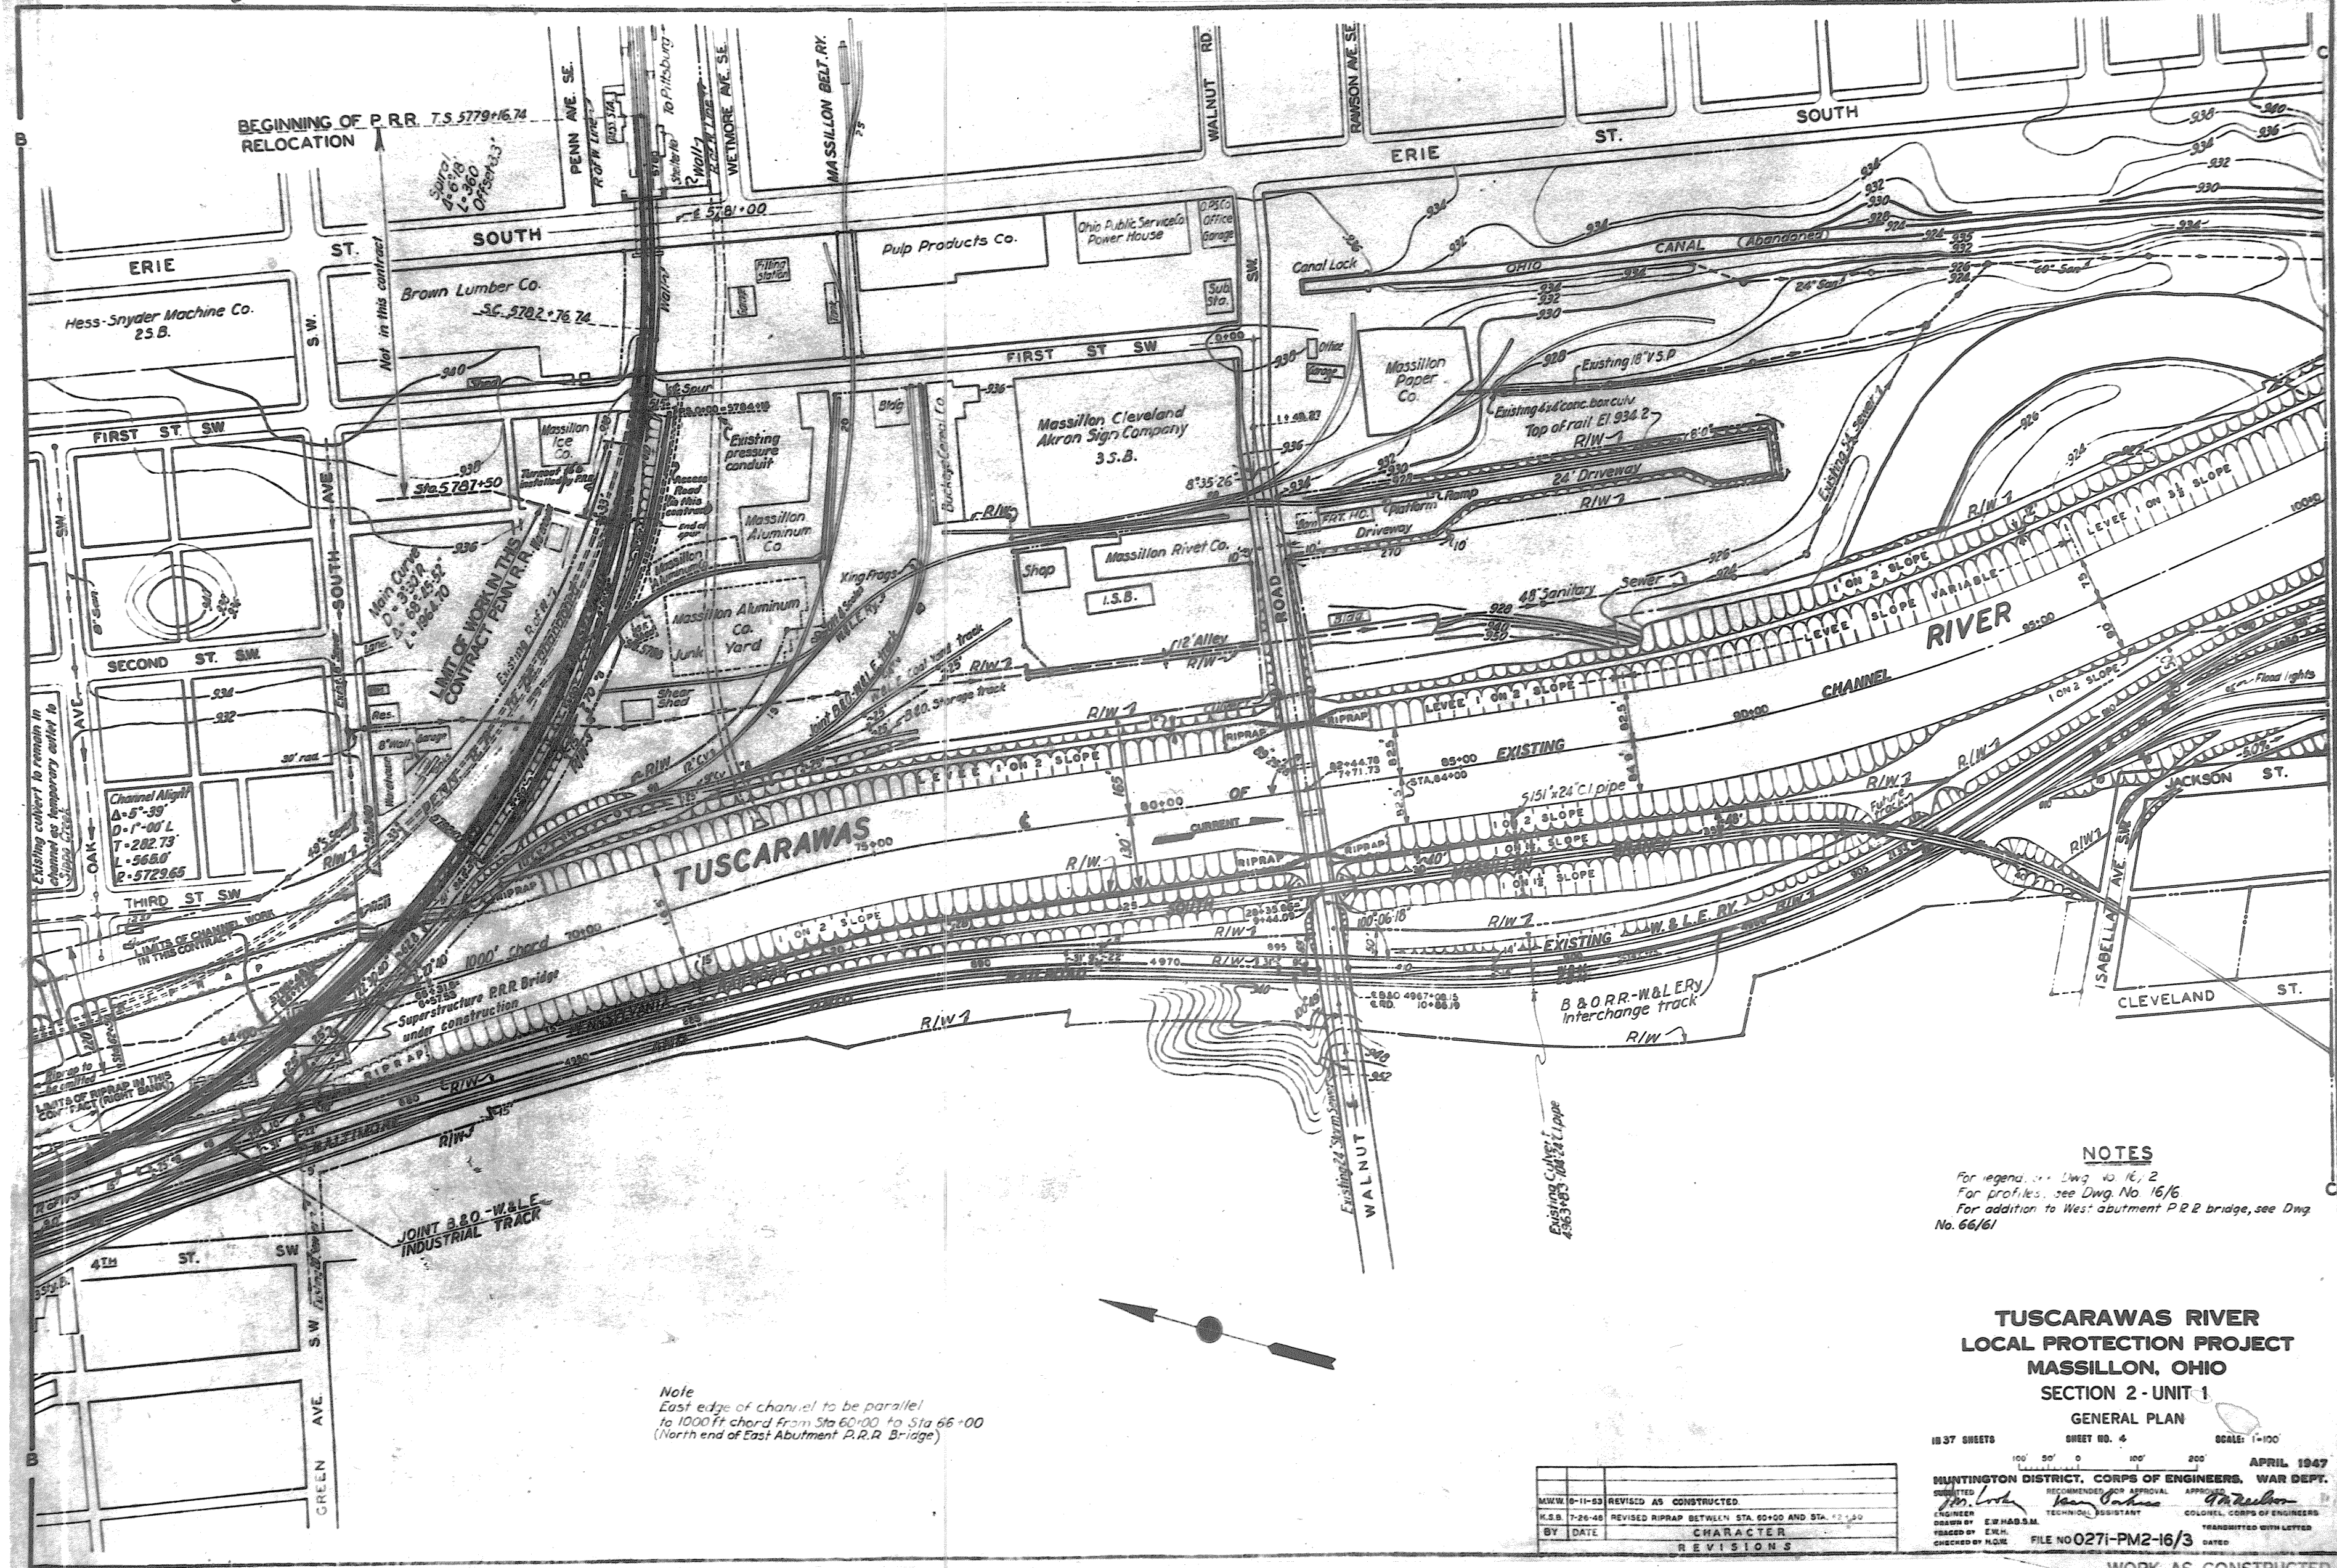


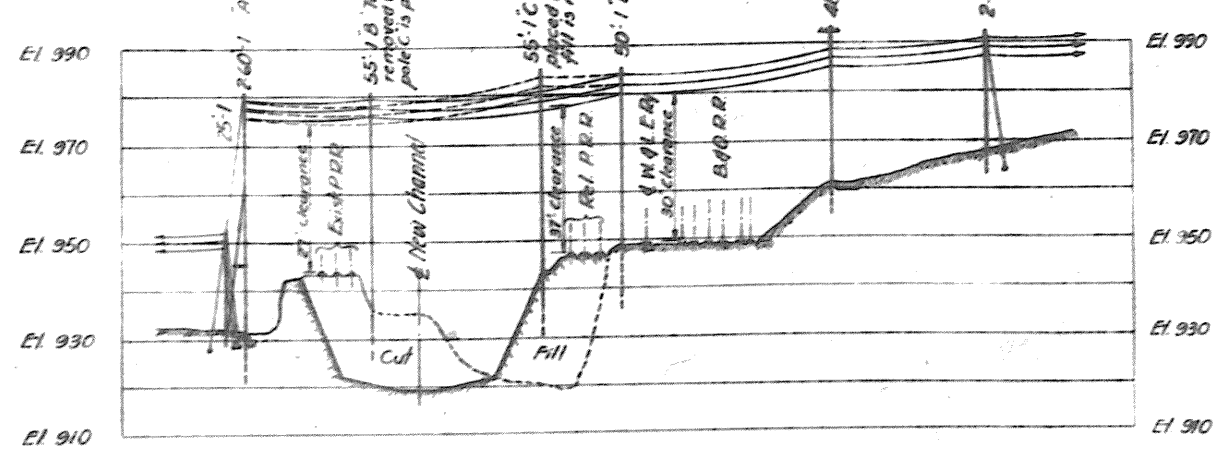

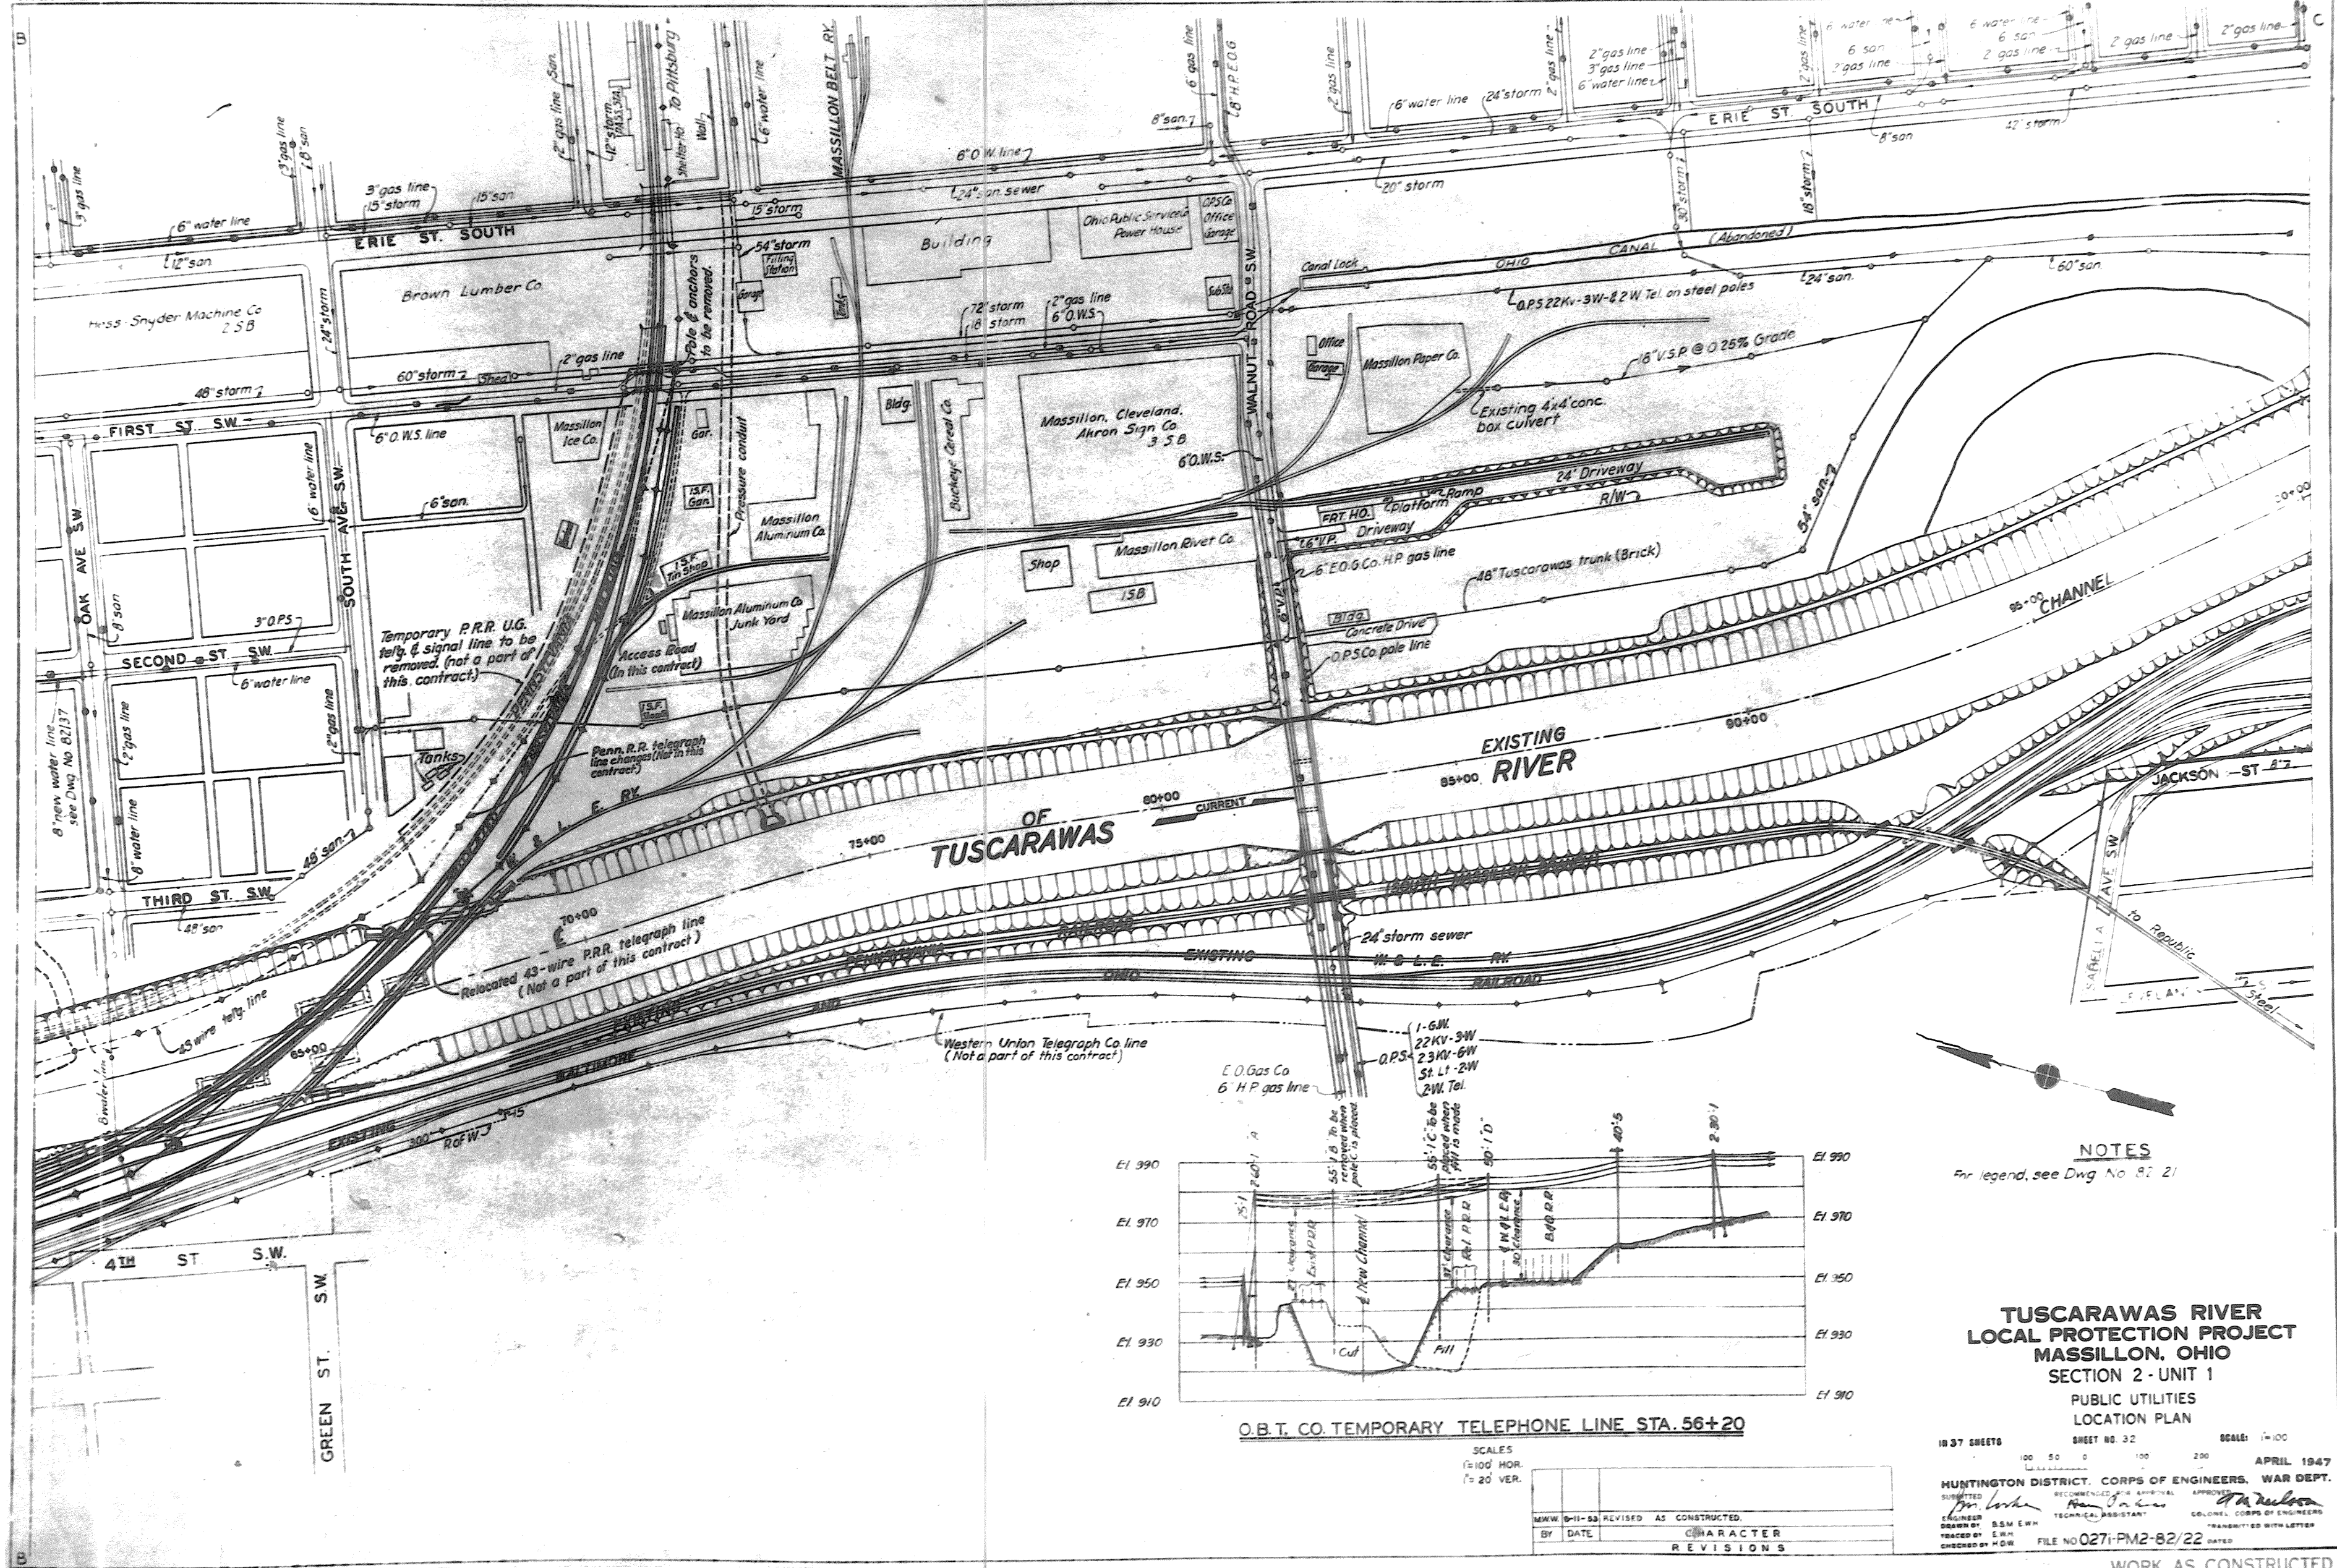

O.B.T. CO. TEMPORARY TELEPHONE LINE STA. 56+20

SCALE
1"=100' HOR.
1"=20' VER.

DATE	REVISIONS

NOTES
For legend, see Dwg No. 82-21

TUSCARAWAS RIVER
LOCAL PROTECTION PROJECT
MASSILLON, OHIO
SECTION 2 - UNIT 1

PUBLIC UTILITIES
LOCATION PLAN

10 37 SHEETS
SHEET NO. 32
SCALE: 1"=100'
APRIL 1947
HUNTINGTON DISTRICT, CORPS OF ENGINEERS, WAR DEPT.
SUBMITTED BY: [Signature]
RECOMMENDED FOR APPROVAL: [Signature]
APPROVED: [Signature]
DESIGNED BY: B.S.M. E.W.H.
CHECKED BY: E.W.H.
FILE NO. 0271-PM2-82/22
TRANSMITTED WITH LETTER

WORK AS CONSTRUCTED