CITY OF MASSILLON, OHIO

REGIONAL WASTEWATER TREATMENT PLANT UPGRADE 2000

DRAWING SET NO. 1 OF 2 CONTRACT 'A' COMPLETE


CONTRACT 'B' COMPLETE EXCEPT ELECTRICAL AND MECHANICAL CONTRACT 'D' MECHANICAL (HVAC AND PLUMBING)

CITY OFFICIALS

	FRANCIS H. CICCHINELLI, JR	MAYOR
	ALAN W. CLIMER	
	DOLORES B. LOOMIS	
	BILL H. HAMIT	TREASURER
,	JOHN D. FERRERO, JR	LAW DIRECTOR
	STEVEN D. HAMIT, P.E	CITY ENGINEER
	JOE ULRICH ————	MANAGER WASTEWATER
		TREATMENT DEPARTMENT

CITY COUNCIL

DENNIS D. HARWIG	PRESIDENT
JIM D. FILHOUR	MEMBER, WARD 1
BILL AMAN	MEMBER, WARD 2
CLAUDETTE O. ISTNICK	MEMBER, WARD 3
GLORIA A. AUTREY	MEMBER, WARD 4
GLEN GAMBER	MEMBER, WARD 5
PAUL F. LAMBERT	MEMBER, WARD 6
MIKE LOUDIANA	MEMBER AT LARGE
TIM BRYAN	MEMBER AT LARGE
NANCY J. HALTER	MEMBER AT LARGE
SHARON K. HOWELL	CLERK

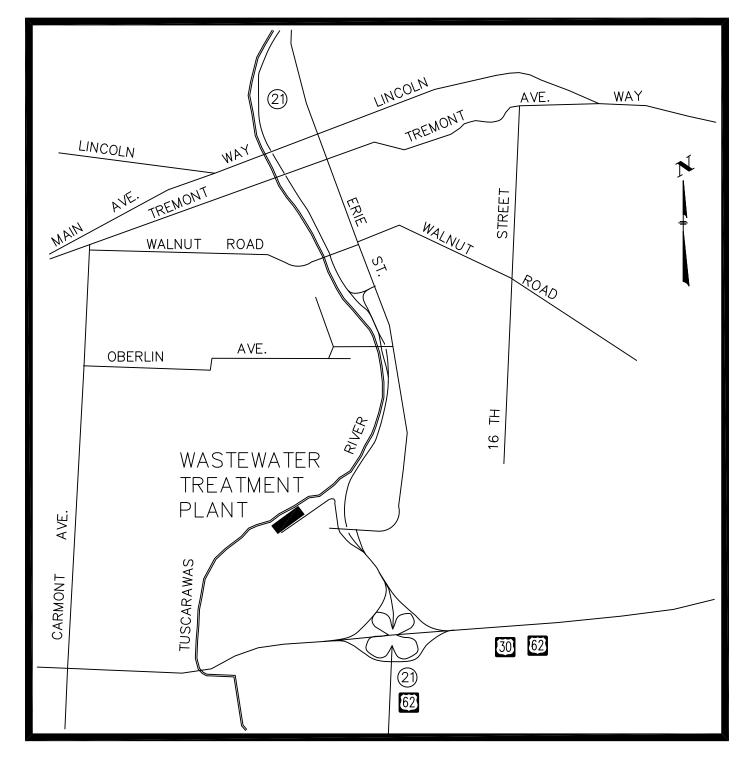


LOCATION MAP

PLANS PREPARED BY



WILLIAM A. DORMAN REG. ENGINEER No. E-44196

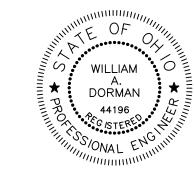

APPROVED BY:

STEVEN D. HAMIT, P.E.	DATE
CITY ENGINEER	
	<u> </u>
ALAN W. CLIMER	DATE

DIRECTOR OF PUBLIC SERVICE AND SAFETY

THESE RECORD DOCUMENTS HAVE BEEN PREPARED BASED ON INFORMATION PROVIDED BY OTHERS. CTI ENVIRONMENTAL HAS REVIEWED THE INFORMATION SUBMITTED AND BELIEVES IT REFLECTS THE WORK AS CONSTRUCTED. HOWEVER, ALL PERSONS SHALL VERIFY INFORMATION TAKEN FROM THIS DRAWING.

