


- A 5.6 MG RETENTION BASIN
- B BLOWER BUILDING
- C FINAL CLARIFIERS
- D RAS METERING CHAMBER
- E FILTRATE PUMP STATION
- F SOLIDS HANDLING BUILDING AND ADDITION
- G SLUDGE CAKE STORAGE
- H TERTIARY FILTER BUILDING
- I UV DISINFECTION
- J INFLUENT FLOW MONITORING
- K HIGH RIVER PUMPING STATION
- L ADMINISTRATION BUILDING PUMP STATION
- M MAINTENANCE BUILDING
- N SIDESTREAM STORAGE TANK
- O EFFLUENT FLOW MONITORING
- P INTRAPLANT ACCESS ROAD – CART PATH
- Q RELOCATED ENTRANCE ROAD

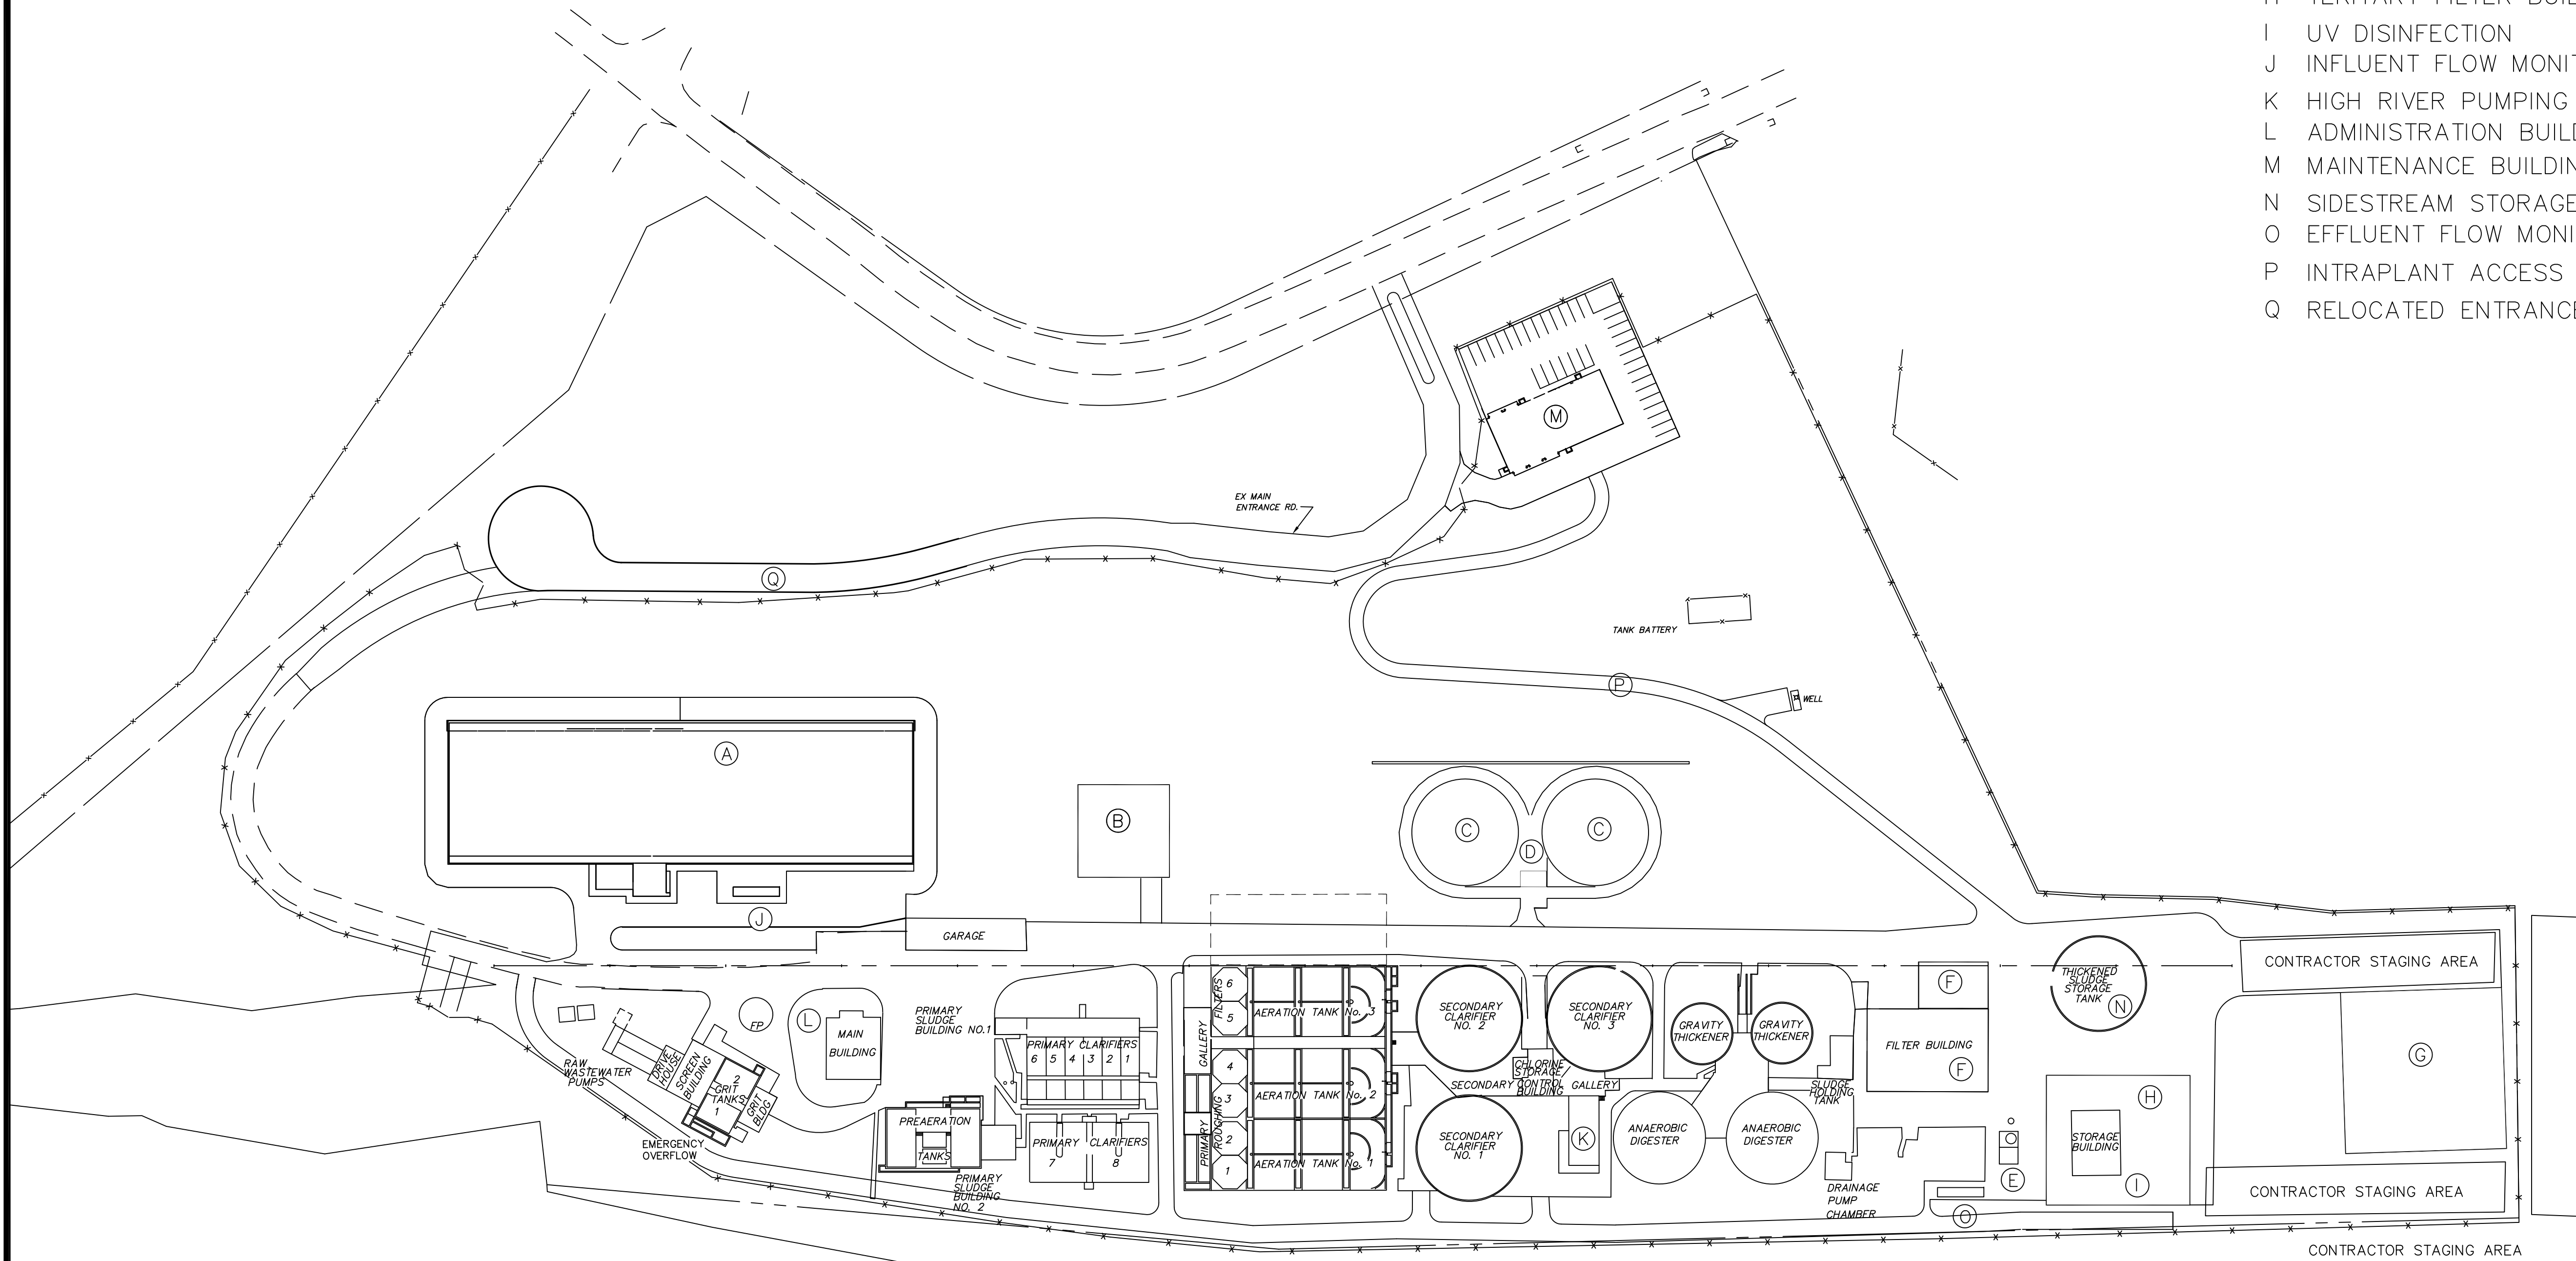

THIS DRAWING IS AN INSTRUMENT OF SERVICE OWNED BY CTI ENVIRONMENTAL, INC. WHICH SHALL BE DEEMED TO BE THE PROPERTY OF CTI ENVIRONMENTAL, INC. AND COMMON LAW RIGHTS INCLUDING COPYRIGHT AND THIS DRAWING SHALL NOT BE SCANNED, COPIED, OR REPRODUCED IN ANY MANNER WITHOUT THE WRITTEN CONSENT OF CTI ENVIRONMENTAL, INC. ANY OTHER PURPOSE OR PROJECT WITHOUT PRIOR WRITTEN CONSENT OF CTI ENVIRONMENTAL, INC. IS PROHIBITED. THIS DRAWING IS THE ORIGINAL AND THE ORIGINAL SHALL BE KEPT IN THE OFFICE OF THE ENGINEER. THIS DRAWING IS NOT TO BE USED FOR ANY OTHER PROJECT WITHOUT THE WRITTEN CONSENT OF CTI ENVIRONMENTAL, INC. THE ORIGINAL DRAWING SHALL BE KEPT IN THE OFFICE OF THE ENGINEER. THIS DRAWING IS NOT TO BE USED FOR ANY OTHER PROJECT WITHOUT THE WRITTEN CONSENT OF CTI ENVIRONMENTAL, INC. THE ORIGINAL DRAWING SHALL BE KEPT IN THE OFFICE OF THE ENGINEER.

NO.	DESCRIPTIONS	DATE	BY
1	ADDENDUM NO. 2	10/18	AJP
2	RECORD DRAWING	12/15	RWR

DESIGNED BY	DRAWN BY	CHECKED BY	APPROVED BY
AJP	AJP	RWR	WAD

NO.	DESCRIPTIONS	DATE	BY
1	ADDENDUM NO. 2	10/18	AJP
2	RECORD DRAWING	12/15	RWR

ENVIRONMENTAL, INC.
ENGINEERS IN WATER AND EARTH SCIENCES
UNCINTOWN, OHIO

CITY OF MASSILLON, OHIO
WWTP UPGRADE 2000
SITE PLAN

JOB NO. E9031
DATE 8/13/01
SCALE 1"=80'
SHEET C6

THESE RECORD DOCUMENTS HAVE BEEN PREPARED BASED ON INFORMATION PROVIDED BY OTHERS. CTI ENVIRONMENTAL HAS REVIEWED THE INFORMATION SUBMITTED AND BELIEVES IT REFLECTS THE WORK AS CONSTRUCTED. HOWEVER, ALL PERSONS SHALL VERIFY INFORMATION TAKEN FROM THIS DRAWING.