



MATCH LINE "A"
SEE SHEET C10

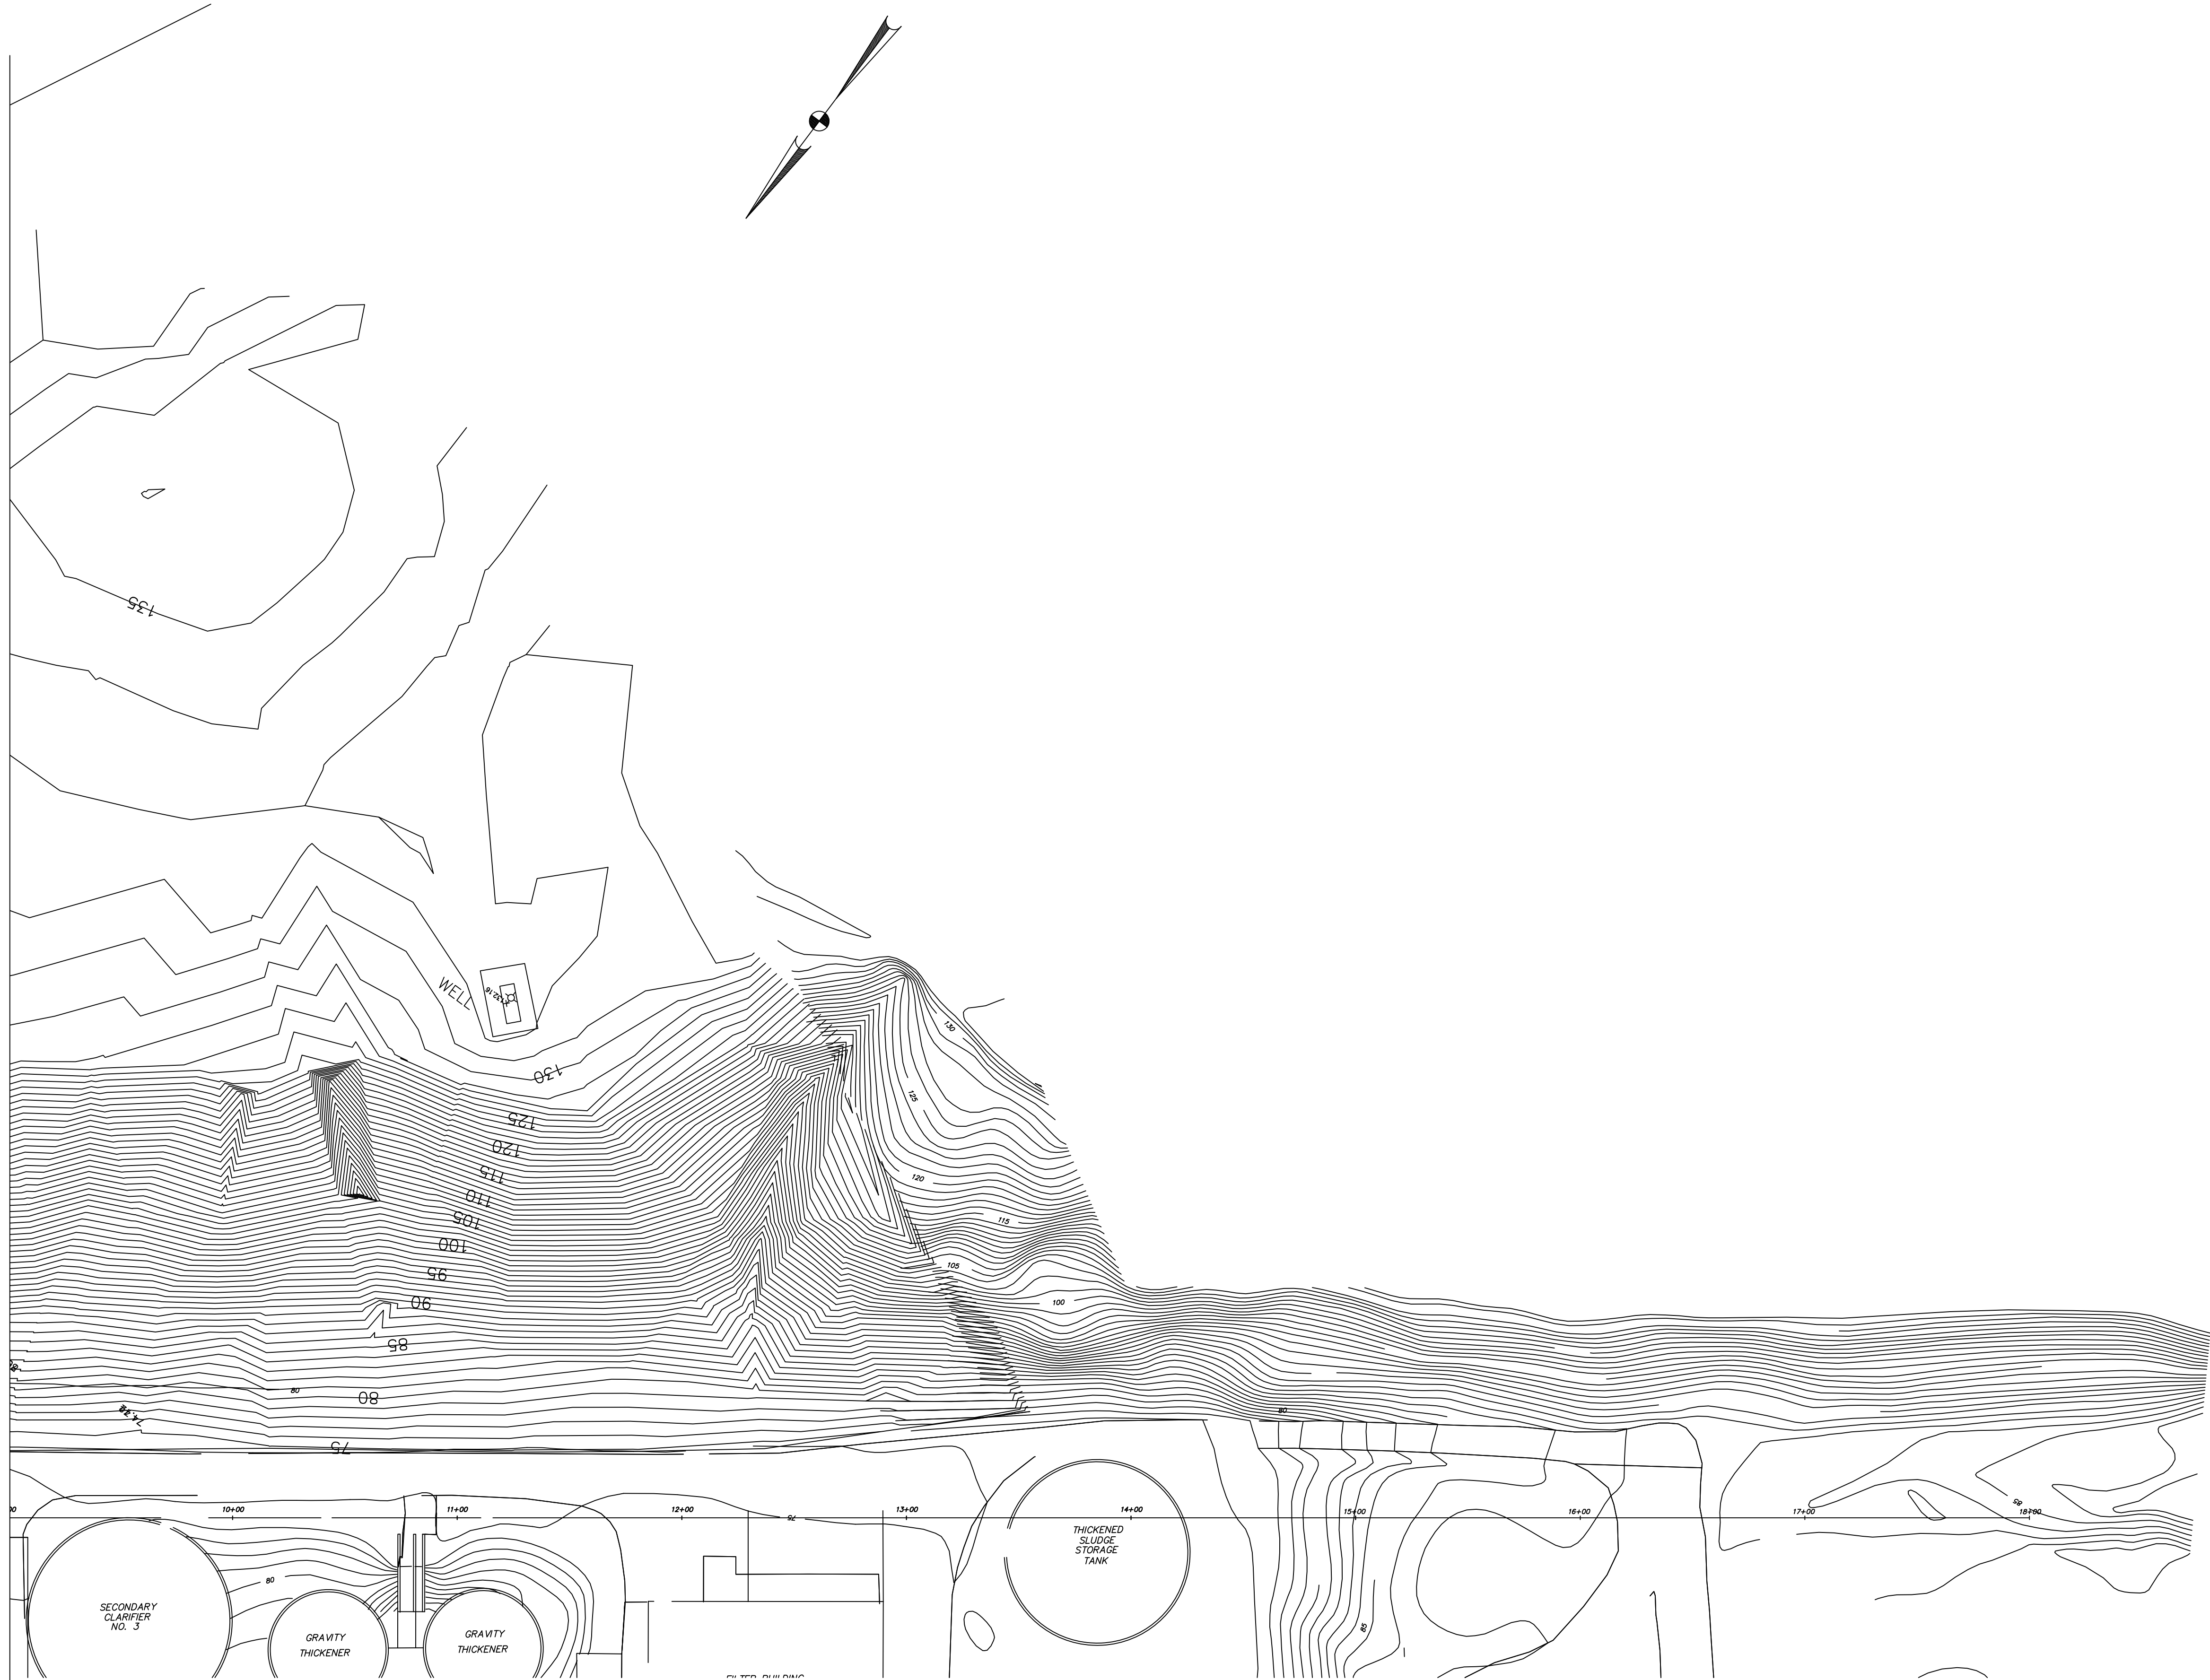

THESE RECORD DOCUMENTS HAVE BEEN PREPARED
BASED ON INFORMATION PROVIDED BY OTHERS. CTI
ENVIRONMENTAL HAS REVIEWED THE INFORMATION
SUBMITTED AND BELIEVES IT REFLECTS THE WORK AS
CONSTRUCTED. HOWEVER, ALL PERSONS SHALL
VERIFY INFORMATION TAKEN FROM THIS DRAWING.

THIS DRAWING IS AN INSTRUMENT OF SERVICE OWNED
BY CTI ENVIRONMENTAL, INC. WHICH SHALL BE DEEMED
TO HAVE BEEN PREPARED BY AN ENGINEER OR ARCHITECT
AND COMMON LAW RIGHTS INCLUDING COPYRIGHTS
AND PATENTS SHALL NOT BE SPANNED, COPIED, OR
REPRODUCED IN ANY MANNER FOR ANY OTHER
PURPOSE OR PROJECT WITHOUT PRIOR
WRITTEN CONSENT OF CTI ENVIRONMENTAL, INC.
ELECTRONIC COPIES OF THIS DRAWING ARE EXACT
REPLICAS OF THE SEALED ORIGINAL DRAWING
IN ALL RESPECTS. THE SEALED ORIGINAL
COPY AND THE SEALED ORIGINAL SHALL GOVERN.

DESIGNED BY		REVISIONS	
AJP		NO.	DESCRIPTIONS
DRAWN BY		DATE	BY
AJP		9/12	AJP
CHECKED BY		12/28	AJP
WAD			
APPROVED BY			
WAD			

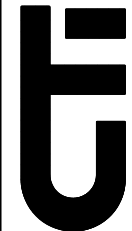

ENVIRONMENTAL, INC.
ENGINEERS IN WATER AND EARTH SCIENCES
UNIONTOWN, OHIO

CITY OF MASSILLON, OHIO
WWTP UPGRADE 2000
EXISTING CONTOURS HILLSIDE

JOB NO. E9031
DATE 8/13/01
SCALE 1"=40'
SHEET C11