



EROSION CONTROL GENERAL NOTES

1. THE EROSION CONTROL MEASURES DESCRIBED HEREIN ARE TYPICAL. THE CONTRACTOR SHALL USE THIS PLAN AS A GUIDE TO CONTROL EROSION. IN THE EVENT OF ADVERSE WEATHER CONDITIONS, ETC. ADDITIONAL MEASURES SHOULD BE TAKEN TO ESTABLISH AND MAINTAIN PROTECTIVE VEGETATION.
2. CONTINUOUS MAINTENANCE WILL BE REQUIRED AS NECESSARY UNTIL PERMANENT, STABLE VEGETATIVE COVER HAS BEEN ESTABLISHED AND EROSION HAS BEEN CONTROLLED. THIS INCLUDES BUT IS NOT LIMITED TO RESEEDING, MULCHING, EARTH FILLING, ETC.
3. DISTURBED AREAS SHALL BE KEPT TO A MINIMUM WITH RESPECT TO AREAS EXPOSED AND TIME OF EXPOSURE. ALL TOPSOIL SHALL BE STOCKPILED. DISTURBED AREAS WHICH WILL REMAIN UNWORKED FOR 45 DAYS OR MORE , (INCLUDING STOCKPILED TOPSOIL) SHALL BE STABILIZED WITH SEEDING AND MULCHING OR OTHER APPROPRIATE MEANS WITHIN 7 DAYS.
4. TEMPORARY EROSION CONTROL SHALL CONFORM TO O.D.O.T. ITEM 207, TEMPORARY SOIL EROSION AND SEDIMENT CONTROL AS TYPIFIED ON THE PLAN.
5. THE ESTABLISHMENT OF PERMANENT GROUND COVER SHALL CONFORM TO O.D.O.T. ITEM 659, SEEDING AND MULCHING.
6. IF SMALL RILLS OR GULLIES DEVELOP, TEMPORARY DIVERSIONS OF EARTH FILL OR STRAW BALES SHOULD BE INSTALLED UNTIL SATISFACTORY SEEDING IS ESTABLISHED.
7. TO ASSIST IN EROSION CONTROL, ALL TREES AND VEGETATION OUTSIDE OF GRADED AREAS SHALL REMAIN.
8. TEMPORARY STRAW BALE SEDIMENT CONTROL DIKES SHALL BE PER DETAIL ON PLAN. SILT FENCE FABRIC SHALL BE EXXON GTF-100S OR APPROVED EQUAL.
9. ADJACENT ROADS SHALL BE KEPT FREE OF DIRT AND DEBRIS AT ALL TIMES.
10. ALL EROSION AND SEDIMENT CONTROL PRACTICES MUST MEET THE STANDARDS AND SPECIFICATIONS OF THE OHIO RAINWATER AND LAND DEVELOPMENT HANDBOOK (1996).
11. ALL S.W.P.P.P. ITEMS MUST BE INSTALLED PRIOR TO ANY EARTH MOVING OPERATIONS.
12. EROSION CONTROL BLANKETS WITH MATTING WILL BE USED ON DITCHES GREATER THAN 1.5% AND ALL OTHER SLOPES GREATER THAN 6.0% GRADE.
13. OTHER EROSION CONTROL ITEMS MAY BE NECESSARY DUE TO ENVIRONMENTAL CONDITIONS.

14. REGULAR INSPECTION AND MAINTENANCE WILL BE PROVIDED FOR ALL EROSION CONTROL PRACTICES. PERMANENT RECORDS OF MAINTENANCE AND INSPECTIONS MUST BE KEPT THROUGHOUT CONSTRUCTION PERIOD. INSPECTIONS MUST BE MADE A MINIMUM OF ONCE EVERY 7 DAYS AND IMMEDIATELY AFTER STORM EVENTS GREATER THAN 0.5 INCHES IN A 24 HOUR PERIOD. PROVIDE NAME OF INSPECTOR, MAJOR OBSERVATIONS, DATE OF INSPECTION, CERTIFICATION OF COMPLIANCE AND CORRECTIVE MEASURES TAKEN.
15. NO SOLID OR LIQUID WASTE SHALL BE DISCHARGED INTO STORM WATER RUNOFF.
16. SEDIMENT PONDS/ TRAPS AND PERIMETER CONTROLS SHALL BE IMPLEMENTED AS A FIRST STEP OF GRADING AND WITHIN 7 DAYS FROM THE START OF GRUBBING AND SHALL CONTINUE TO FUNCTION UNTIL UPLAND AREAS ARE STABILIZED.
17. OFF-SITE VEHICLE TRACKING SEDIMENT SHALL BE MINIMIZED. CONSTRUCTION VEHICLES ARE LIMITED TO THE CONSTRUCTION ACCESS ROAD(S) NOTED ON THE PLAN.
18. OTHER EROSION AND SEDIMENT CONTROL ITEMS MAY BE NECESSARY DUE TO ENVIRONMENTAL CONDITIONS.

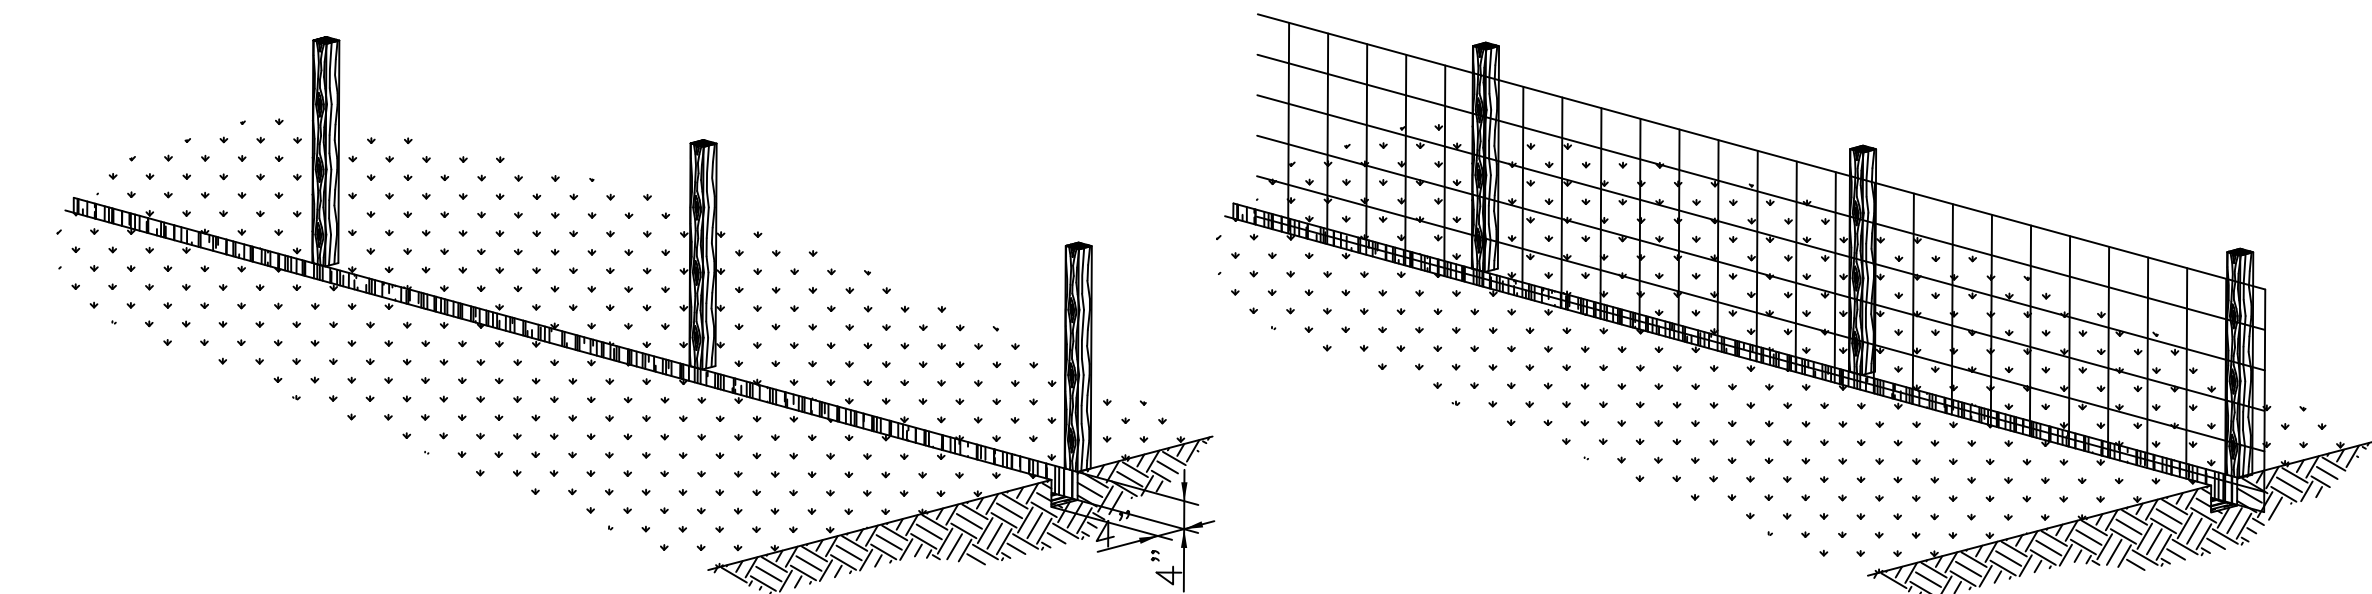

1. SET POSTS AND EXCAVATE A 4" X 6" TRENCH UPSLOPE ALONG THE LINE OF POSTS.
2. STAPLE WIRE FENCING TO THE POSTS.

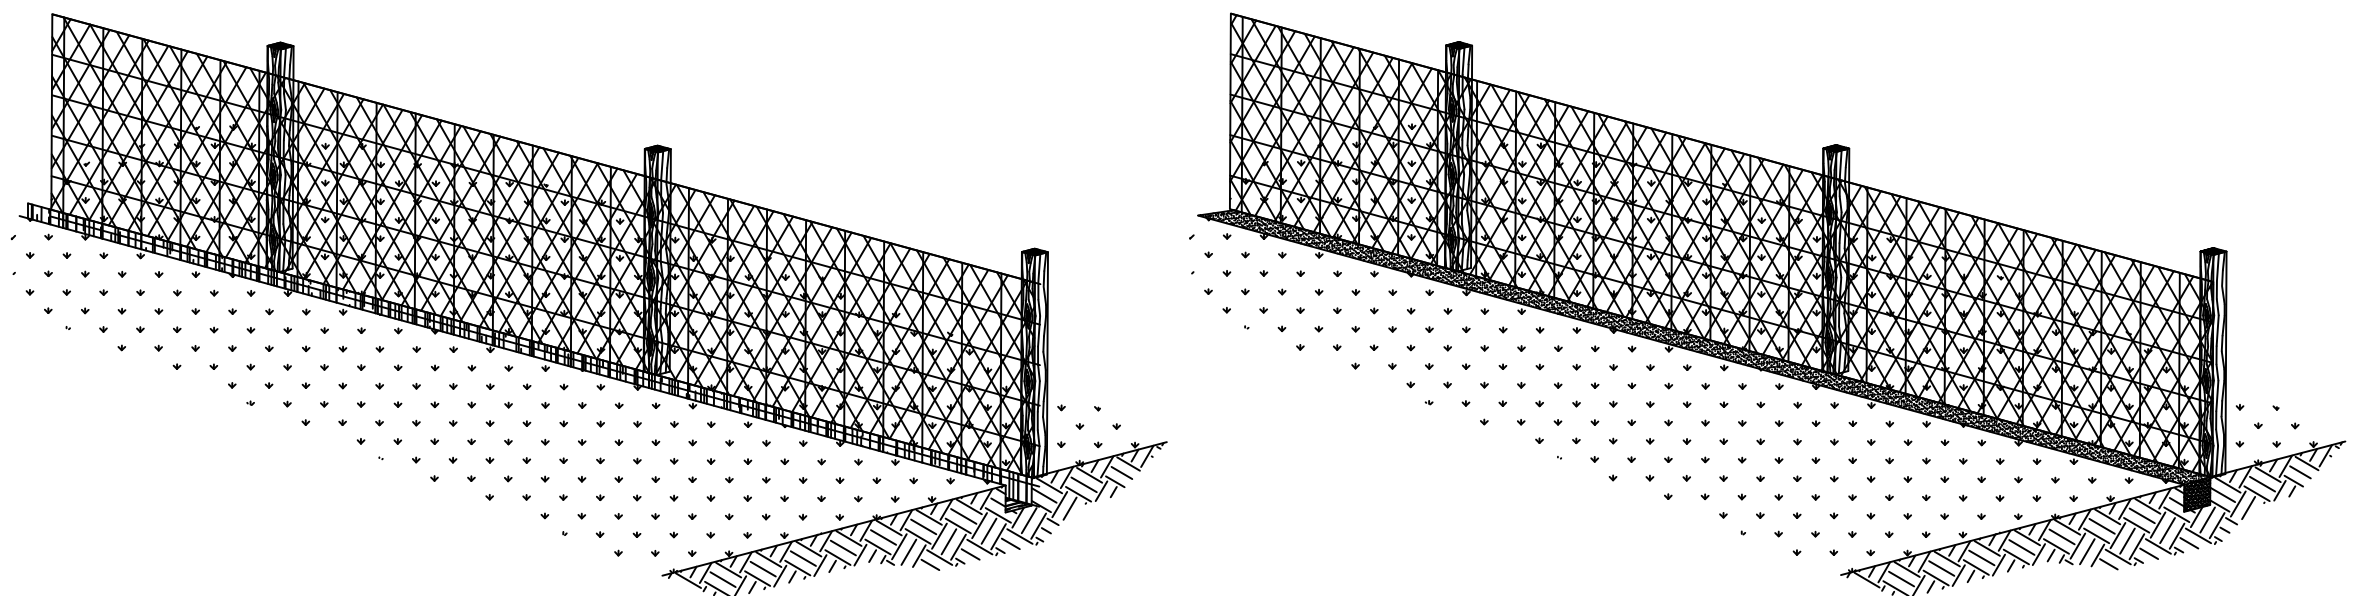


3. ATTACH THE FILTER FABRIC TO THE WIRE FENCE AND EXTEND IT INTO THE TRENCH.
4. BACKFILL AND COMPACT THE EXCAVATED SOIL.

SILT FENCE DETAIL

NO SCALE

REQUIRED EROSION CONTROL FOR
ALL PROPOSED CURB INLETS

1. INSTALL SILT FENCE ENTIRELY AROUND EACH INLET AND MAINTAIN AS REQUIRED.
2. UPON INSTALLATION OF THE CURB AND GUTTER, MAINTAIN THE SILT FENCE BEHIND THE CURB, AND PLACE STRAW BALES IN THE GUTTER.
3. MAINTAIN THE STRAW BALES UNTIL THE BASE COURSE OF ASPHALT PAVING IS INSTALLED.
4. MAINTAIN THE SILT FENCE BEHIND THE CURB UNTIL THE GRASS IN THE TREE LAWN IS ESTABLISHED.

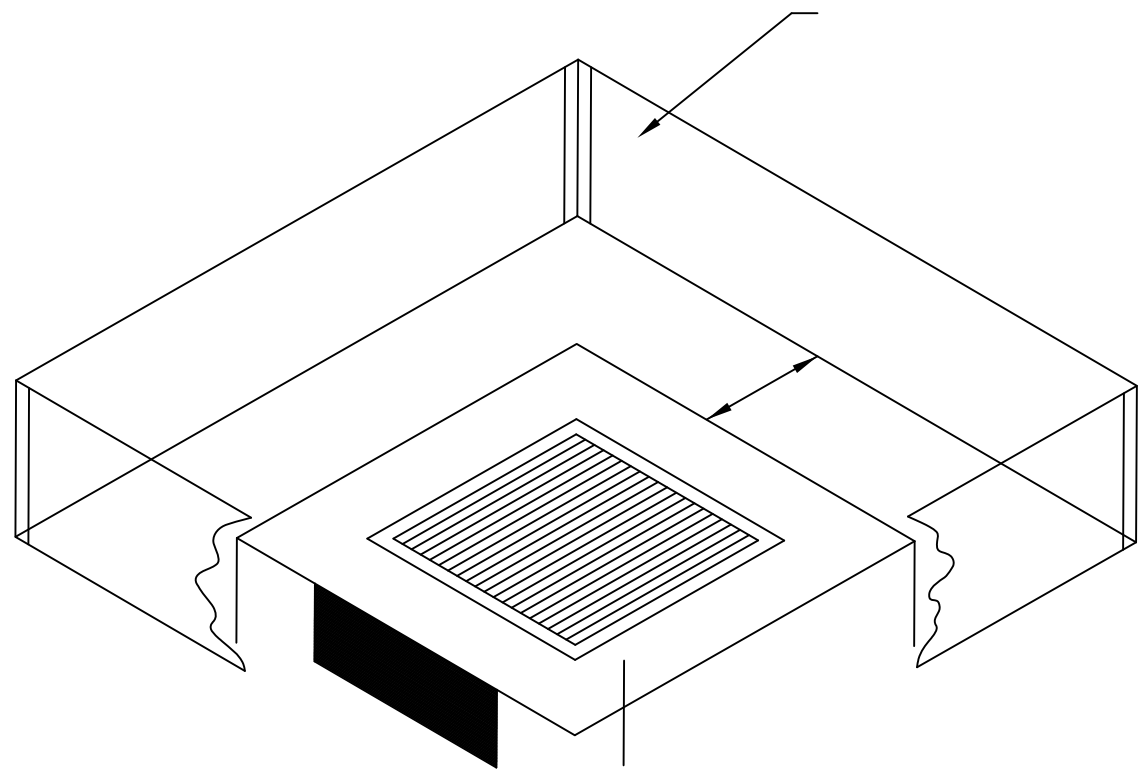


INLET PROTECTION

INLET PROTECTION TO BE PLACED AT ALL INLETS ARE INSTALLED, UNTIL SITE IS STABILIZED.

SILT FENCE FILTER FOR INLETS

SITE ACREAGE = 25± ACRES

DENOTES: SILT FENCE

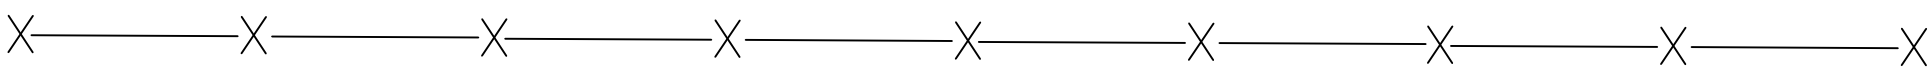

THESE RECORD DOCUMENTS HAVE BEEN PREPARED BASED ON INFORMATION PROVIDED BY OTHERS. CTI ENVIRONMENTAL HAS REVIEWED THE INFORMATION SUBMITTED AND BELIEVES IT REFLECTS THE WORK AS CONSTRUCTED. HOWEVER, ALL PERSONS SHALL VERIFY INFORMATION TAKEN FROM THIS DRAWING.

REVISIONS				
NO.	DESCRIPTIONS	DATE	BY	APPD
1	RECORD DRAWING	12/16	RWR	WAD

DESIGNED BY ELR/AJP	ENVIRONMENTAL, INC. ENGINEERS IN WATER AND EARTH SCIENCES UNIONTOWN, OHIO	CITY OF MASSILLON, OHIO WWTP UPGRADE 2000 STORM WATER POLLUTION PREVENTION DETAILS
DRAWN BY ELR/AJP		
CHECKED BY MCW		
APPROVED BY WAD		

JOB NO. E9031
DATE 8/13/01
SCALE 1"=40'
SHEET C14