



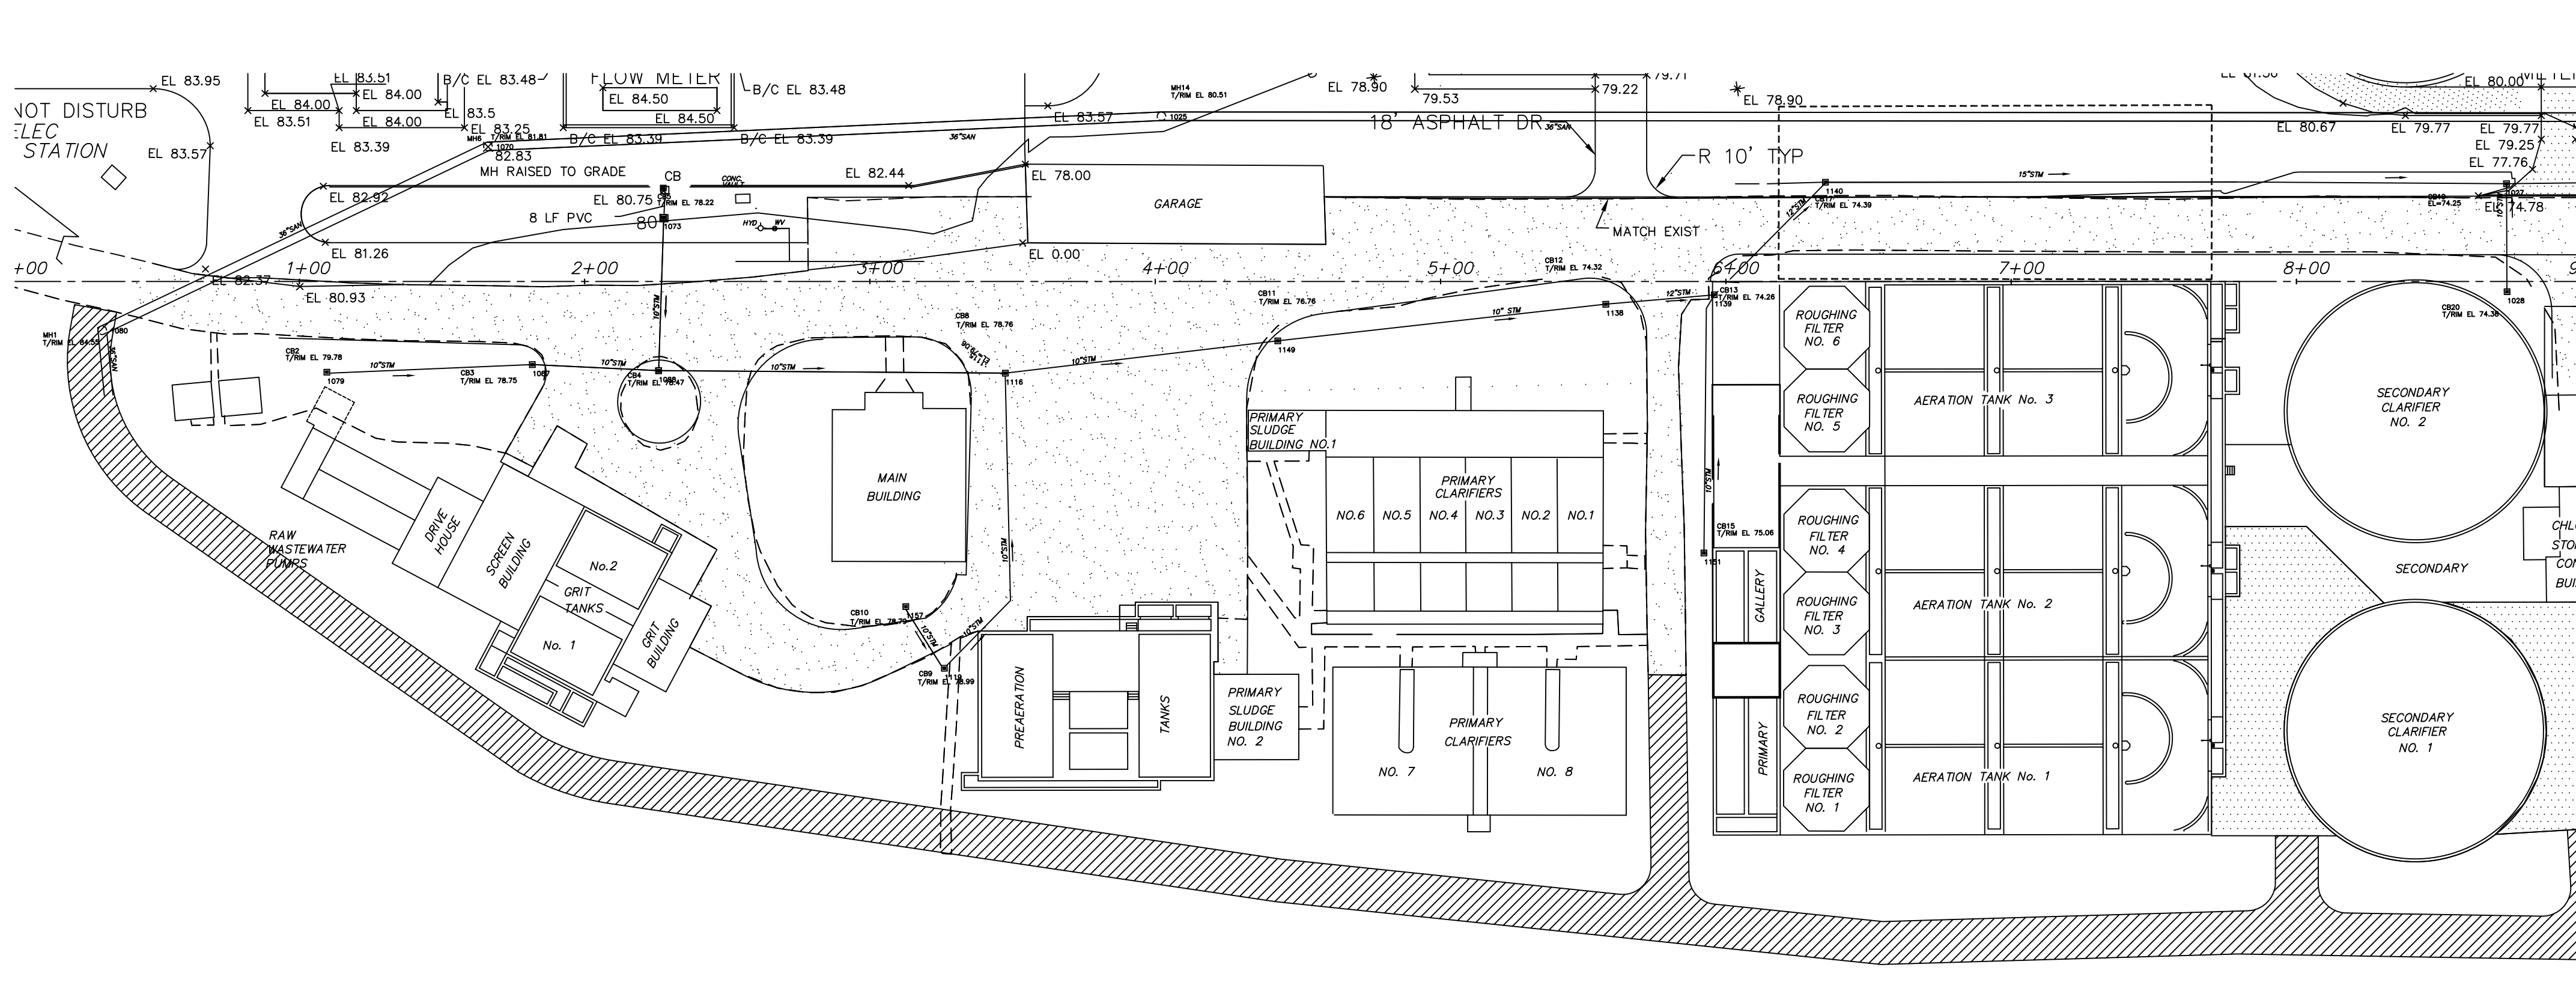


MATCH LINE "A"

LEGEND


PROPOSED CART PATH

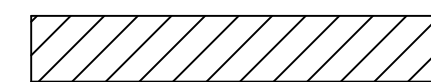



NEW CONCRETE

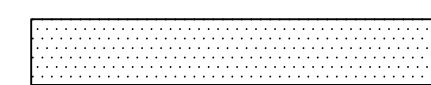

EXISTING PAVEMENT
NEW RESURFACING

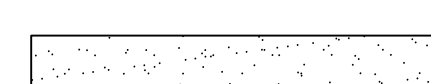

NEW PAVEMENT

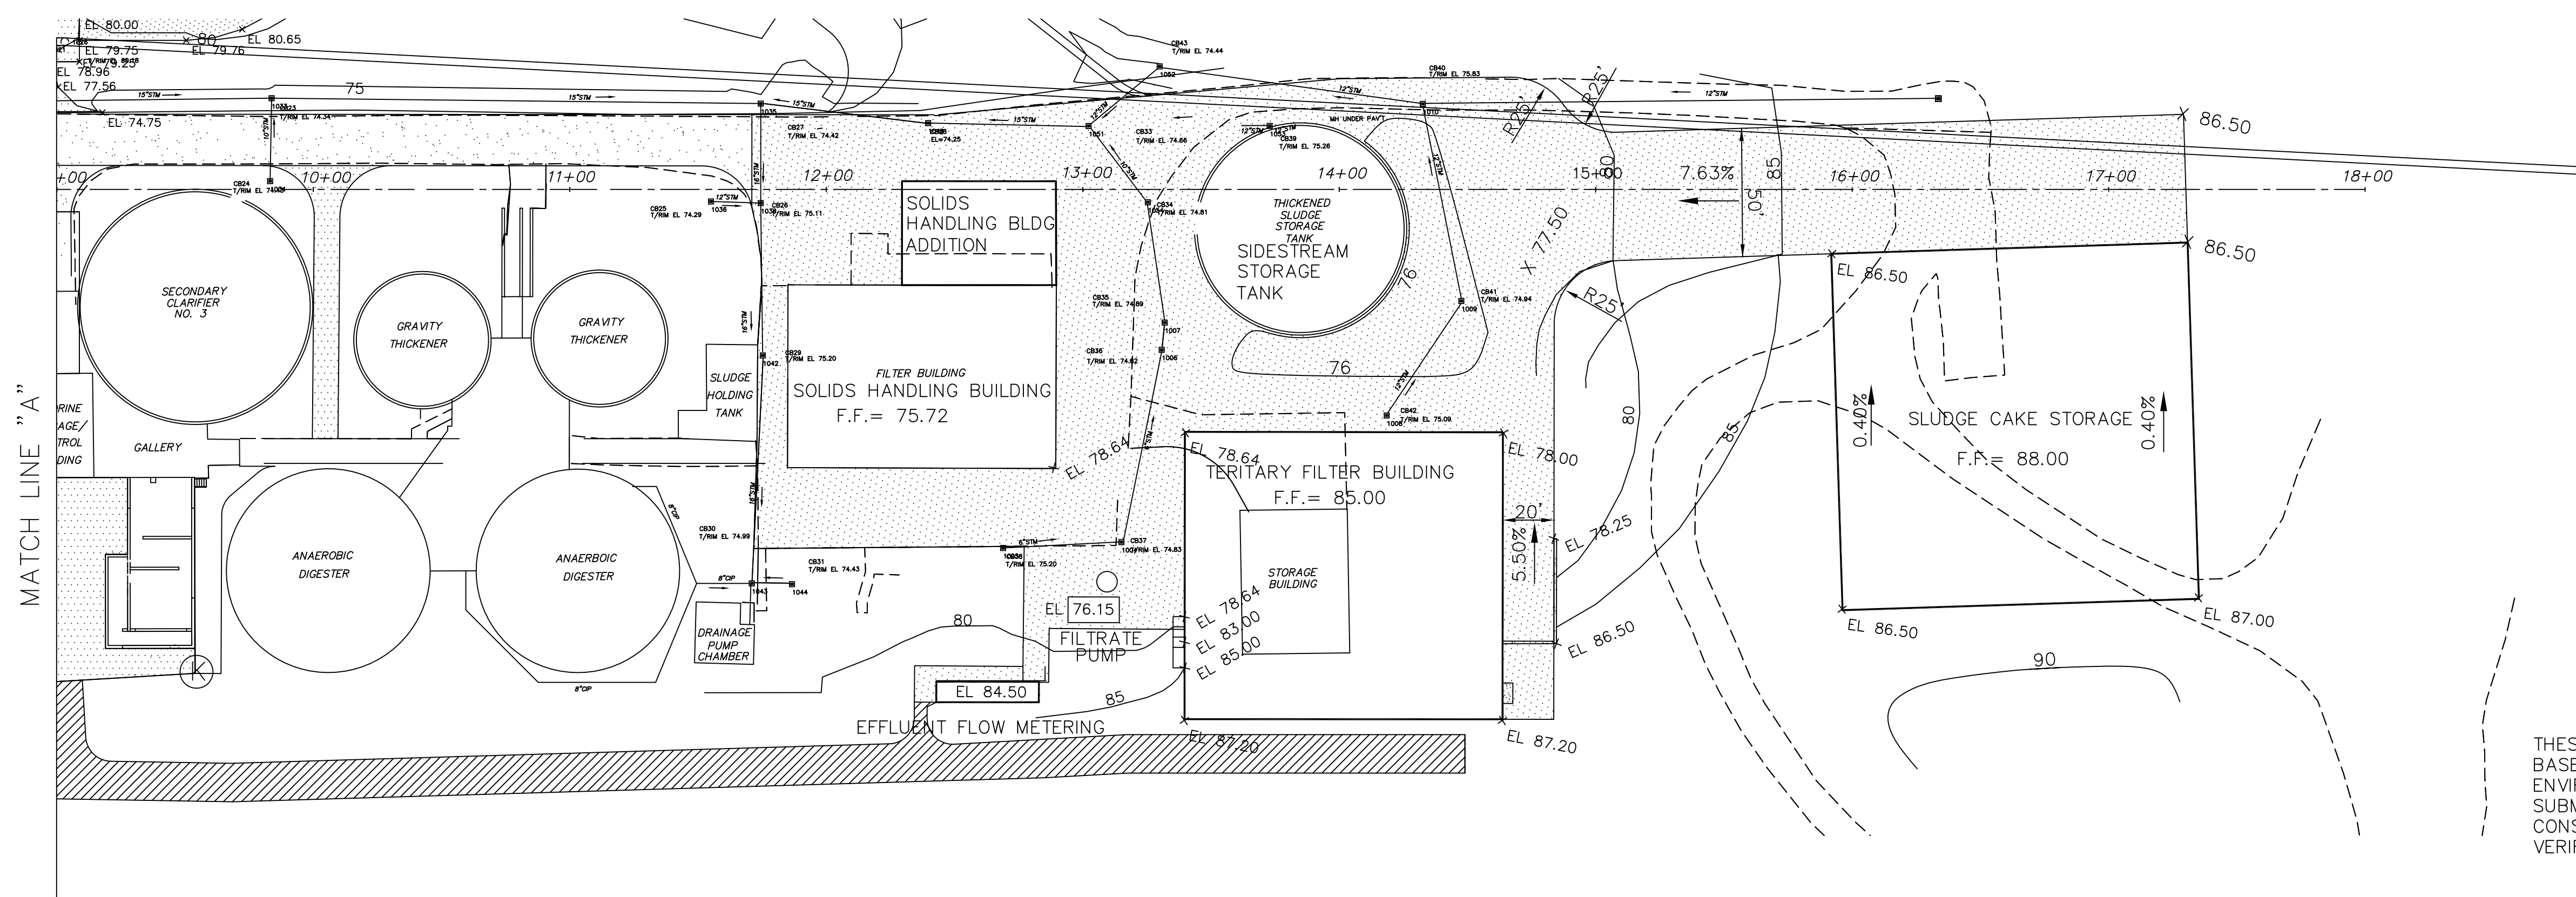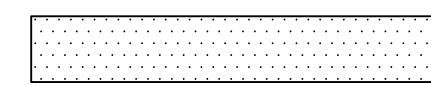

MATCH LINE "A"

THESE RECORD DOCUMENTS HAVE BEEN PREPARED
BASED ON INFORMATION PROVIDED BY OTHERS. CTI
ENVIRONMENTAL HAS REVIEWED THE INFORMATION
SUBMITTED AND BELIEVES IT REFLECTS THE WORK AS
CONSTRUCTED. HOWEVER, ALL PERSONS SHALL
VERIFY INFORMATION TAKEN FROM THIS DRAWING.

THIS DRAWING IS AN INSTRUMENT OF SERVICE OWNED
BY CTI ENVIRONMENTAL, INC. WHICH SHALL BE LOANED
TO THE CLIENT FOR THE PROJECT ONLY. IT IS NOT TO BE
REPRODUCED, COPIED, OR TRANSMITTED IN ANY
MANNER WITHOUT THE WRITTEN CONSENT OF CTI
ENVIRONMENTAL, INC. ANY REUSE OR MODIFICATION
OF THIS DRAWING WITHOUT THE WRITTEN CONSENT
OF CTI ENVIRONMENTAL, INC. SHALL BE AT THE USER'S
SOLE RISK AND WITHOUT LIABILITY TO CTI
ENVIRONMENTAL, INC.

NO.	DESIGNER	DATE	BY	APP'D
1	ADDENDUM NO. 1	9/12	AJP	WAD
2	RECORD DRAWING	12/15	RWR	WAD

ENVIRONMENTAL, INC.
ENGINEERS IN WATER AND EARTH SCIENCES
UNIONTOWN, OHIO



CITY OF MASSILLON, OHIO
WWTP UPGRADE 2000
GRADING PLAN DETAIL AREAS

JOB NO. E9031
DATE 8/13/01
SCALE 1"=40'
SHEET C18