

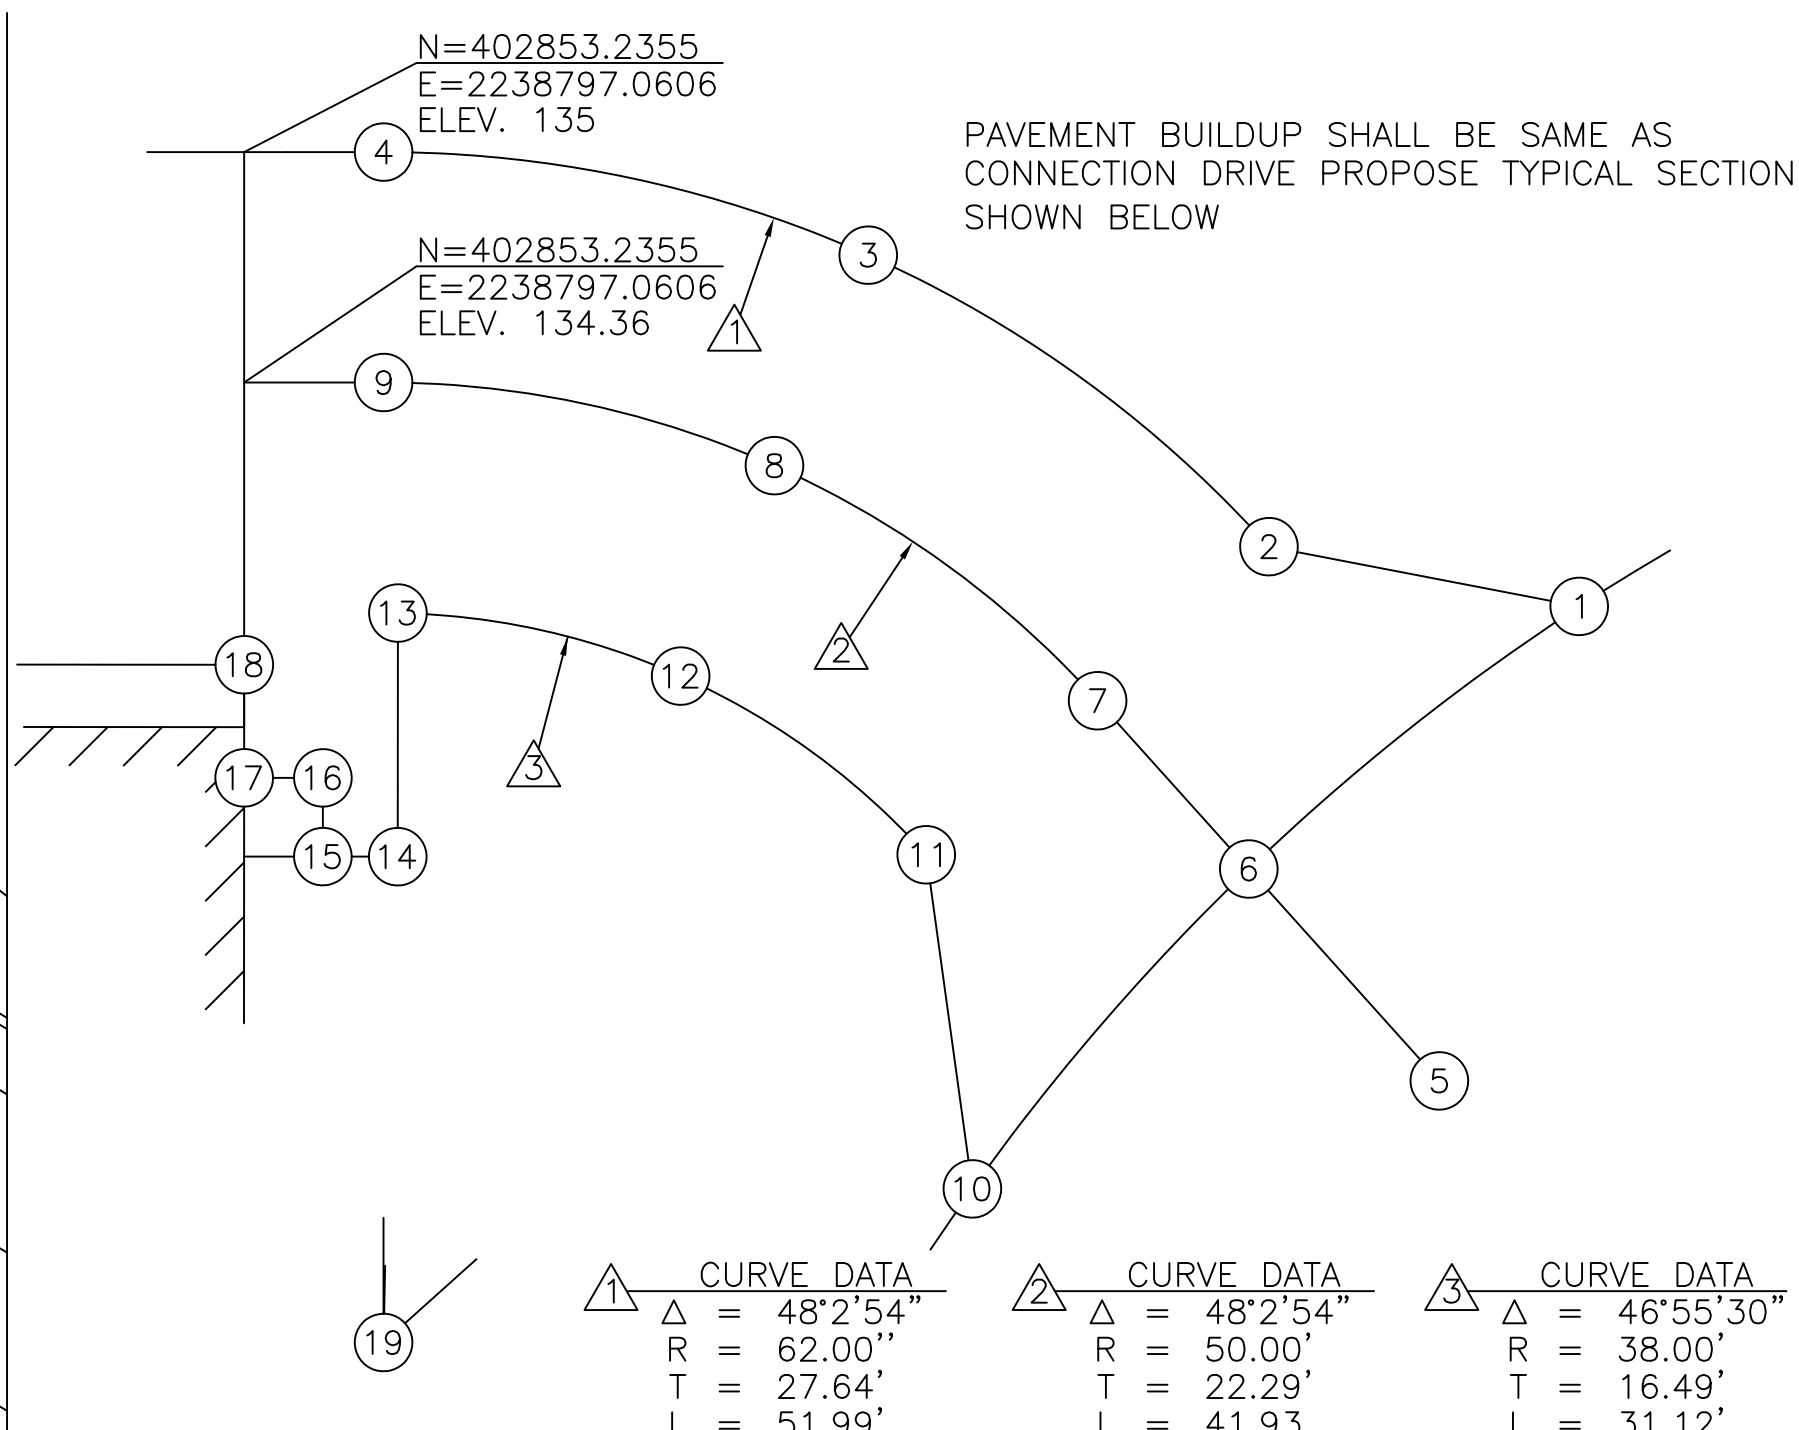
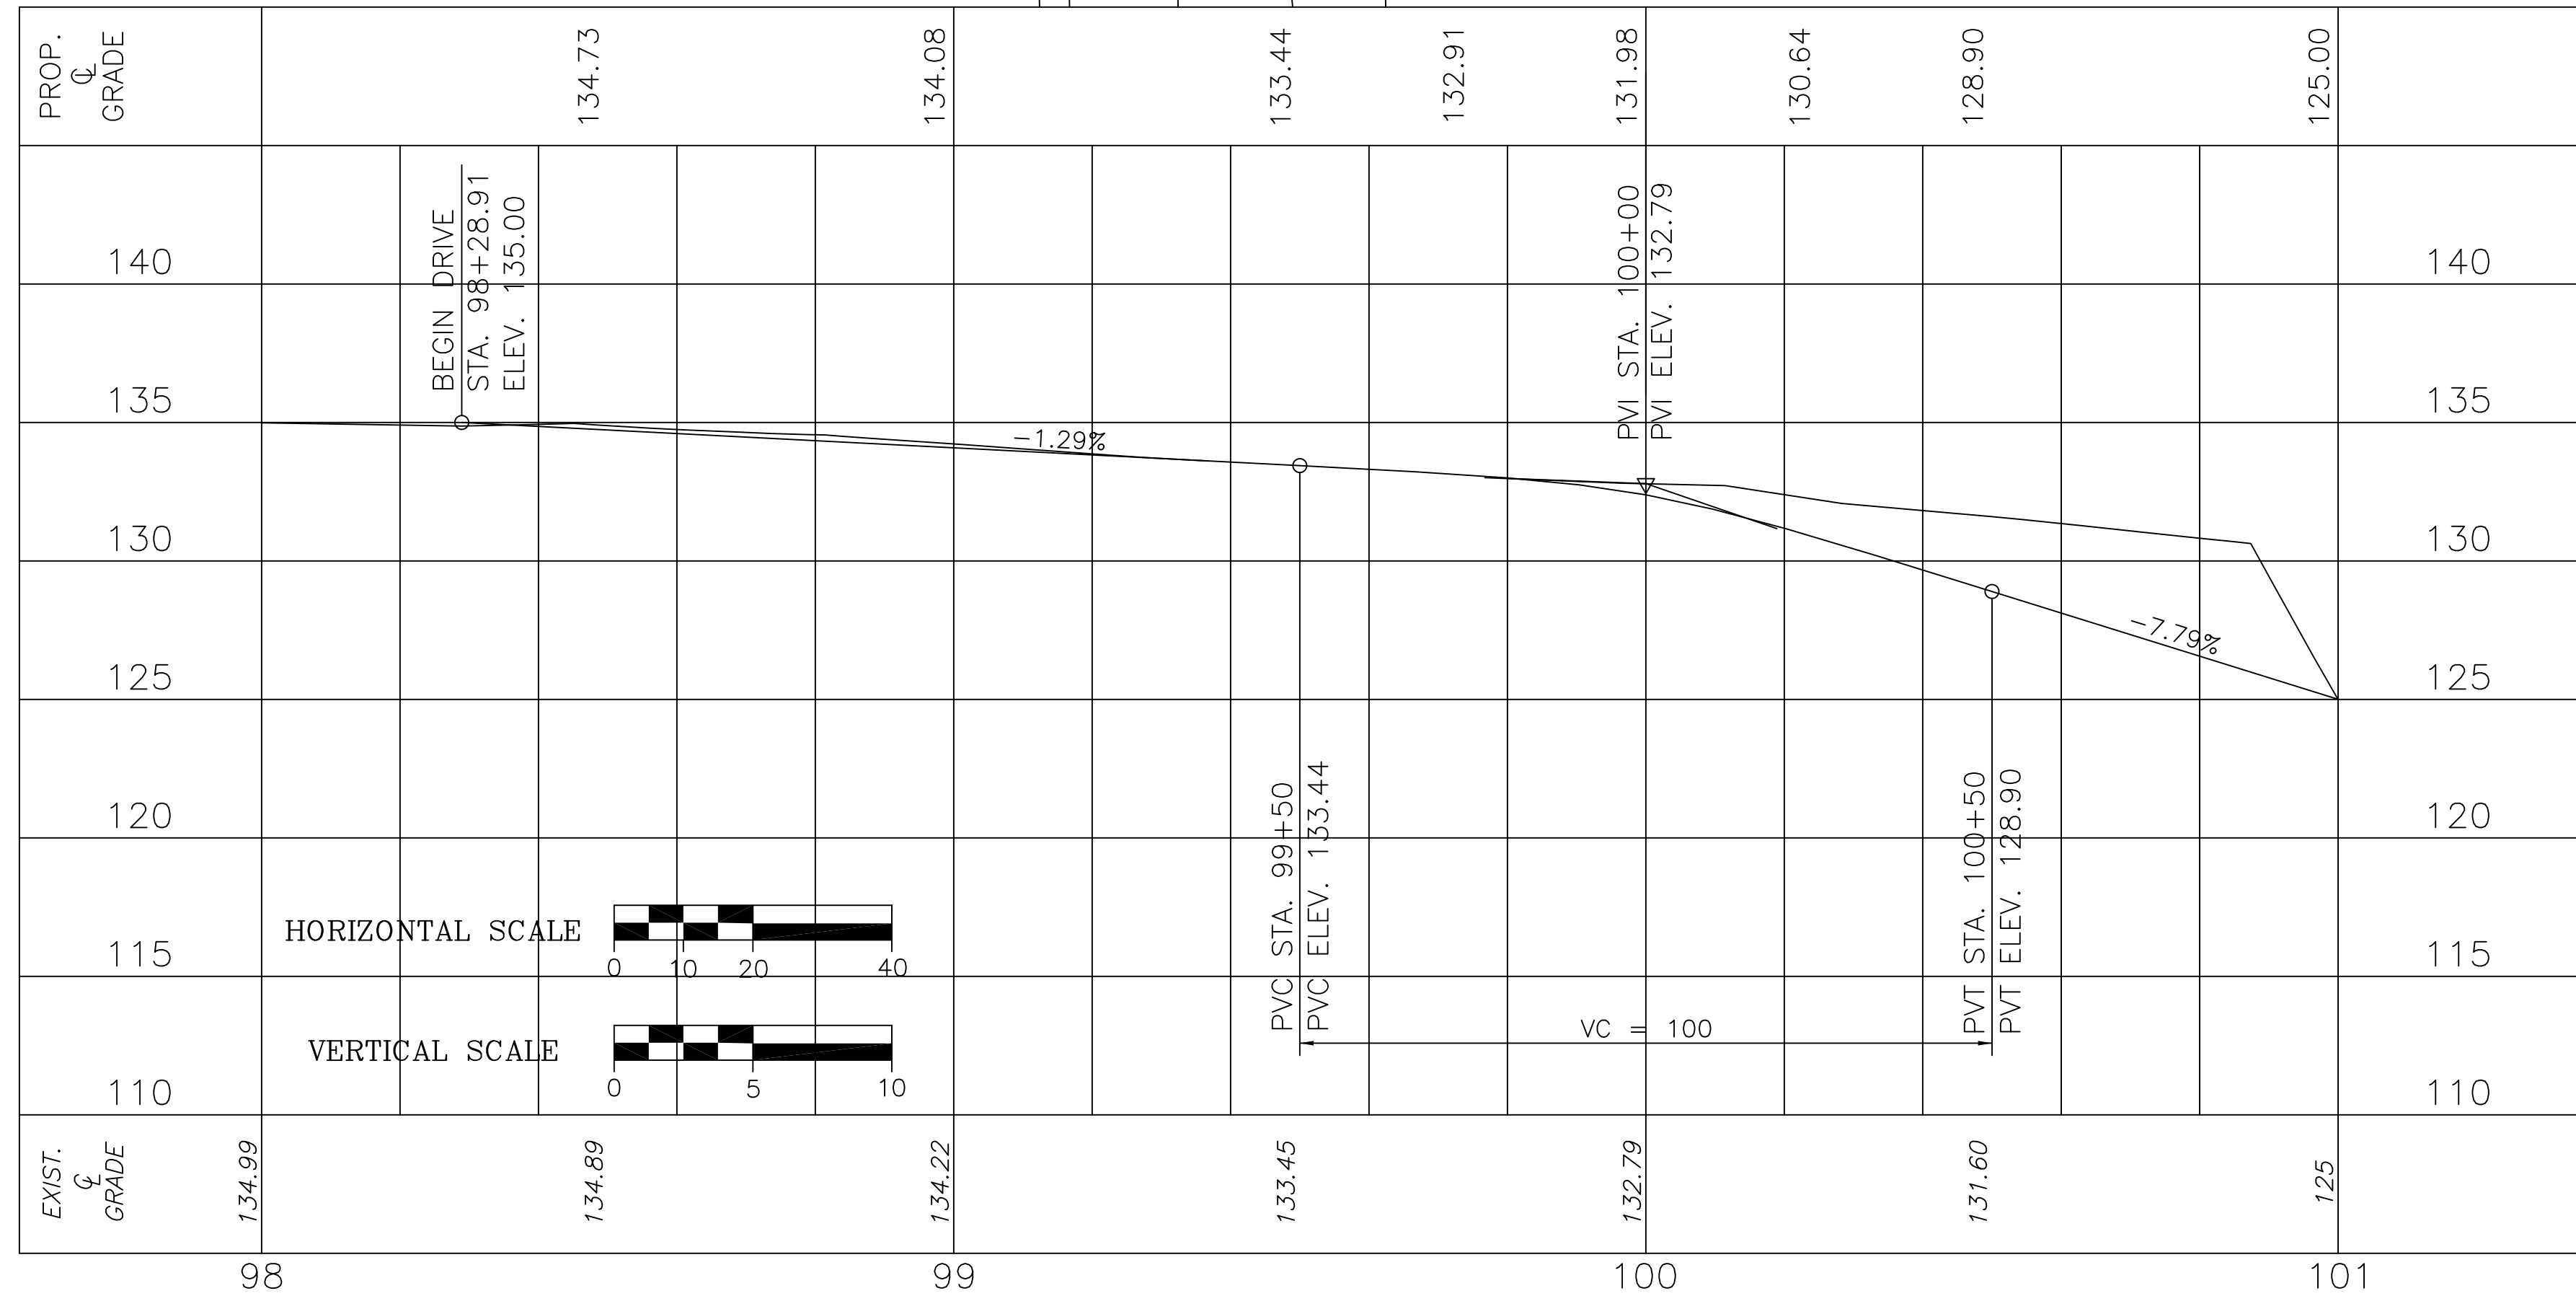


CONTROL AND BENCH MARK BASED FROM
WWTP 2000 UPGRADE PLANS.

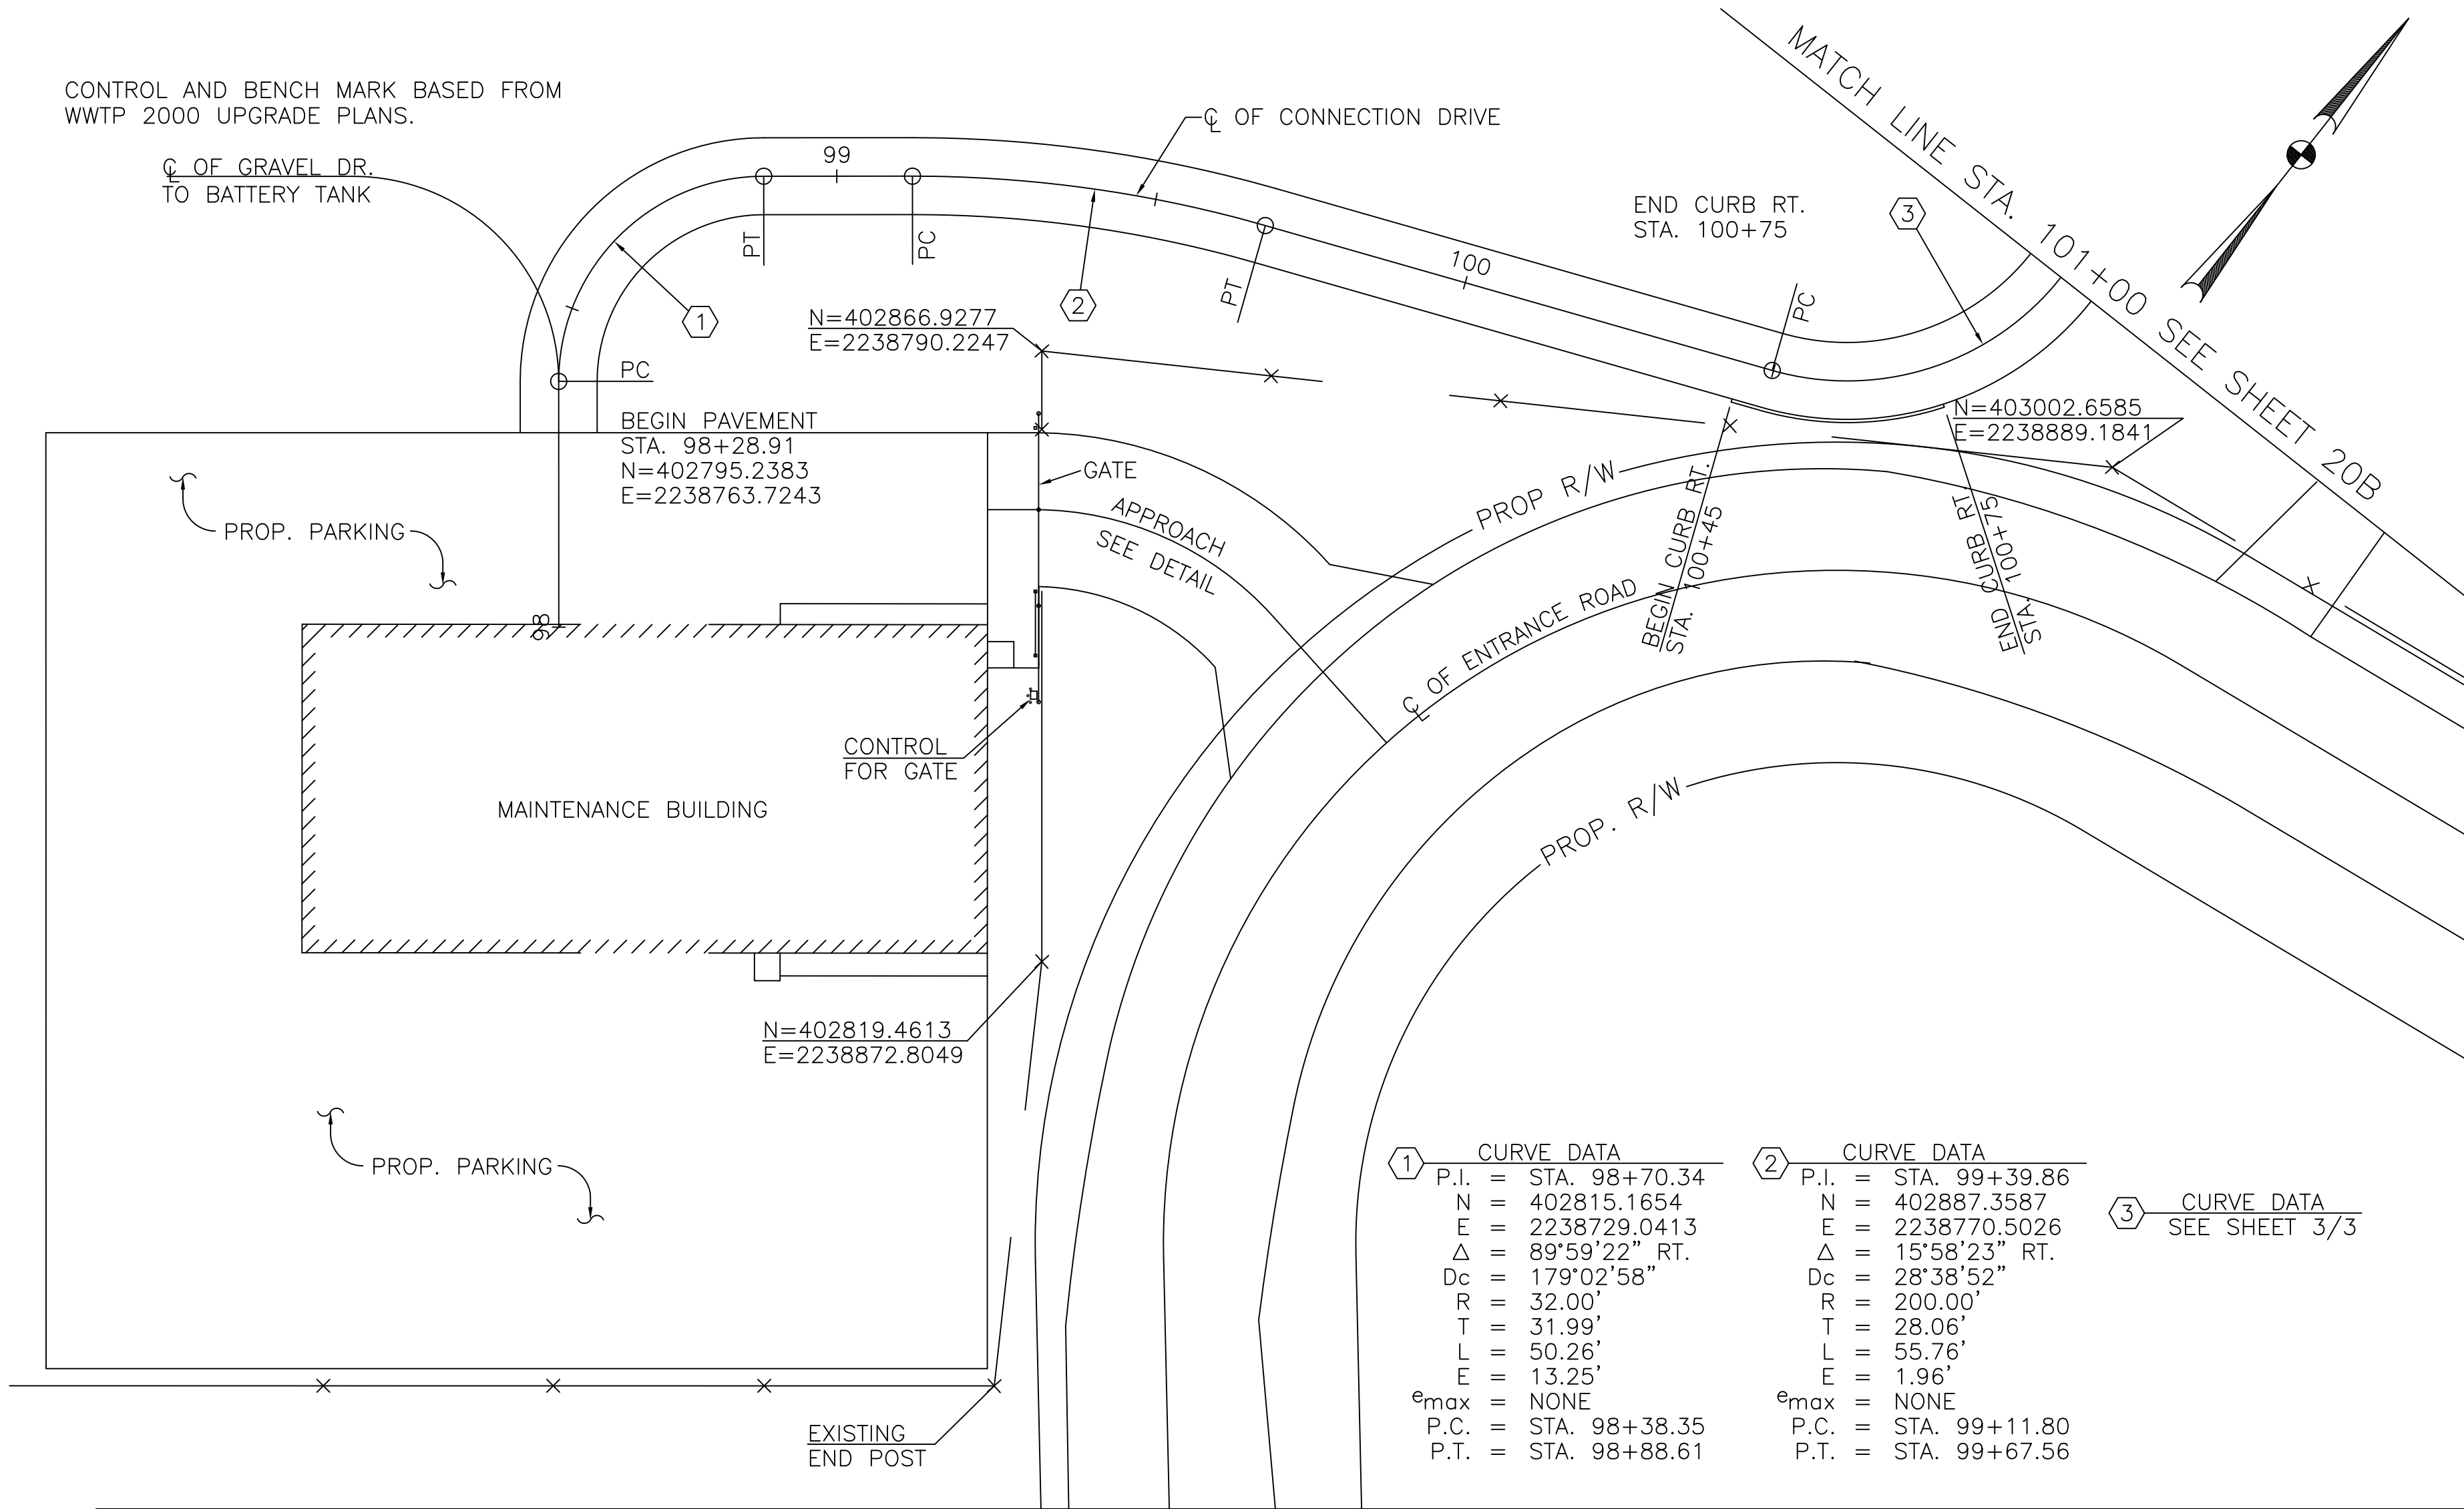

REF.	NORTH	EAST	ELEVATION
1	402901.7227	2238852.2244	132.65
2	402889.2635	2238841.4753	133.18
3	402878.7367	2238817.9134	134.01
4	402859.5291	2238800.6782	134.84
5	402883.0923	2238870.0209	N/A
6	402879.9908	2238855.5063	132.90
7	402877.5285	2238843.9829	133.19
8	402869.0390	2238824.9813	133.74
9	402853.5491	2238811.0820	134.24
10	402859.2069	2238862.7749	134.38
11	402865.7934	2238846.4905	133.10
12	402859.5593	2238832.3514	133.66
13	402848.2112	2238821.8633	134.65
14	402841.8799	2238832.8606	134.75
15	402838.5000	2238830.8148	134.96
16	402840.5457	2238827.3615	134.92
17	402836.9925	2238825.3158	135.00
18	402839.9312	2238820.2113	134.94

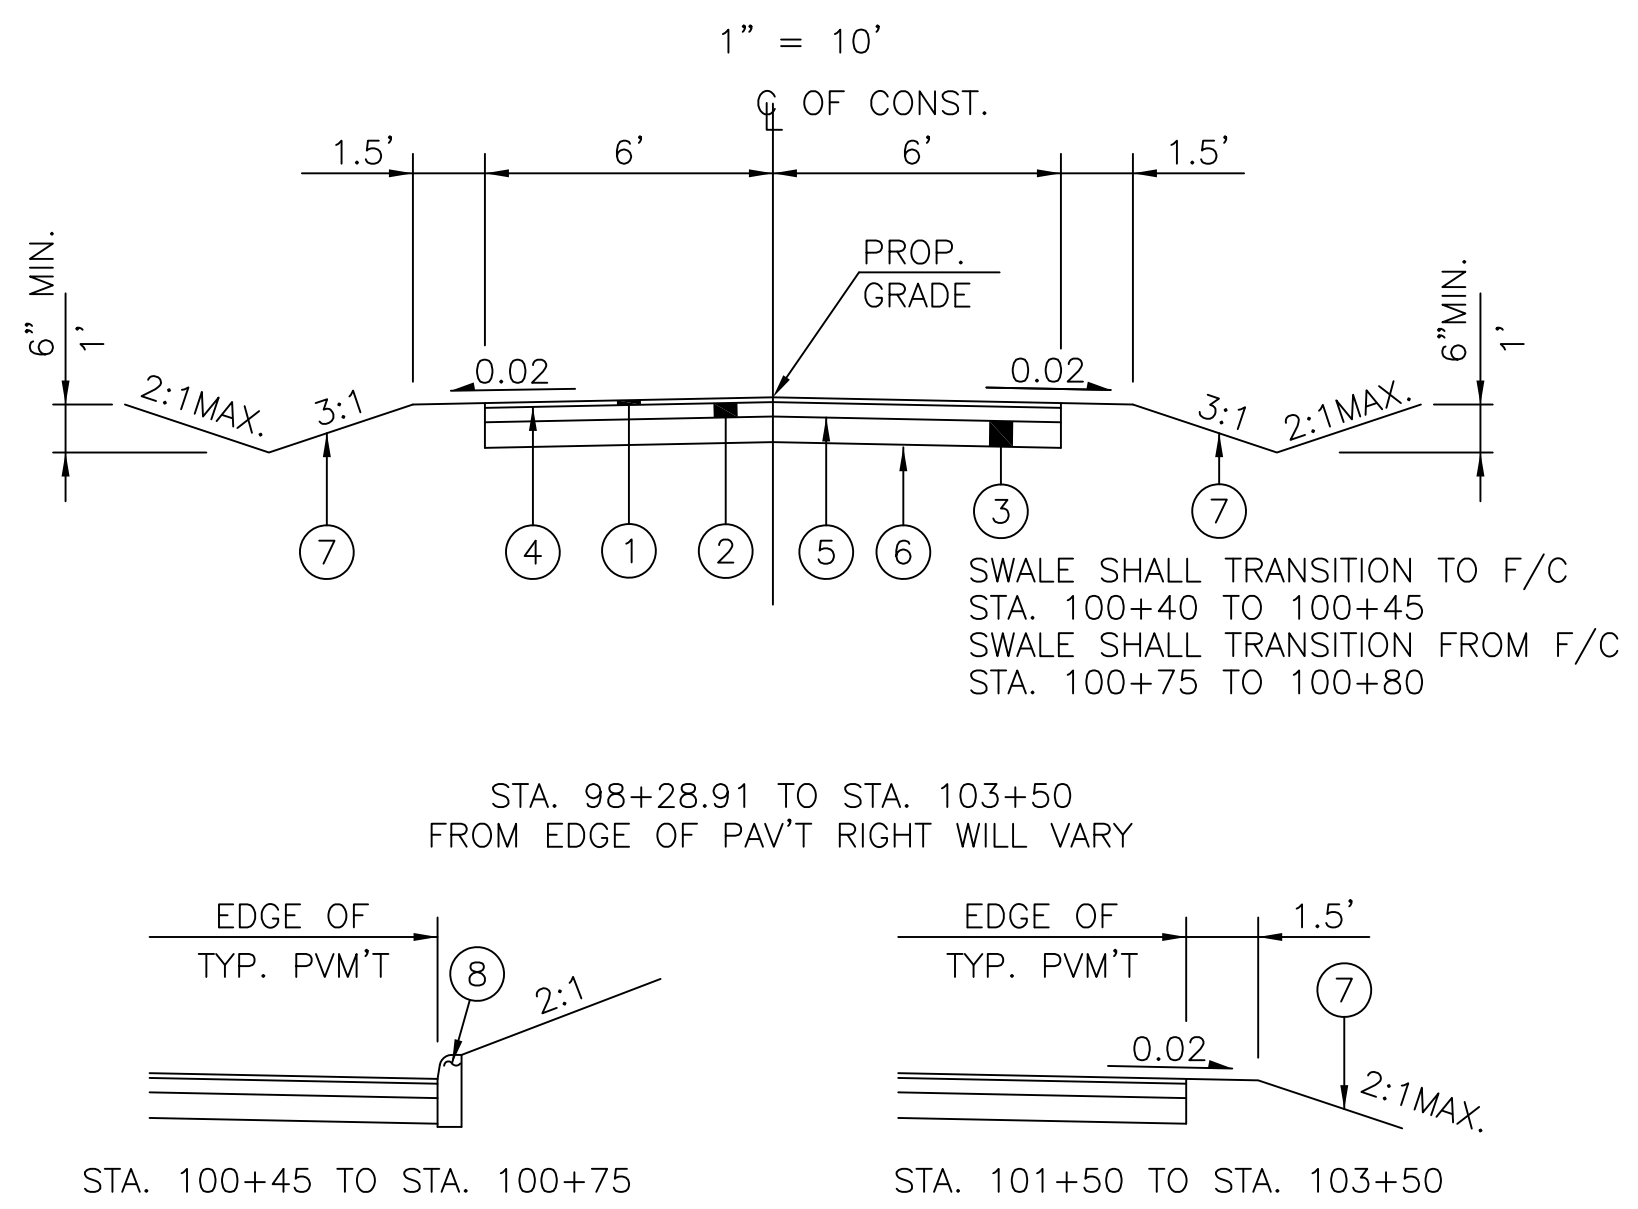

- 1 - ITEM 404-1 1/2" ASPHALT CONCRETE
- 2 - ITEM 402-4 1/2" ASPHALT CONCRETE
- 3 - ITEM 304-8" AGGREGATE BASE
- 4 - ITEM 407-TACK COAT
- 5 - ITEM 408-PRIME COAT
- 6 - ITEM 203-SUBGRADE COMPACTION
- 7 - ITEM 659-SEEDING AND MULCHING
- 8 - ITEM 609-TYPE 6 CONCRETE CURB

THESE RECORD DOCUMENTS HAVE BEEN PREPARED
BASED ON INFORMATION PROVIDED BY OTHERS. CTI
ENVIRONMENTAL HAS REVIEWED THE INFORMATION
SUBMITTED AND BELIEVES IT REFLECTS THE WORK AS
CONSTRUCTED. HOWEVER, ALL PERSONS SHALL
VERIFY INFORMATION TAKEN FROM THIS DRAWING.

THIS DRAWING IS AN INSTRUMENT OF SERVICE OWNED
BY CTI ENVIRONMENTAL, INC. WHICH SHALL BE DEEMED
TO BE THE PROPERTY OF CTI ENVIRONMENTAL, INC.
AND COMMON LAW RIGHTS, INCLUDING COPYRIGHTS,
THIS DRAWING SHALL NOT BE SCANNED, COPIED, OR
REPRODUCED IN ANY MANNER WITHOUT THE WRITTEN
CONSENT OF CTI ENVIRONMENTAL, INC. ANY
OTHER PURPOSE OR PROJECT WITHOUT PRIOR
WRITTEN CONSENT OF CTI ENVIRONMENTAL, INC.
ELECTRONIC COPIES OF THIS DRAWING ARE EXACT
IN THE EVENT OF A DISCREPANCY BETWEEN AN ELECTRONIC
COPY AND THE SEALED ORIGINAL, THE SEALED ORIGINAL
SHALL GOVERN.

DESIGNED BY		REVISIONS			
FFW	NO.	DESCRIPTIONS	DATE	BY	APP'D
DRAWN BY	1	ADDENDUM NO. 2	10/18	AJP	WAD
FFW	2	RECORD DRAWING	12/15	RWR	WAD
CHECKED BY					
SDH					
APPROVED BY					
SDH					

ENVIRONMENTAL, INC.
ENGINEERS IN WATER AND EARTH SCIENCES
UNIONTOWN, OHIO

CITY OF MASSILLON, OHIO
WWTP UPGRADE 2000
INTRAPLANT ACCESS ROAD (CART PATH)
PLAN & PROFILE

JOB NO. E9031
DATE 8/13/01
SCALE 1"=20'
SHEET C20A