

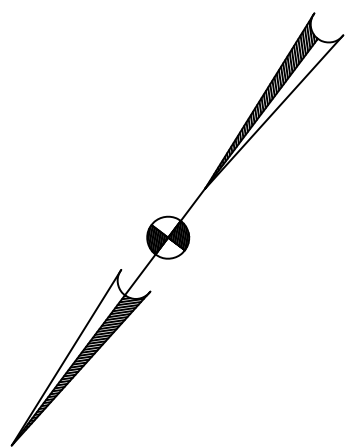
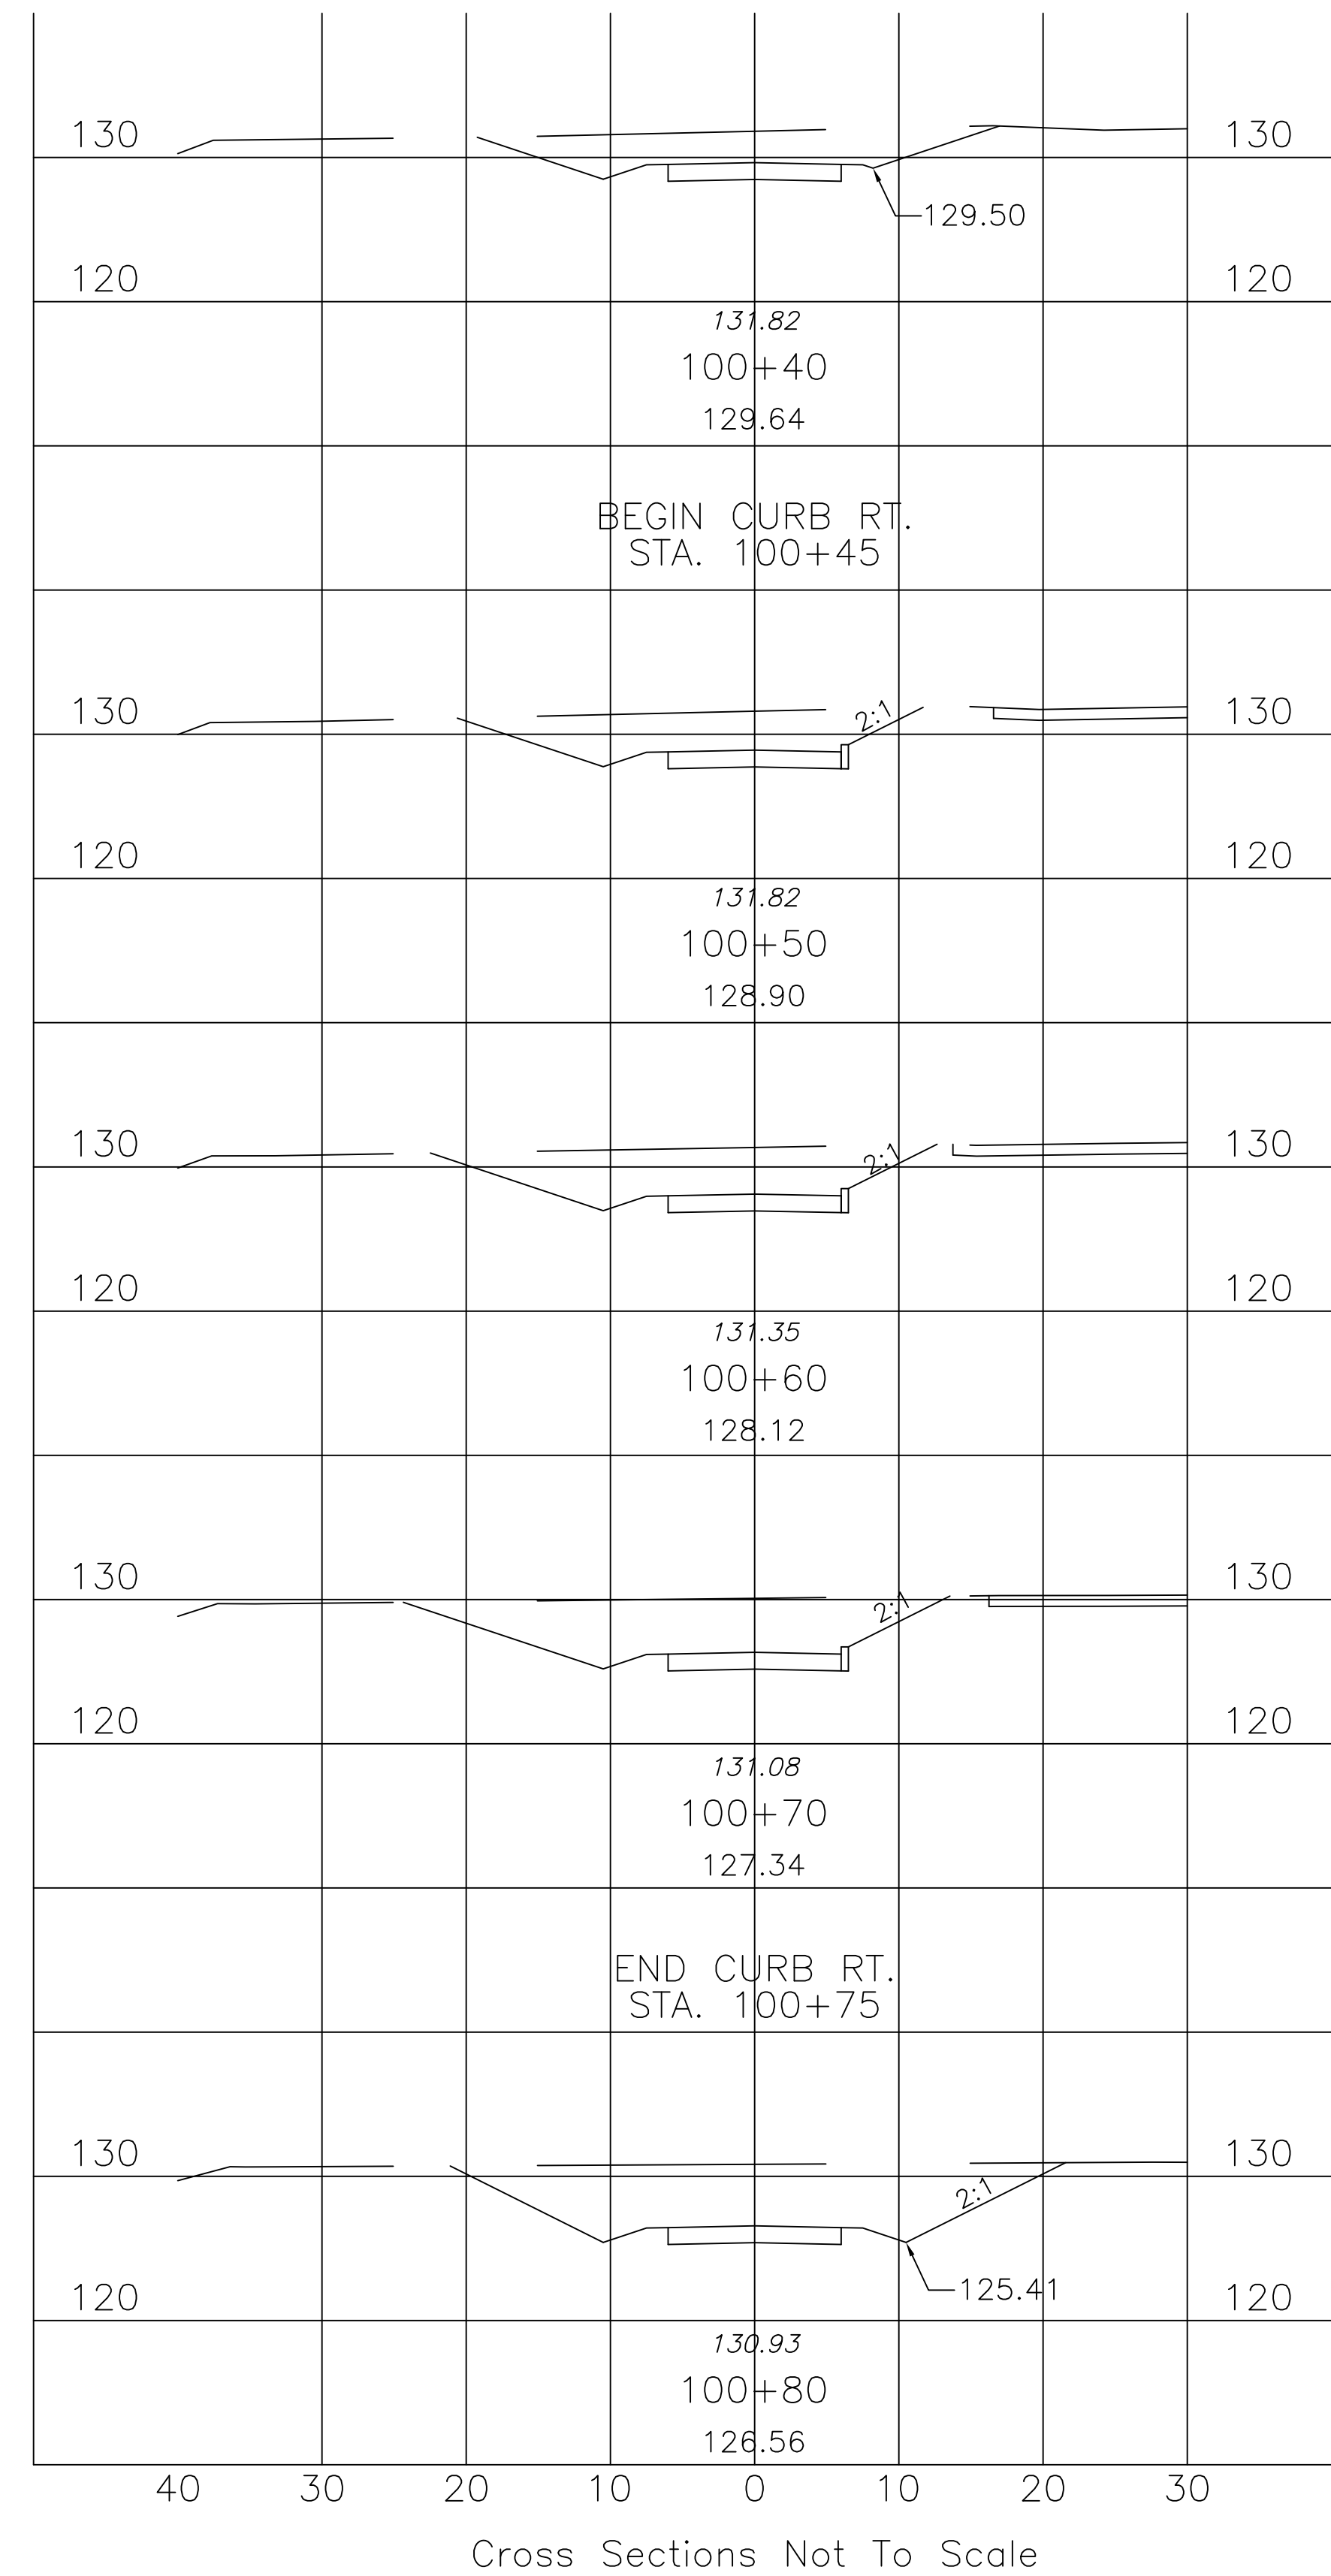


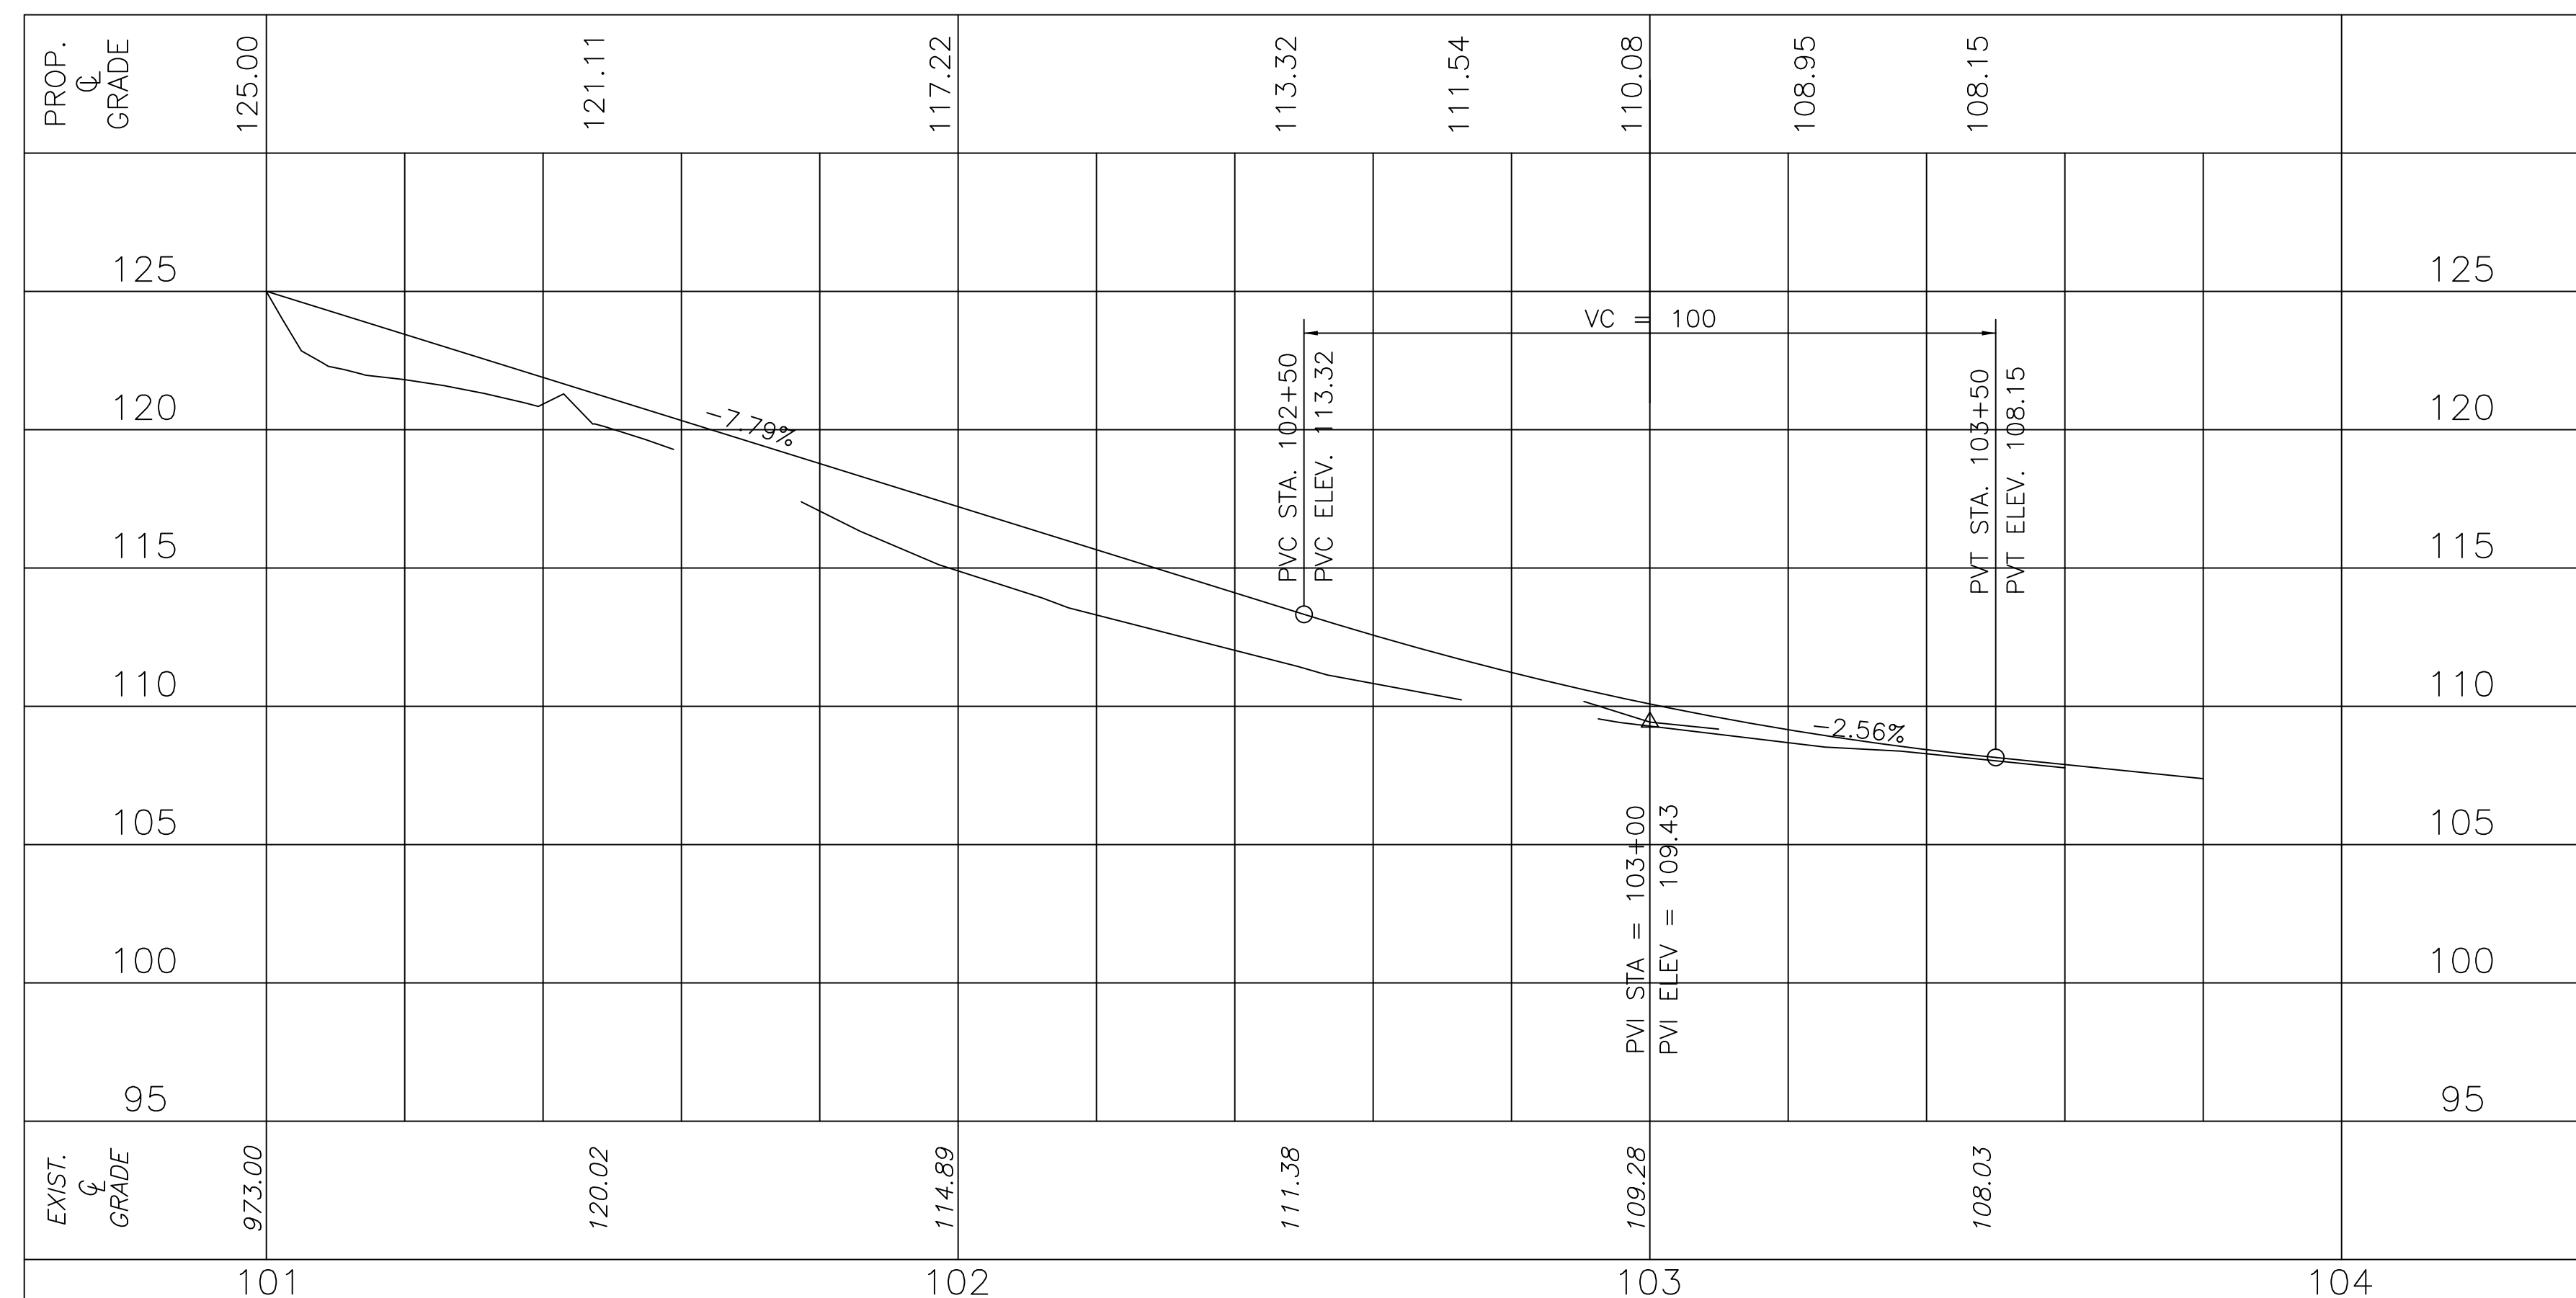

CURVE DATA	
P.I. =	STA. 104+82.28
Δ =	168°46'30" LT.
Dc =	134°48'49"
R =	42.50'
T =	432.48
L =	125.19
E =	392.06'
e_{max} =	NONE
P.C. =	STA. 100+49.80
P.T. =	STA. 101+75.00

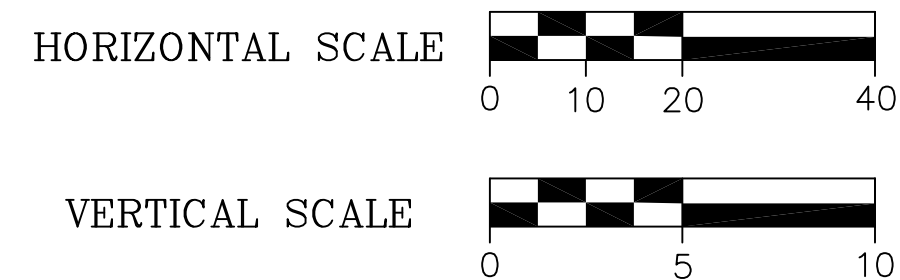

THESE RECORD DOCUMENTS HAVE BEEN PREPARED
BASED ON INFORMATION PROVIDED BY OTHERS. CTI
ENVIRONMENTAL HAS REVIEWED THE INFORMATION
SUBMITTED AND BELIEVES IT REFLECTS THE WORK AS
CONSTRUCTED. HOWEVER, ALL PERSONS SHALL
VERIFY INFORMATION TAKEN FROM THIS DRAWING.

THIS DRAWING IS AN INSTRUMENT OF SERVICE OWNED BY CITI ENVIRONMENTAL, INC. WHICH SHALL BE DEEMED TO BE THE PROPERTY OF CITI ENVIRONMENTAL, INC. FOR ALL COMMON LAW RIGHTS INCLUDING COPYRIGHT. THIS DRAWING SHALL NOT BE SCANNED, COPIED, OR DISTRIBUTED TO OTHERS IN ANY FORM OR USED FOR ANY OTHER PURPOSE OR PROCEDURE WITHOUT PRIOR WRITTEN CONSENT OF CITI ENVIRONMENTAL, INC. THAT CITI ENVIRONMENTAL, INC. CANNOT GUARANTEE THAT ELECTRONIC COPIES OF THIS DRAWING ARE EXACT REPRODUCTIONS OF THE SEALED ORIGINAL DRAWING. THIS USE OF THE SEALED ORIGINAL DRAWING, ELECTRONIC COPY AND THE SEALED ORIGINAL, THE SEALED ORIGINAL SHALL COVER.

DESIGNED BY		REVISIONS			
FPW		NO.	DESCRIPTIONS	DATE	BY
DRAWN BY		1	ADDENDUM NO 2	10/18	AJP
FPW		2	RECORD DRAWING	12/15	RWR
CHECKED BY					
SDH					
APPROVED BY					
SDH					

CF ENVIRONMENTAL, INC.
ENGINEERS IN WATER AND EARTH SCIENCES
UNIONTOWN, OHIO

CITY OF MASSILLON, OHIO
WWTP UPGRADE 2000
INTRAPLANT ACCESS ROAD (CART PATH)
PLAN, PROFILE & SECTIONS

JOB NO. E9031
DATE 8/13/01
SCALE 1"=20'
SHEET C20B