



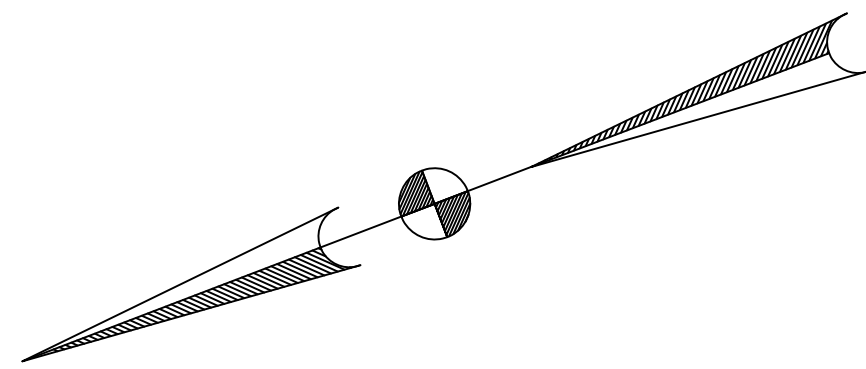

KEY

- ① C/L 14"=71.08
- ② C/L 14"=64.82
- ③ C/L 42"=69.00
- ④ C/L 42"=68.00
- ⑤ C/L 18"-90° BEND=68.00

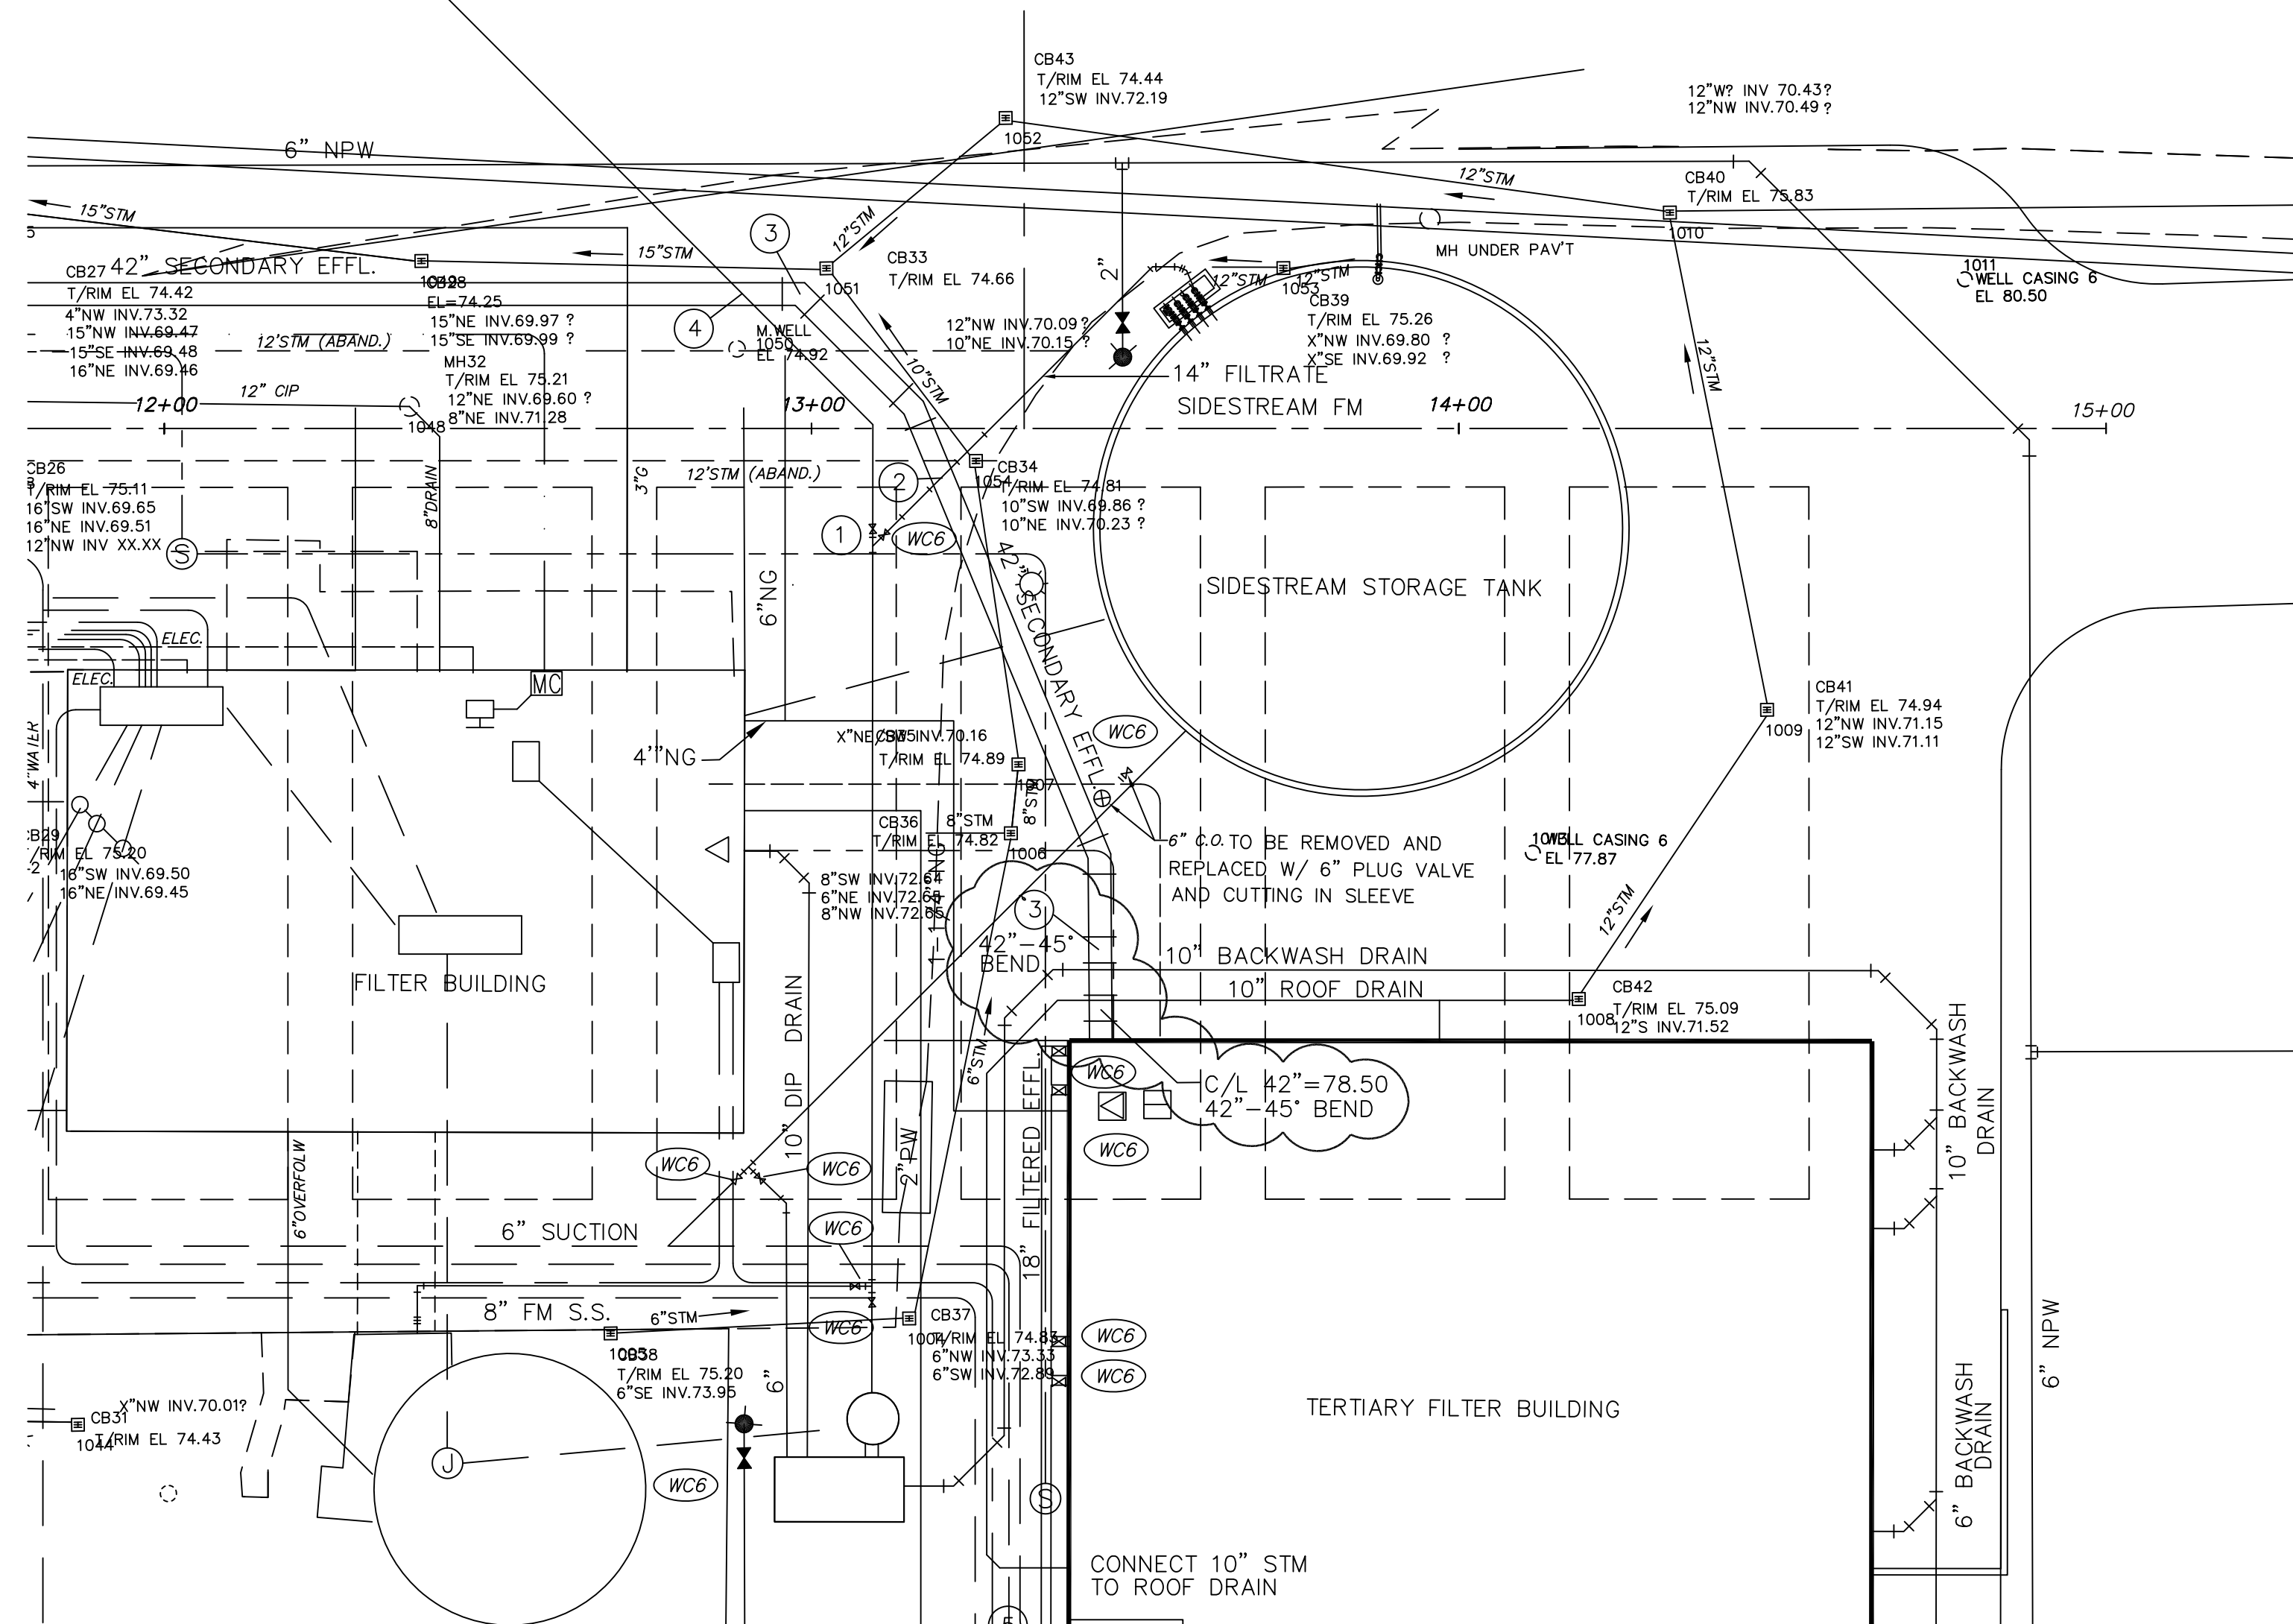

ADDENDUM NO. 3

CITY OF MASSILLON, OHIO
WWTP UPGRADE 2000
TERTIARY FILTERS



SK-C28-001