


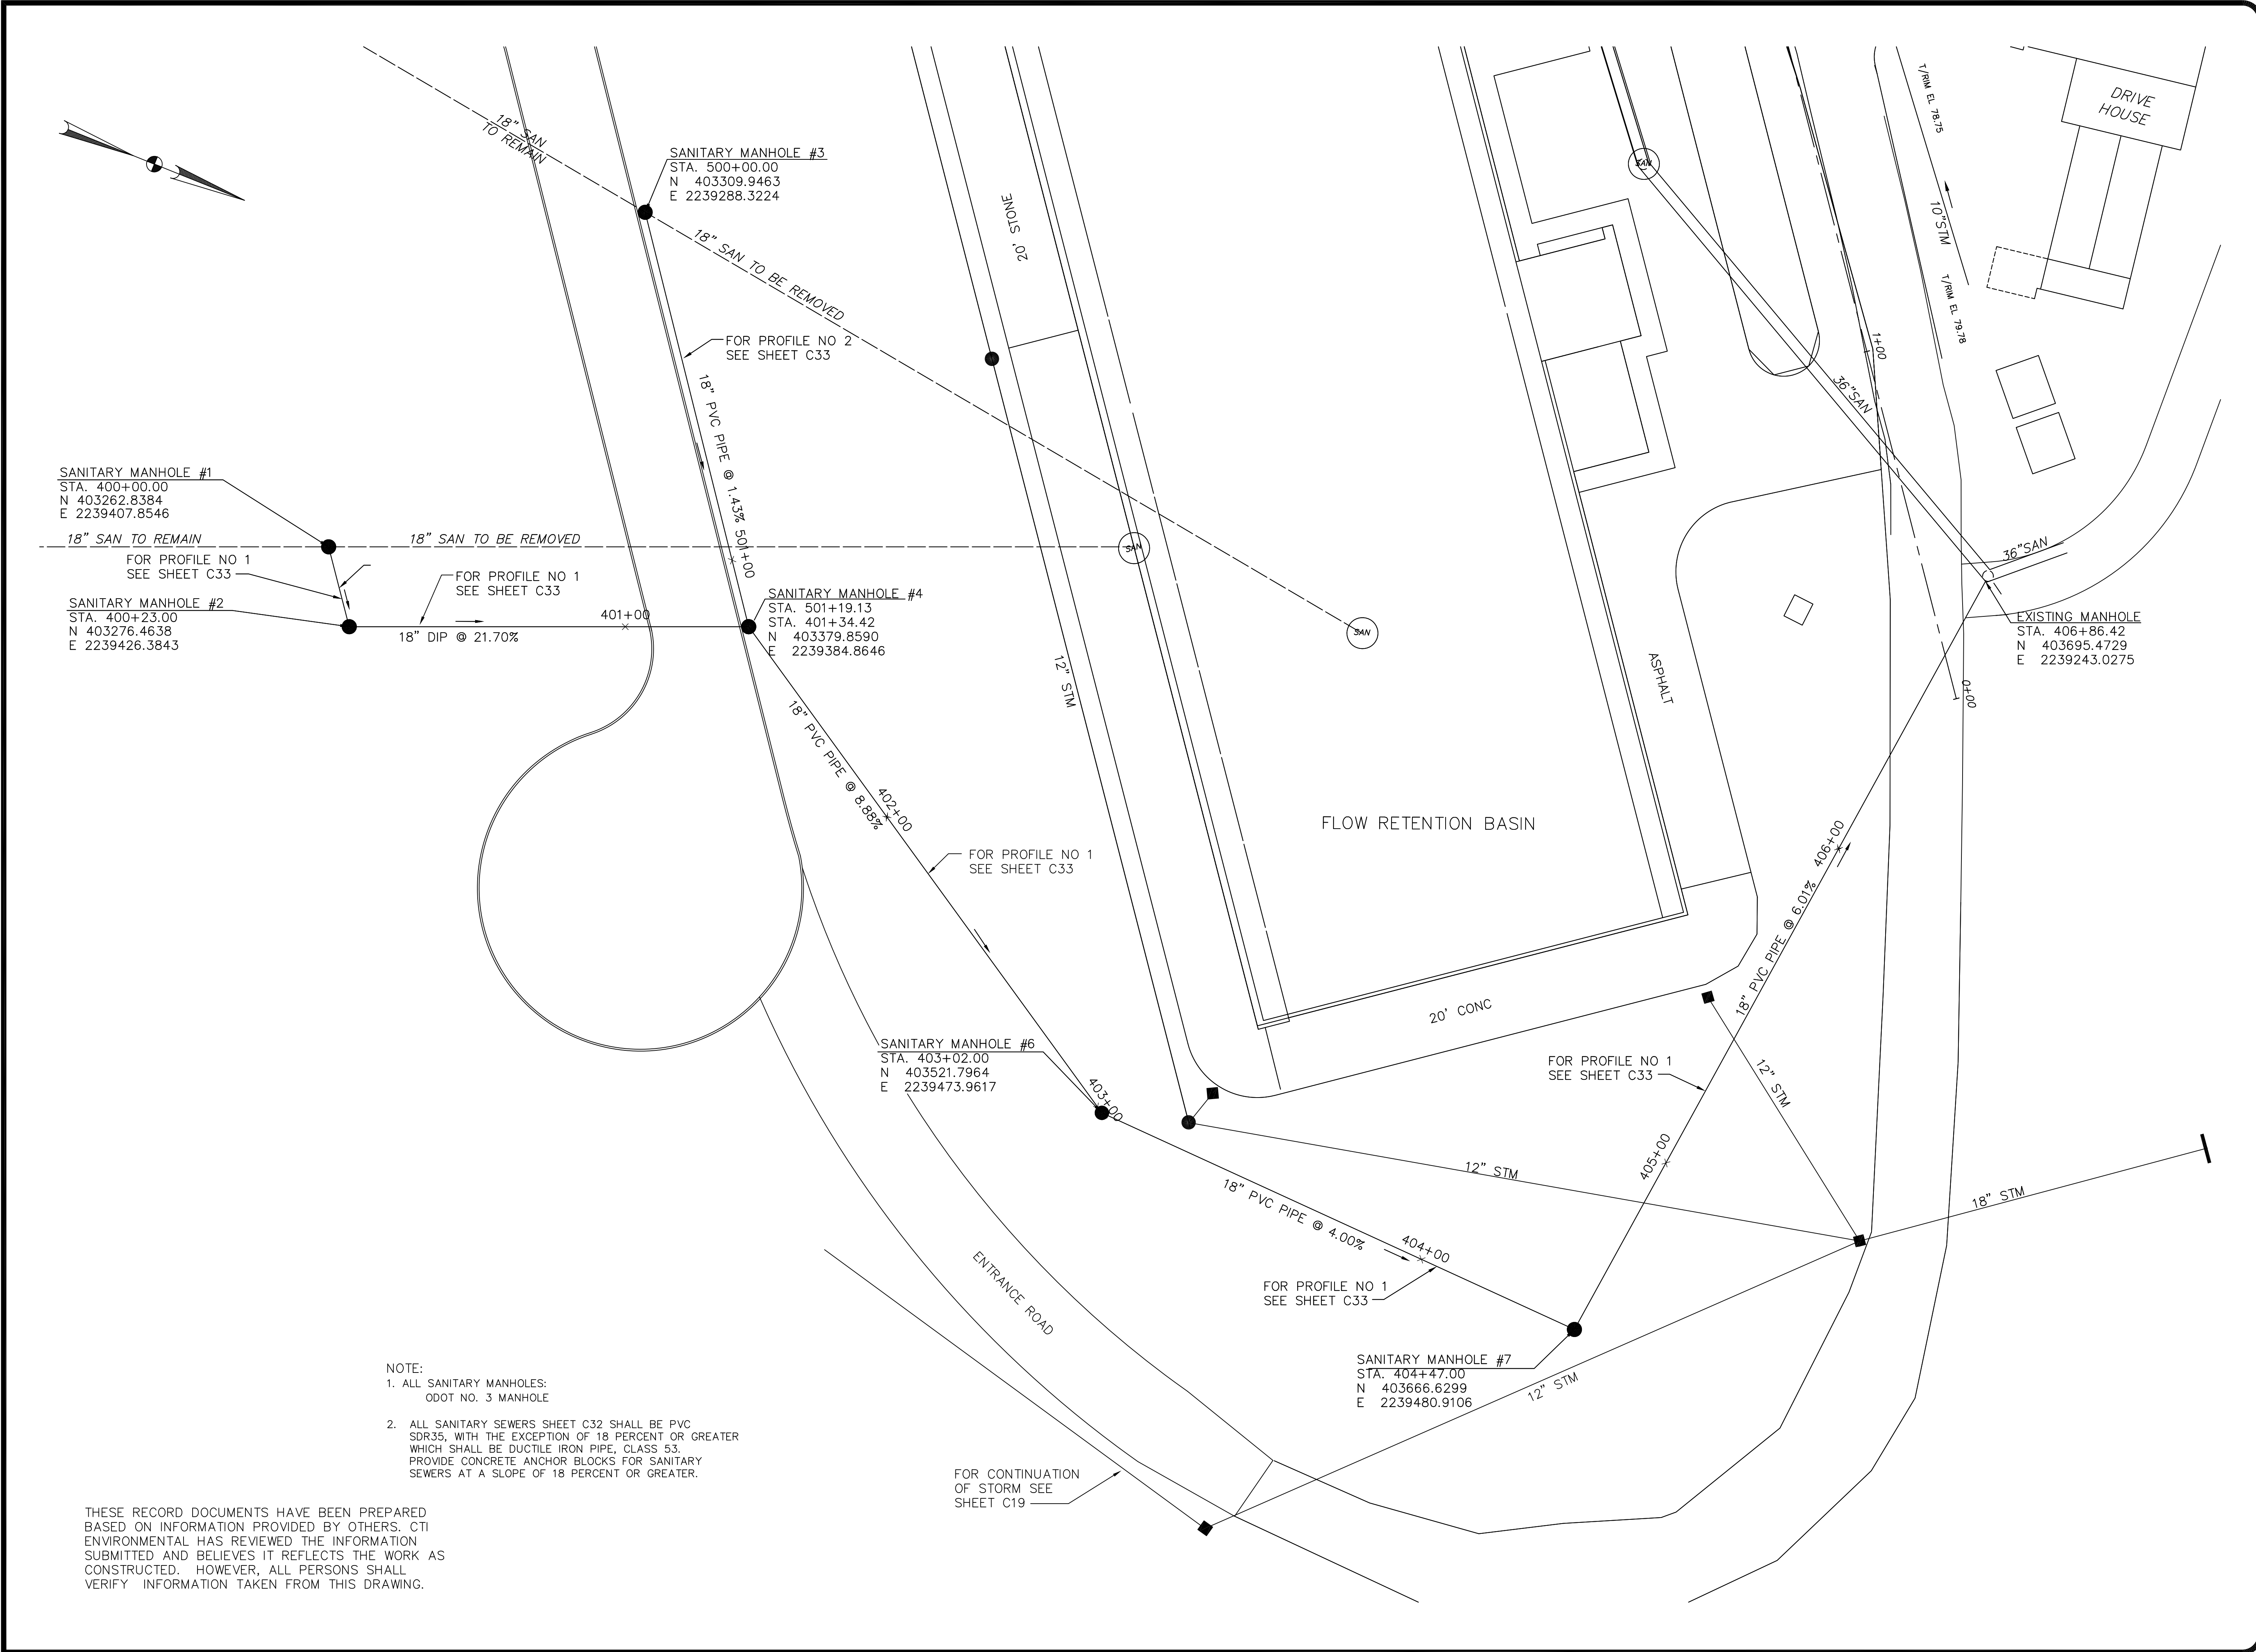

THIS DRAWING IS AN INSTRUMENT OF SERVICE OWNED BY CTI ENVIRONMENTAL, INC. WHICH SHALL BE DEMONSTRATED TO THE CLIENT BY THE SIGNATURE OF THE ENGINEER. THIS DRAWING SHALL NOT BE REPRODUCED, COPIED, OR ANY OTHER PURPOSE OR PROJECT WITHOUT THE WRITTEN CONSENT OF CTI ENVIRONMENTAL, INC. ELECTRONIC COPIES OF THIS DRAWING ARE EXACT IN THE EVENT OF A CONFLICT BETWEEN AN ELECTRONIC COPY AND THE SEALED ORIGINAL THE SEALED ORIGINAL SHALL GOVERN.

NO.	DESCRIPTIONS	DATE	BY	APP'D
1	ADDENDUM NO. 2	9/21	AJP	WAD

DESIGNED BY	NO.	DESCRIPTIONS	DATE	BY	APP'D
AJP	1	ADDENDUM NO. 2	9/21	AJP	WAD
DRAWN BY					
AJP					
CHECKED BY					
WAD					
APPROVED BY					
WAD					



ENVIRONMENTAL, INC.
ENGINEERS IN WATER AND EARTH SCIENCES
UNIONTOWN, OHIO

CITY OF MASSILLON, OHIO
WWTP UPGRADE 2000
SANITARY SEWER
PLAN

JOB NO. E9031
DATE 9/21/01
SCALE 1" = 20'
SHEET C32