



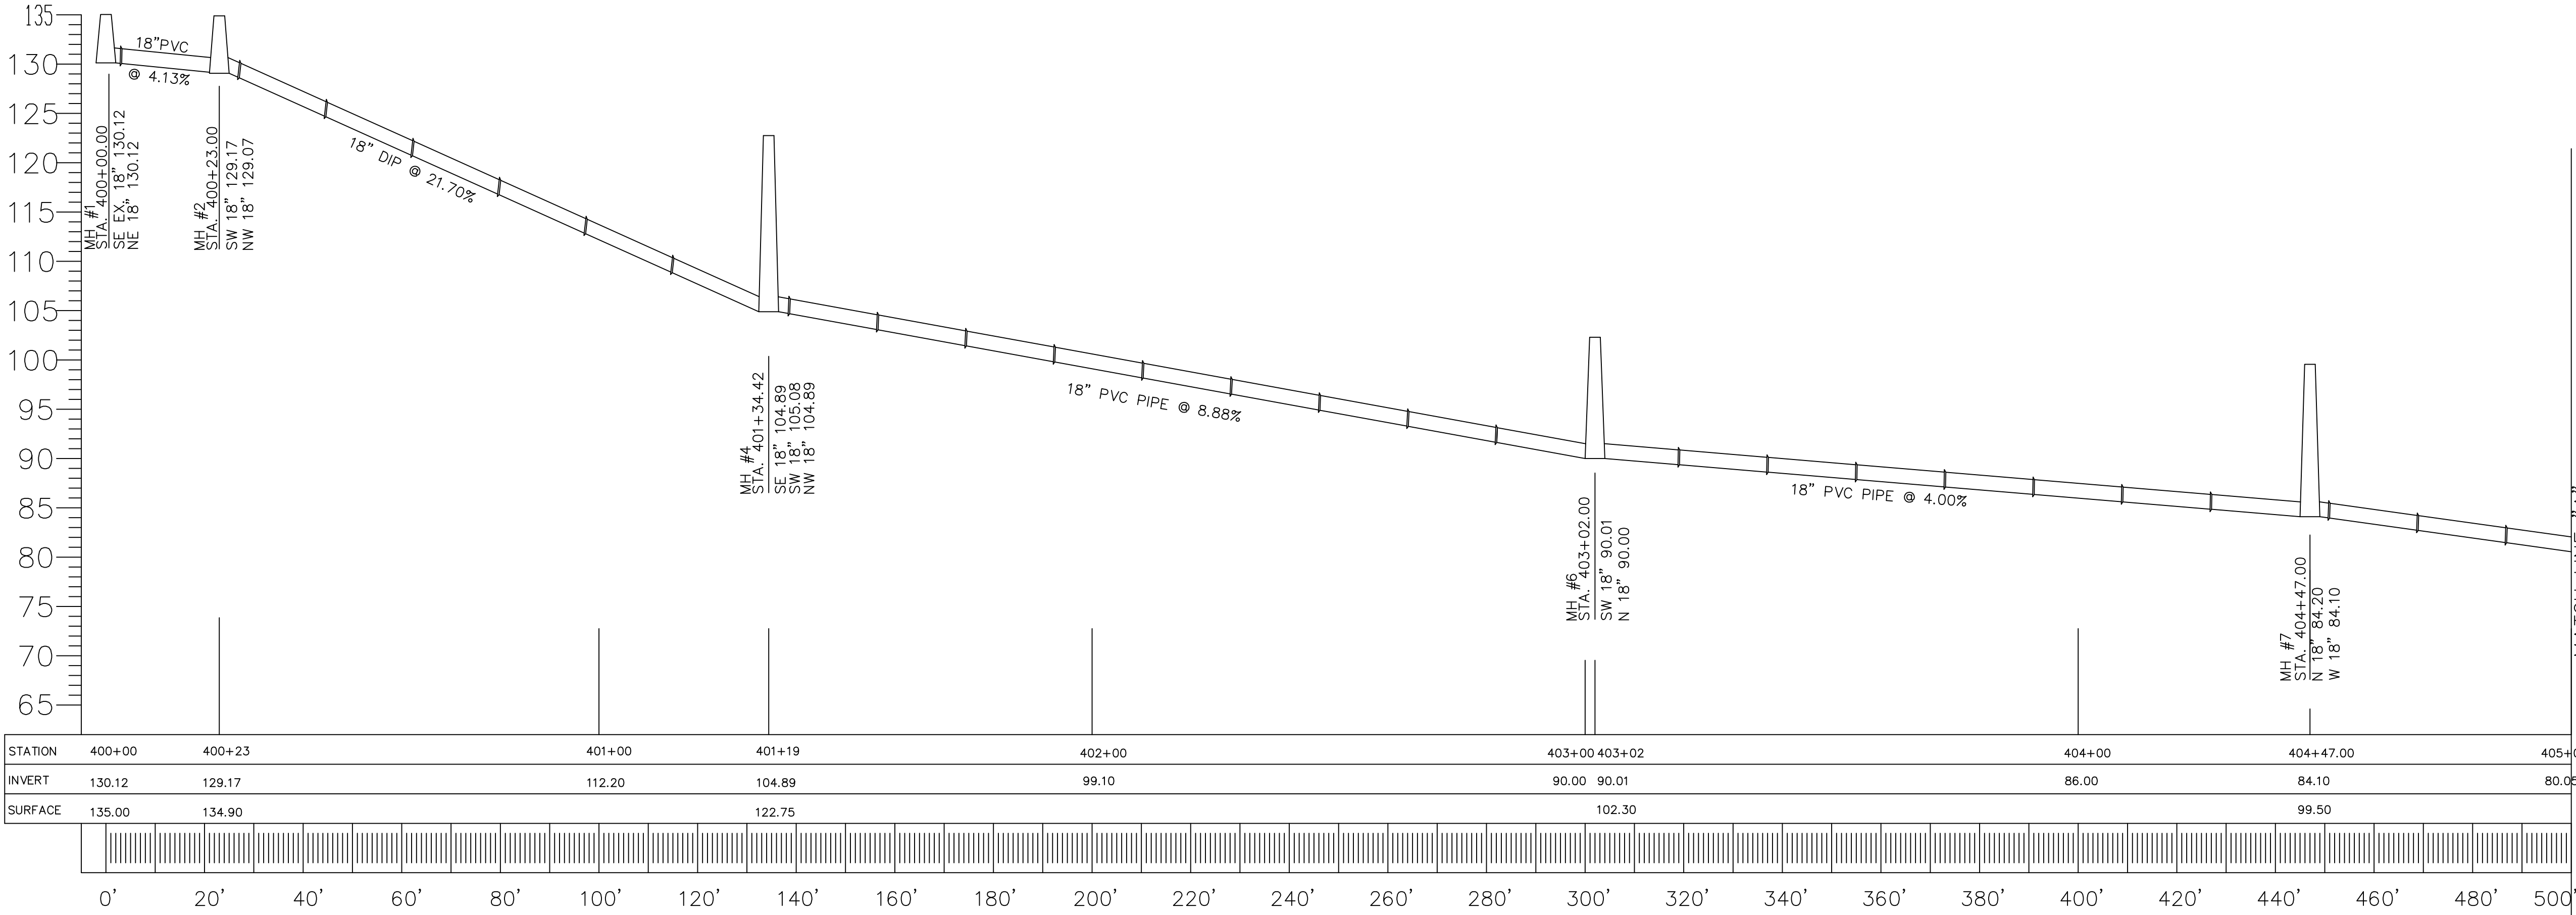


HORIZONTAL SCALE : 1" = 20'
VERTICAL SCALE : 1" = 10'

PROFILE 1

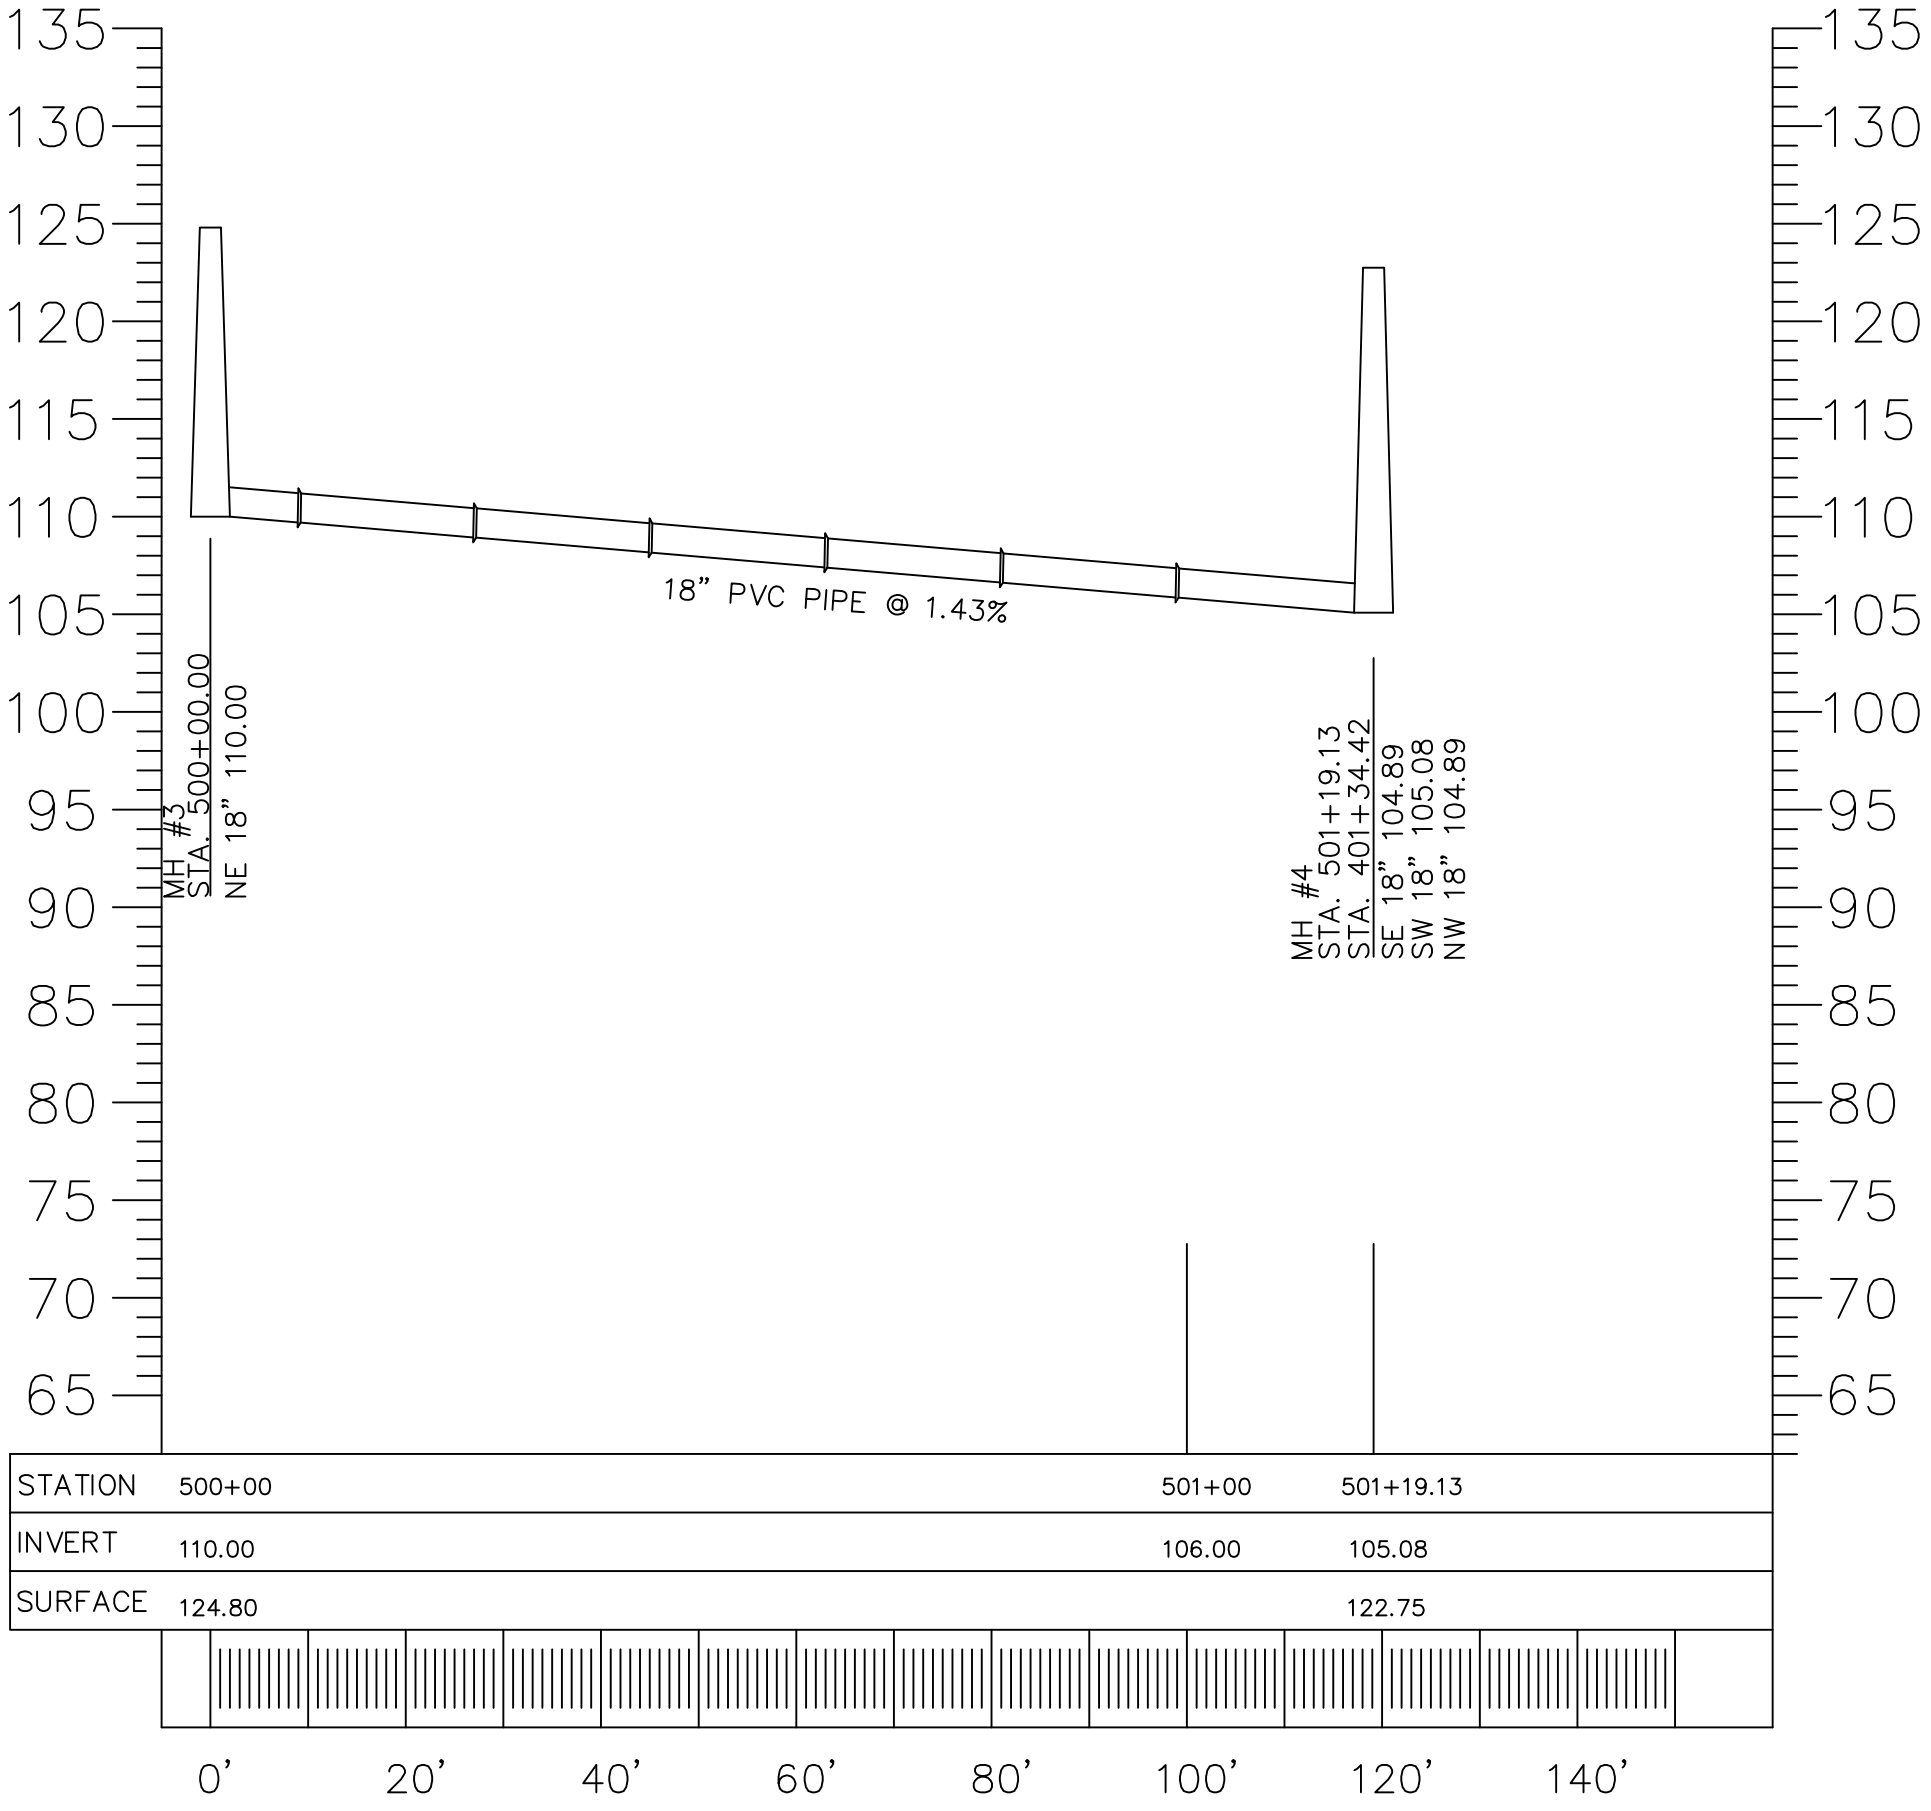

HORIZONTAL SCALE : 1" = 20'
VERTICAL SCALE : 1" = 10'

PROFILE 2

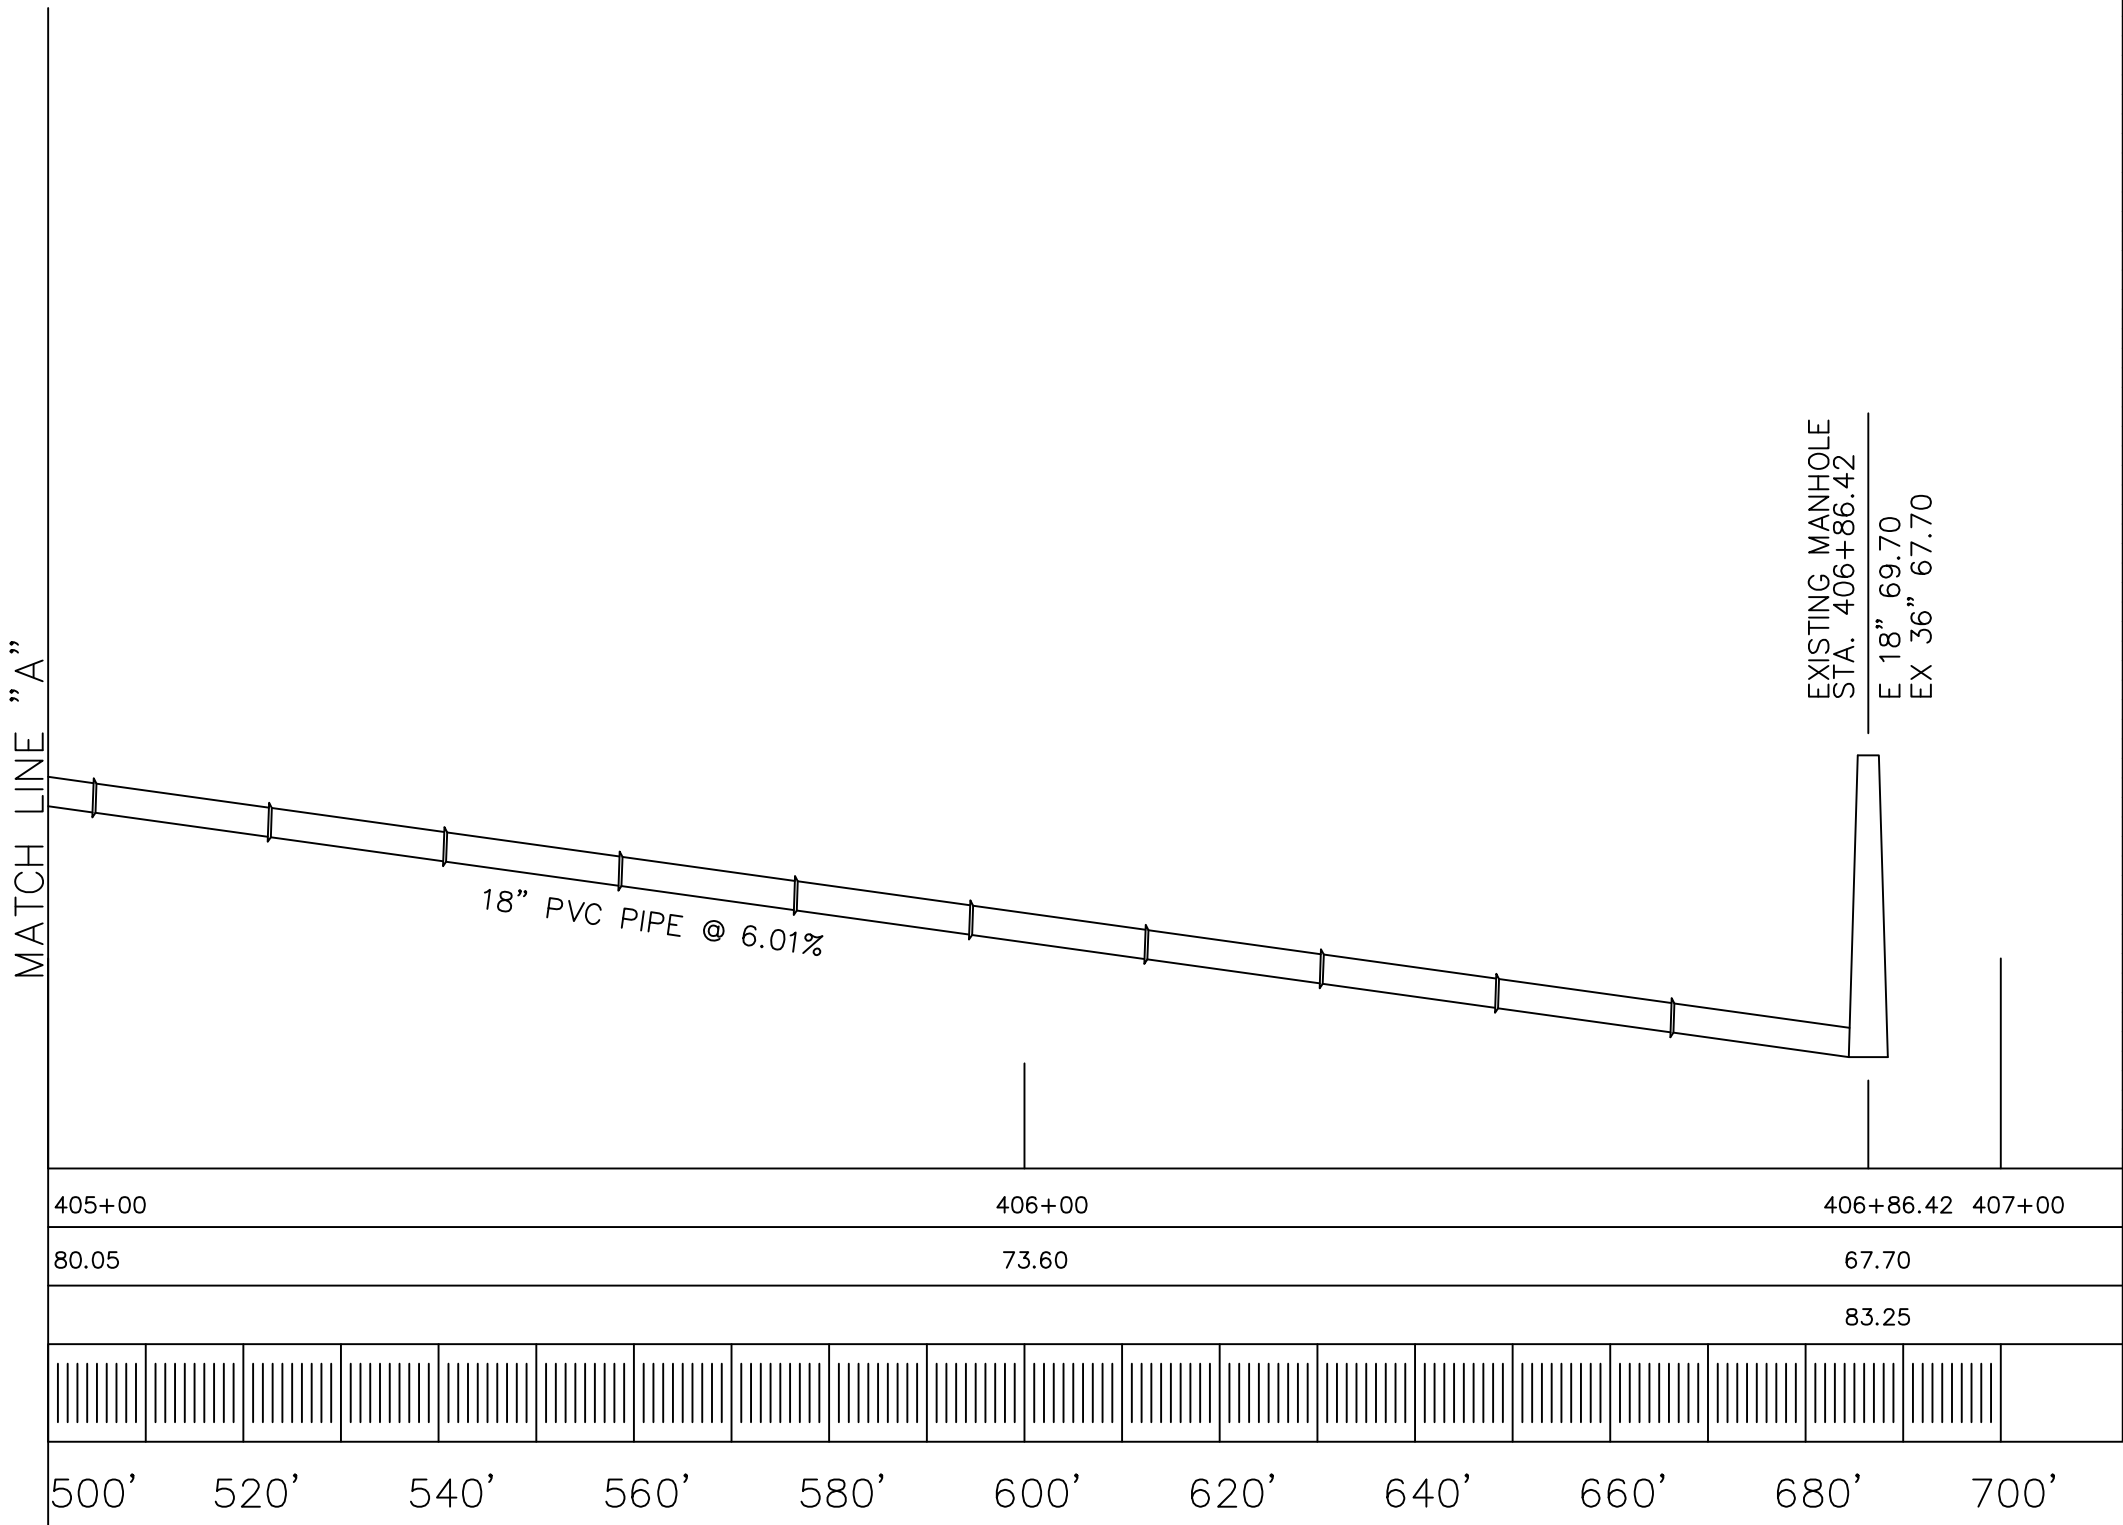

PROFILE 1 CONT.

THESE RECORD DOCUMENTS HAVE BEEN PREPARED
BASED ON INFORMATION PROVIDED BY OTHERS. CTI
ENVIRONMENTAL HAS REVIEWED THE INFORMATION
SUBMITTED AND BELIEVES IT REFLECTS THE WORK AS
CONSTRUCTED. HOWEVER, ALL PERSONS SHALL
VERIFY INFORMATION TAKEN FROM THIS DRAWING.

THIS DRAWING IS AN INSTRUMENT OF SERVICE OWNED
BY CTI ENVIRONMENTAL, INC. AND IS NOT TO BE
REPRODUCED OR TRANSMITTED IN ANY FORM OR BY
ANY MEANS, ELECTRONIC OR MECHANICAL, INCLUDING
PHOTOCOPYING, RECORDING, OR BY ANY INFORMATION
SYSTEMS WITHOUT THE WRITTEN PERMISSION OF
CTI ENVIRONMENTAL, INC. THE USER AGREES TO
INDemnify and hold CTI ENVIRONMENTAL, INC.
HARMLESS FROM AND AGAINST ALL CLAIMS, DAMAGES,
LOSSES, AND EXPENSES, INCLUDING ATTORNEY'S
FEES, IN THE EVENT OF A CONFLICT BETWEEN AN ELECTRONIC
DUPLICATE OF THIS DRAWING AND THE SEALED ORIGINAL
DRAWING. THE SEALED ORIGINAL DRAWING
SHALL GOVERN.

REVISIONS				
NO.	DESCRIPTIONS	DATE	BY	APPD
1	ADDENDUM NO 1	9/14	AJP	WAD
2	ADDENDUM NO 2	9/21	AJP	WAD
3	ADDENDUM NO 3	9/28	MCW	WAD

ENVIRONMENTAL, INC.
ENGINEERS IN WATER AND EARTH SCIENCES
UNIONTOWN, OHIO

CITY OF MASSILLON, OHIO
WWTP UPGRADE 2000
SANITARY SEWER
PROFILE

JOB NO. E9031
DATE 9/21/01
SCALE AS SHOWN
SHEET C33