


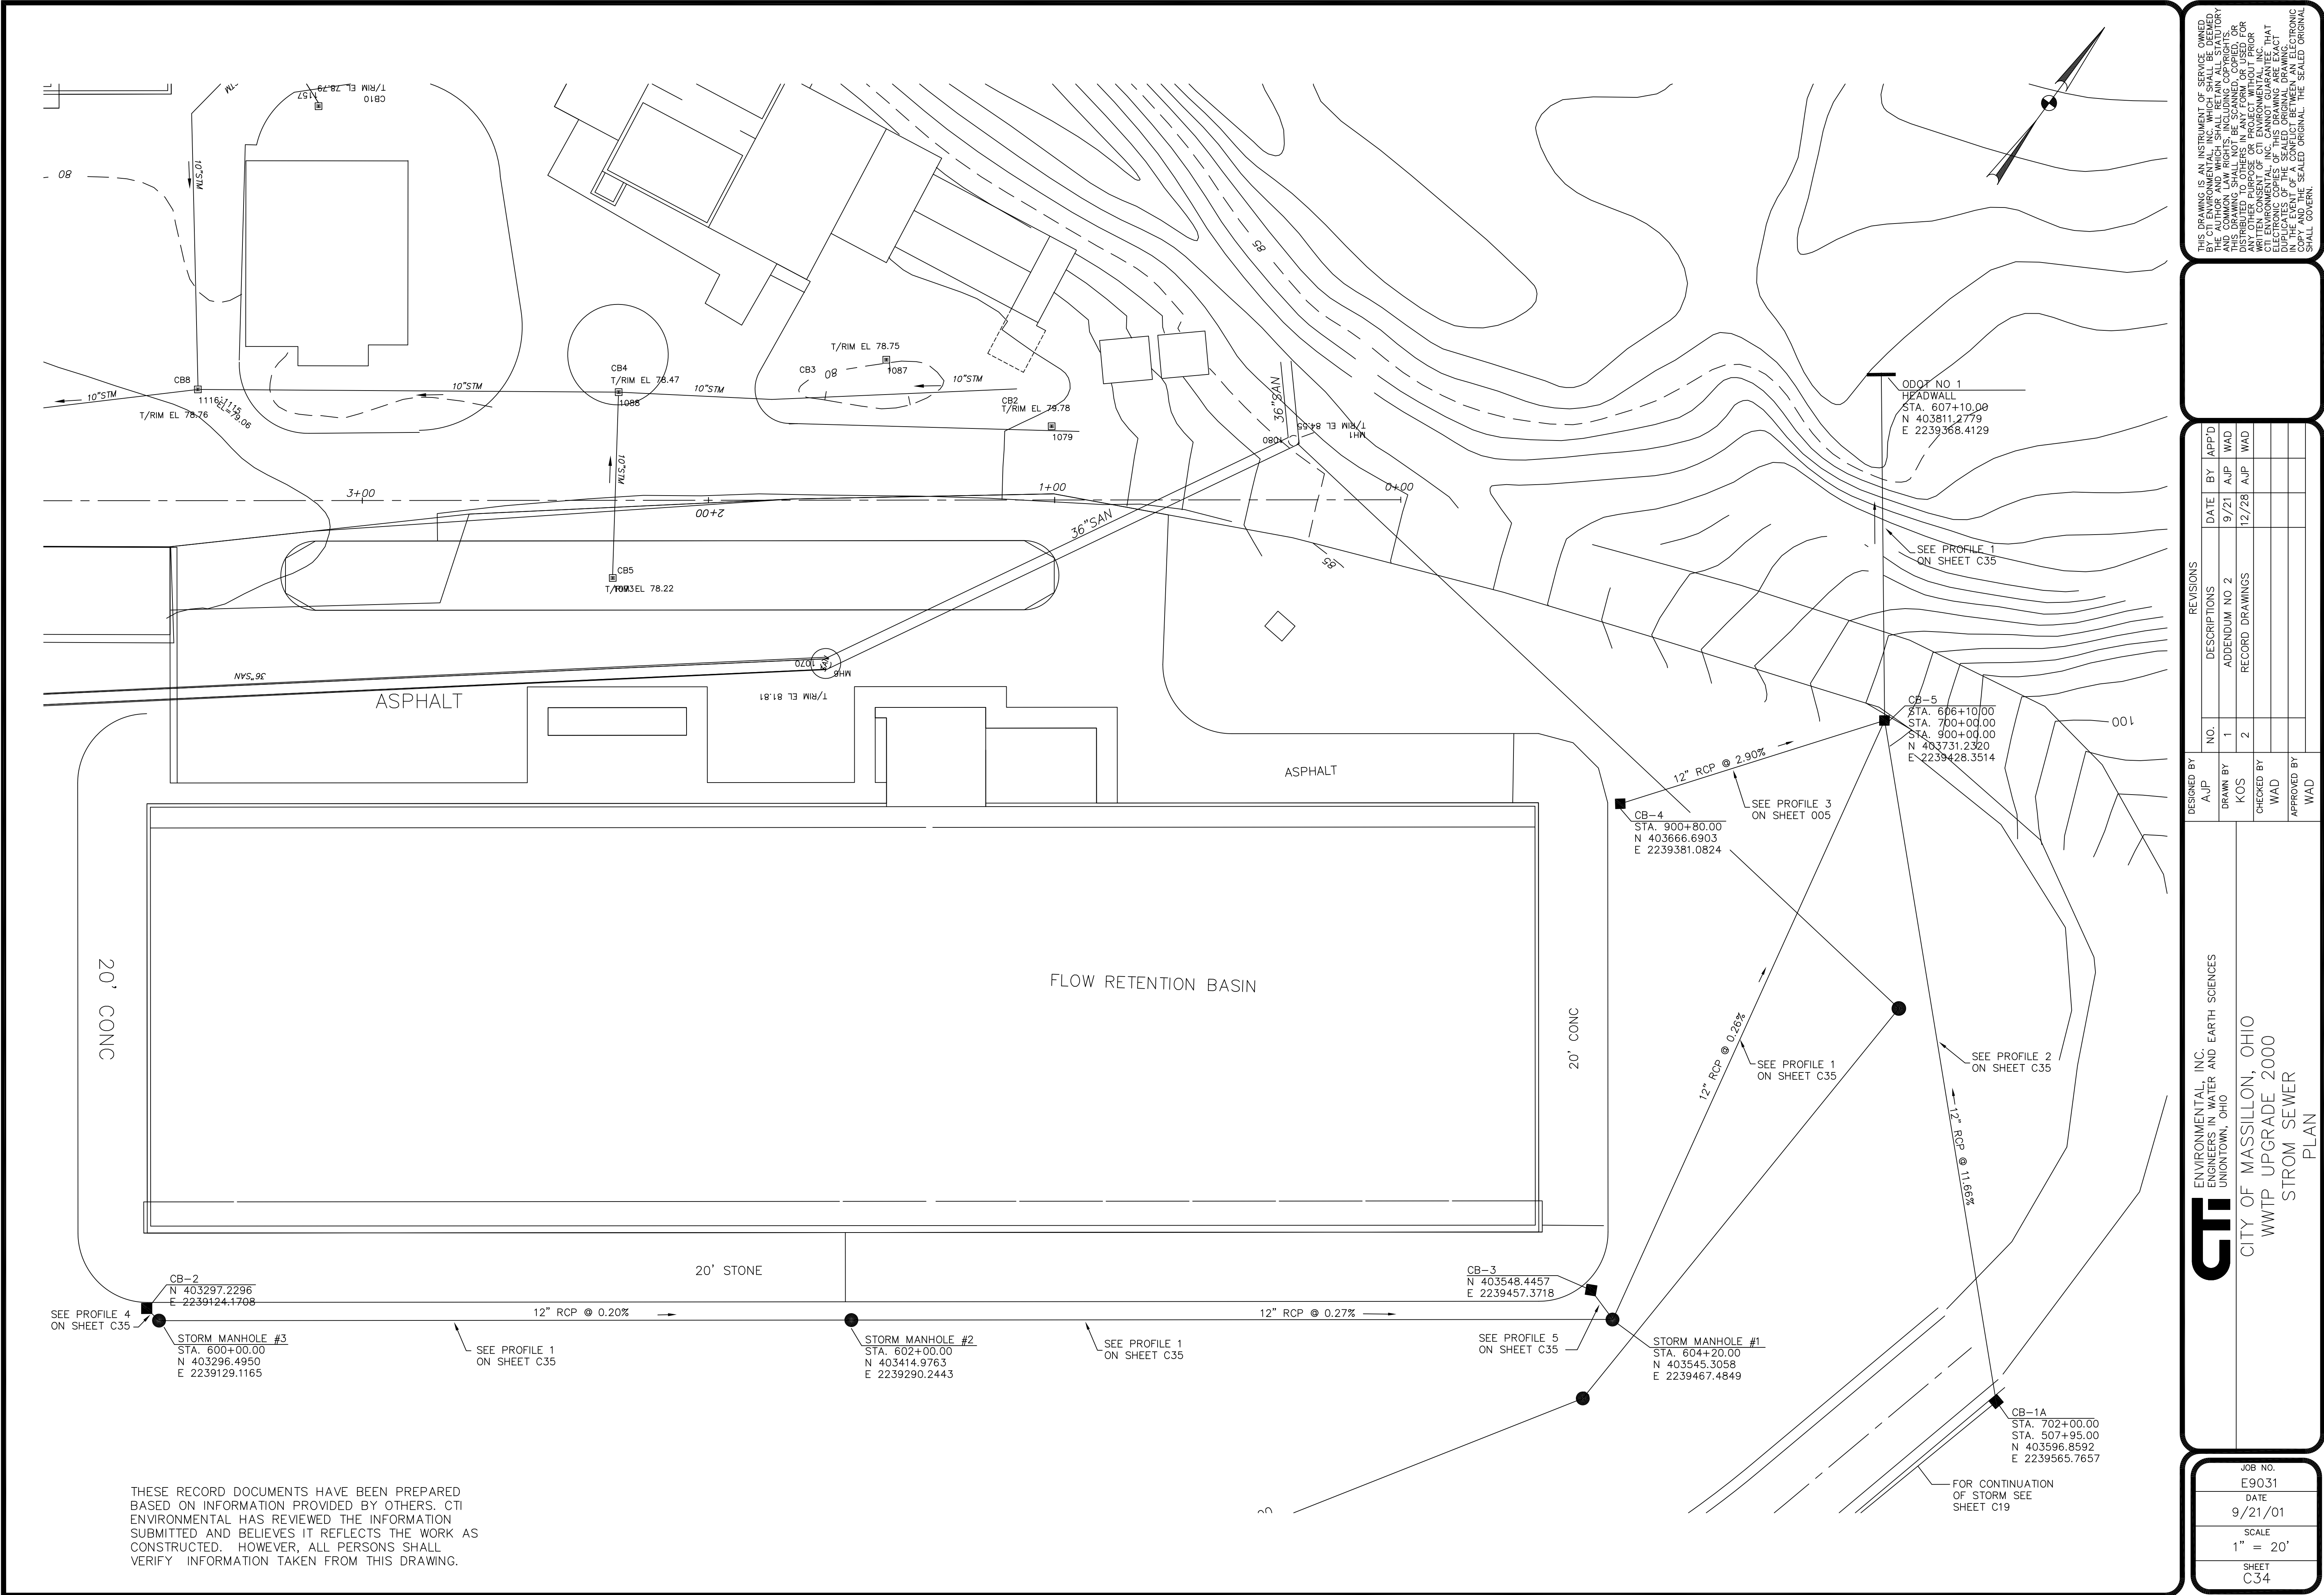

THIS DRAWING IS AN INSTRUMENT OF SERVICE OWNED BY CTI ENVIRONMENTAL, INC. WHICH SHALL BE DEMONSTRATED BY THE PROJECT. IT IS THE PROPERTY OF CTI ENVIRONMENTAL, INC. AND COMMON LAW RIGHTS, INCLUDING COPYRIGHTS, IN THIS DRAWING SHALL NOT BE SCANNED, COPIED, OR REPRODUCED IN ANY MANNER WITHOUT THE WRITTEN CONSENT OF CTI ENVIRONMENTAL, INC. ANY OTHER PURPOSE OR PROJECT WITHOUT PRIOR WRITTEN CONSENT OF CTI ENVIRONMENTAL, INC. IS PROHIBITED. ELECTRONIC COPIES OF THIS DRAWING ARE EXACT REPRODUCTIONS OF THE ORIGINAL DRAWING. IN THE EVENT OF A CONFLICT BETWEEN AN ELECTRONIC COPY AND THE SEALED ORIGINAL, THE SEALED ORIGINAL SHALL GOVERN.

REVISIONS			
NO.	DESCRIPTIONS	DATE	BY
1	ADDENDUM NO. 2	9/21	AJP
2	RECORD DRAWINGS	12/28	AJP
			WAD
			WAD
			WAD

DESIGNED BY		DRAWN BY		CHECKED BY		APPROVED BY	
AJP		KOS		WAD		WAD	

ENVIRONMENTAL, INC.
ENGINEERS IN WATER AND EARTH SCIENCES
UNIONTOWN, OHIO

CITY OF MASSILLON, OHIO
WWTP UPGRADE 2000
STROM SEWER
PLAN

JOB NO. E9031
DATE 9/21/01
SCALE 1" = 20'
SHEET C34