



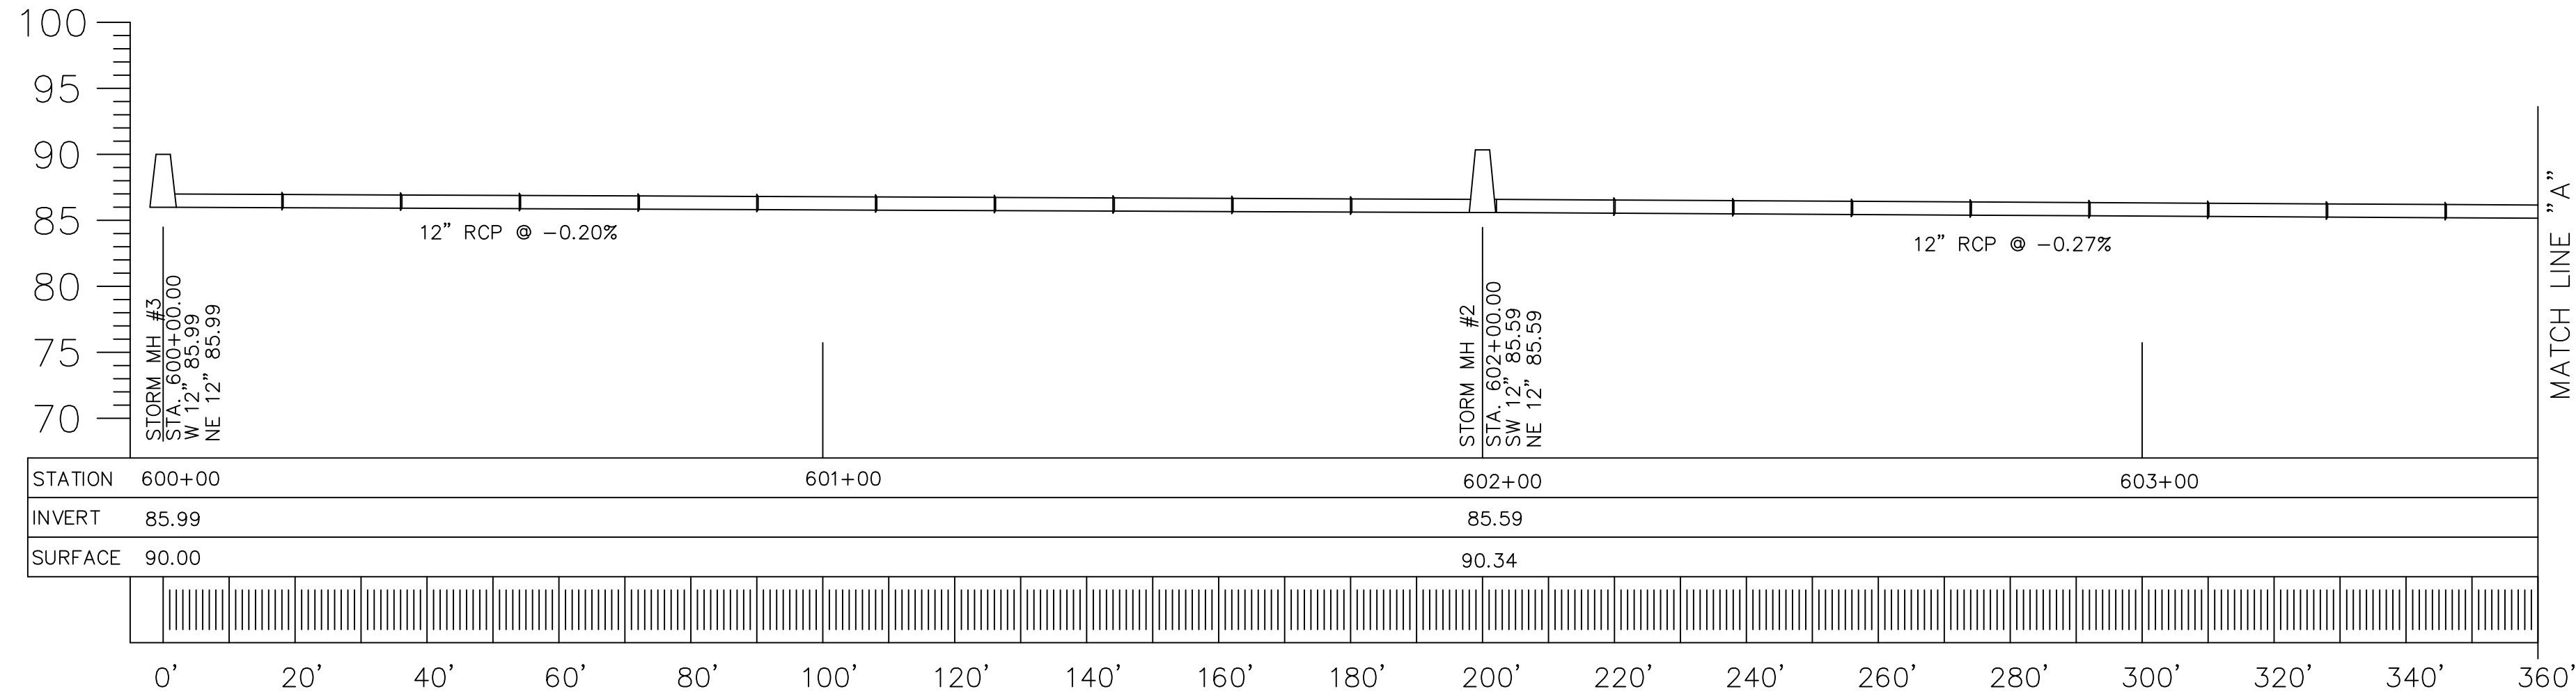


HORIZONTAL SCALE: 1" = 20'
VERTICAL SCALE: 1" = 10'

PROFILE 1

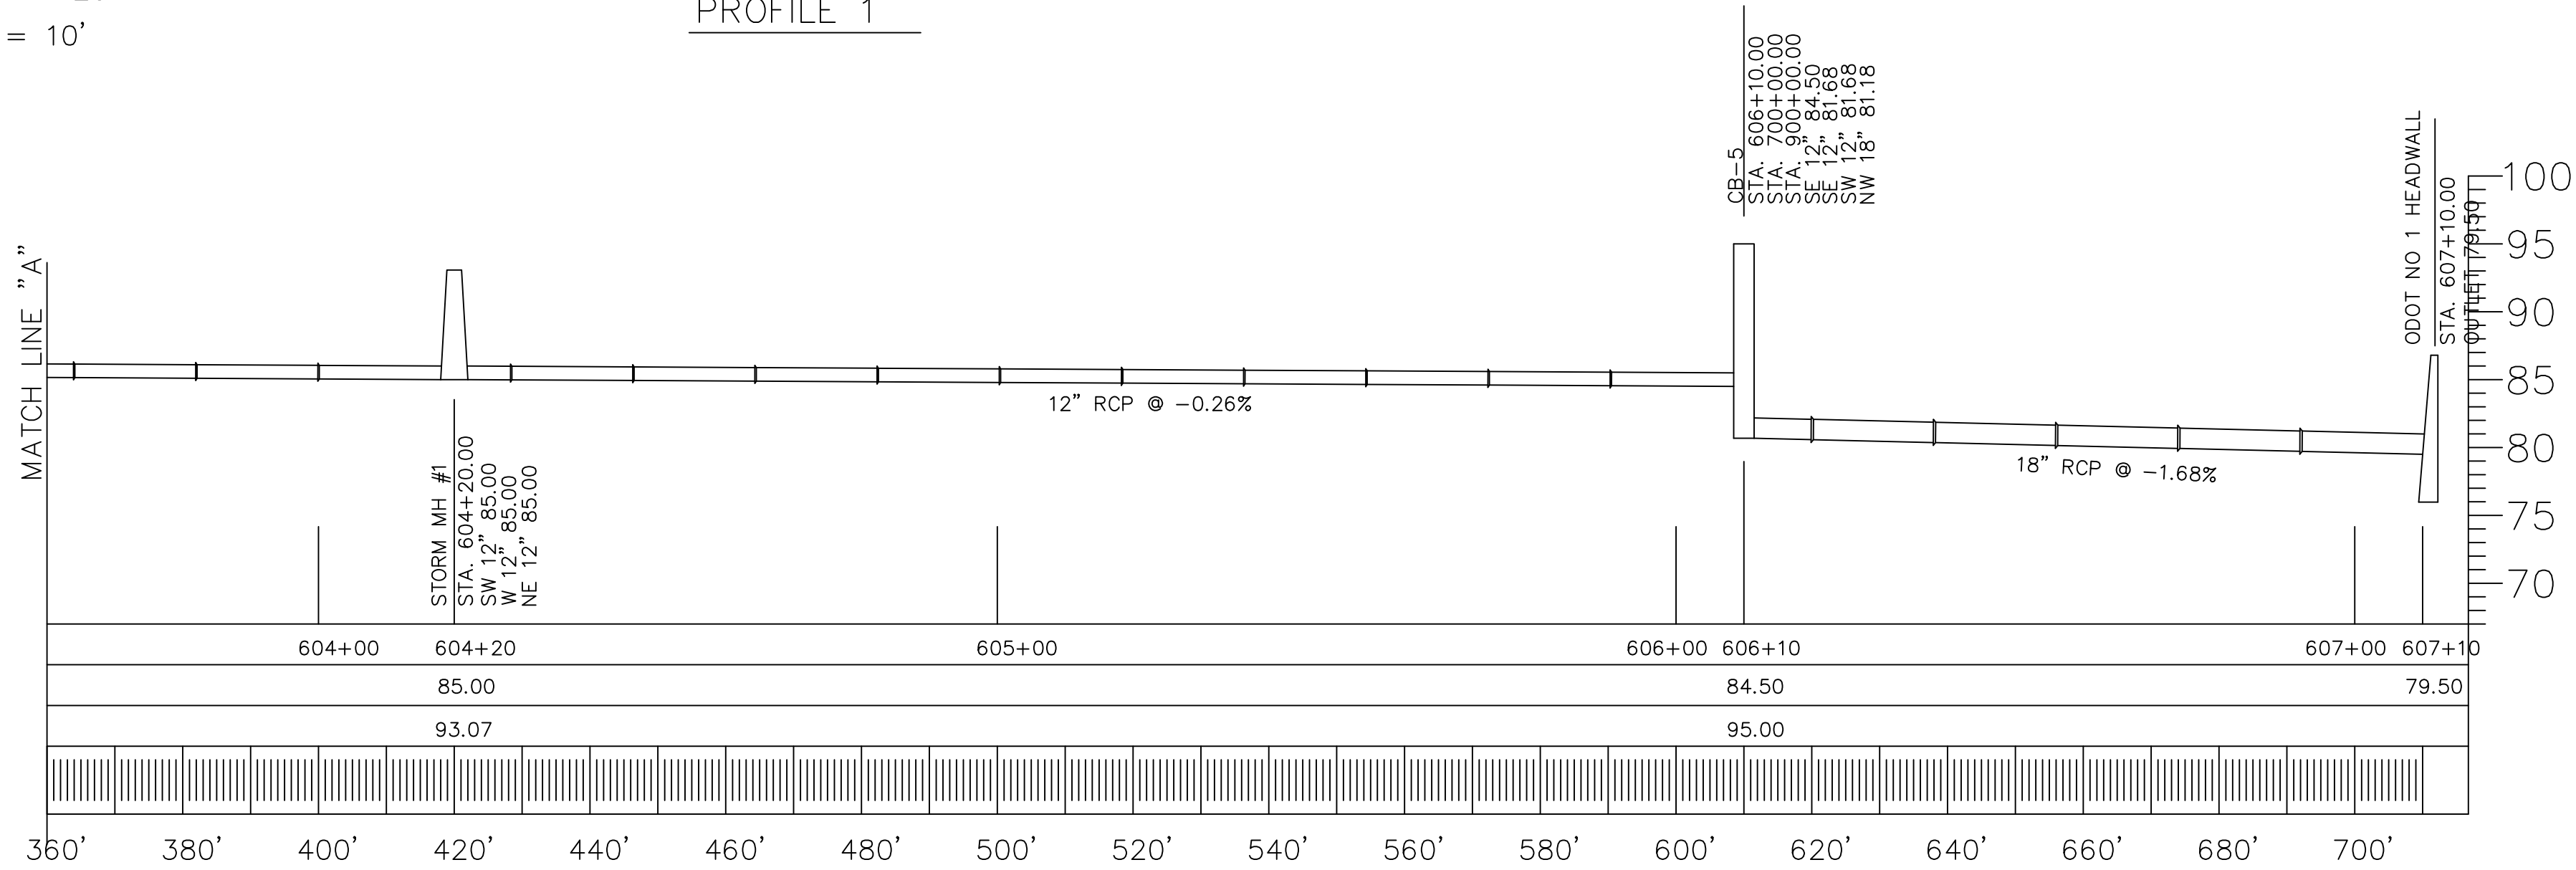


PROFILE 1 CONT.

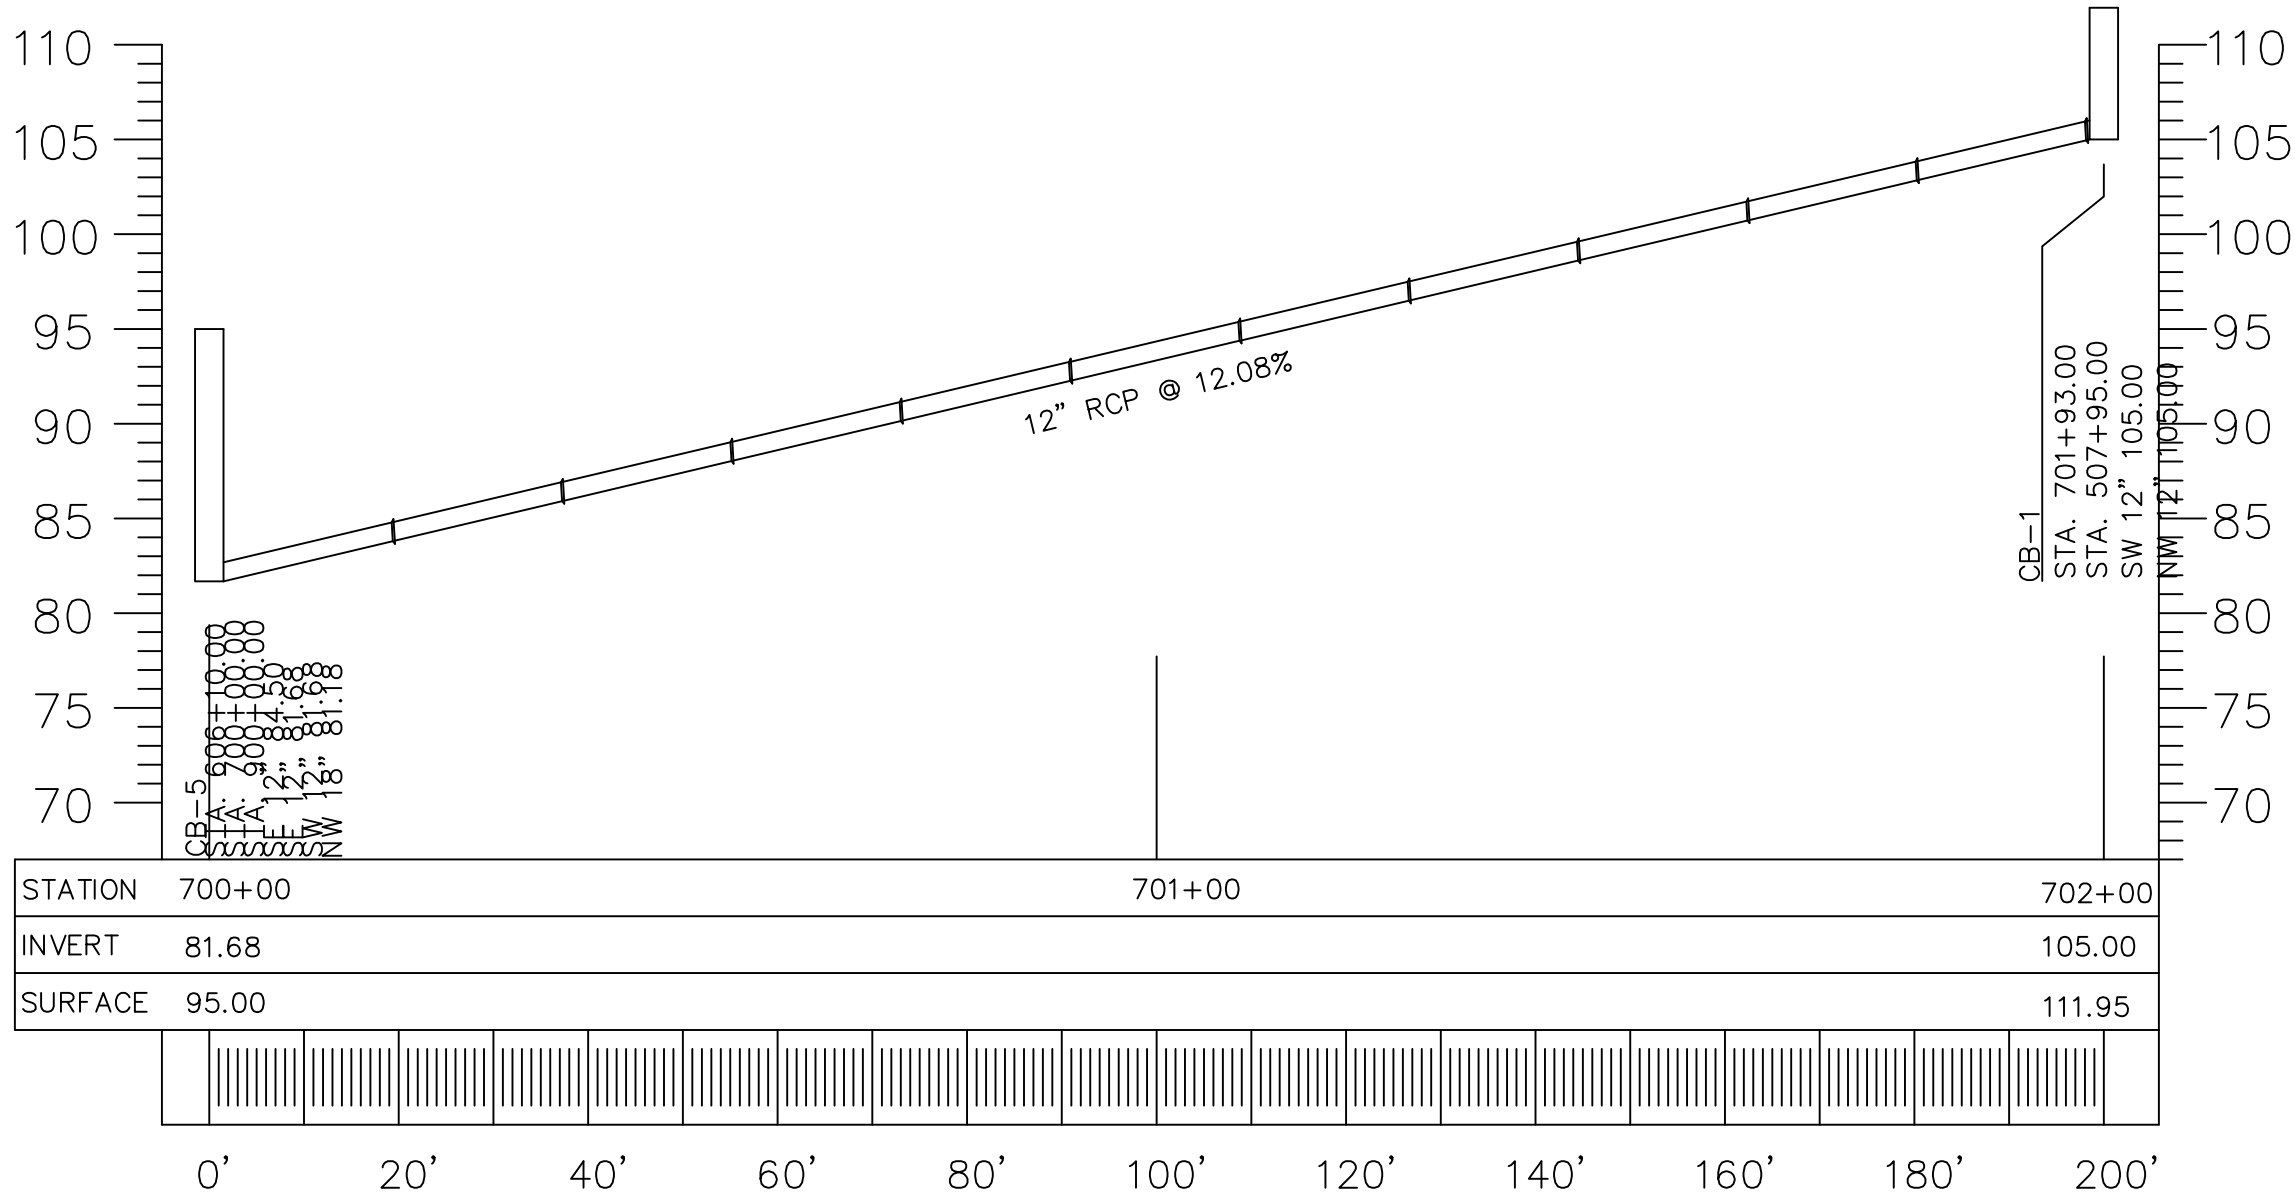


HORIZONTAL SCALE: 1" = 20'
VERTICAL SCALE: 1" = 10'

PROFILE 2

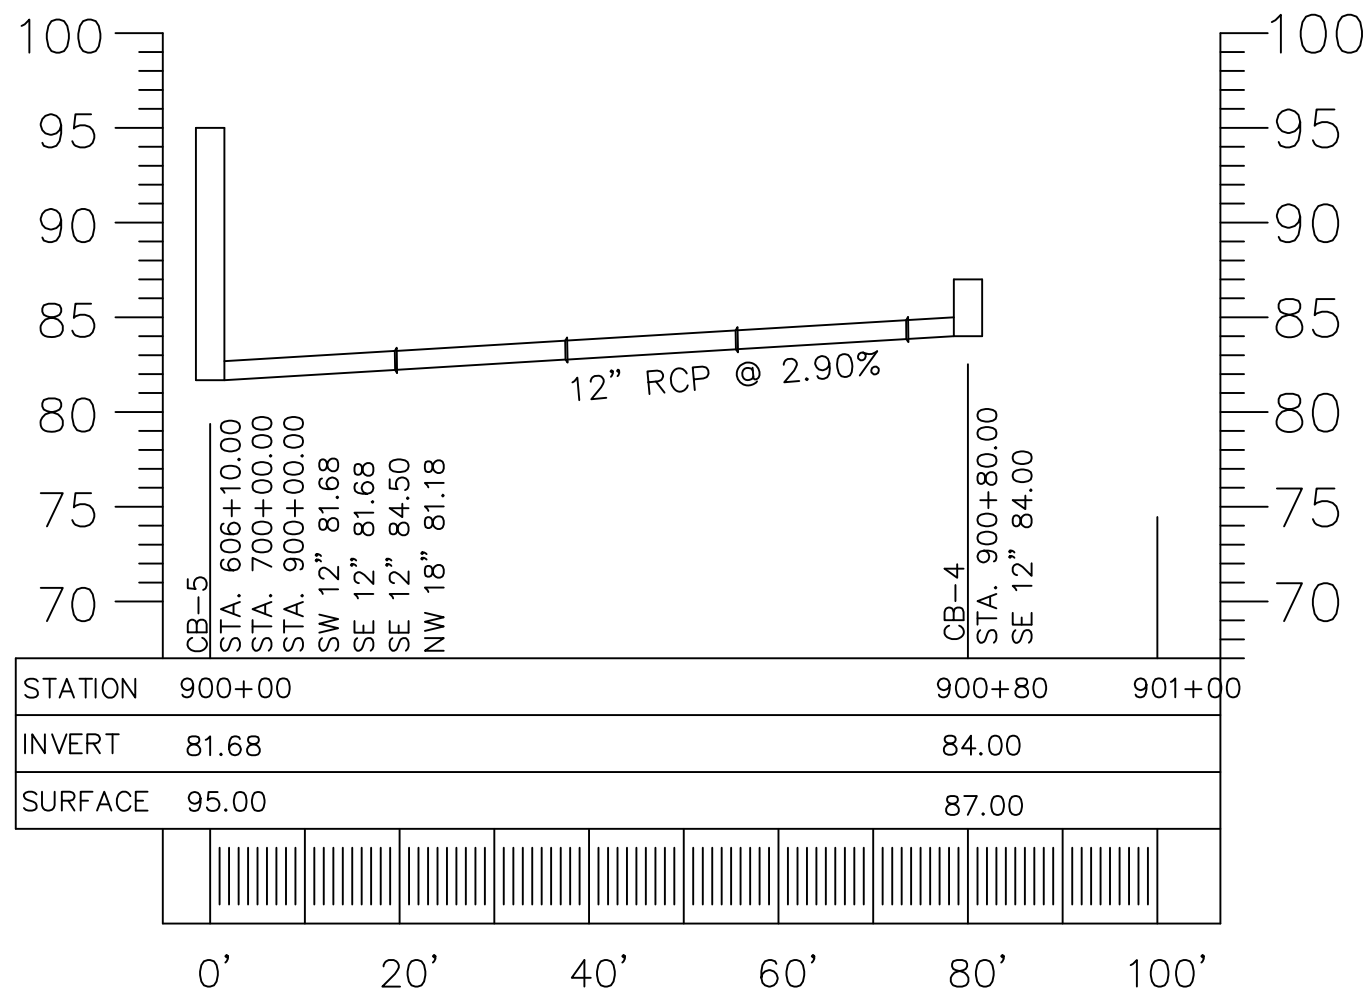


HORIZONTAL SCALE: 1" = 20'
VERTICAL SCALE: 1" = 10'

PROFILE 3

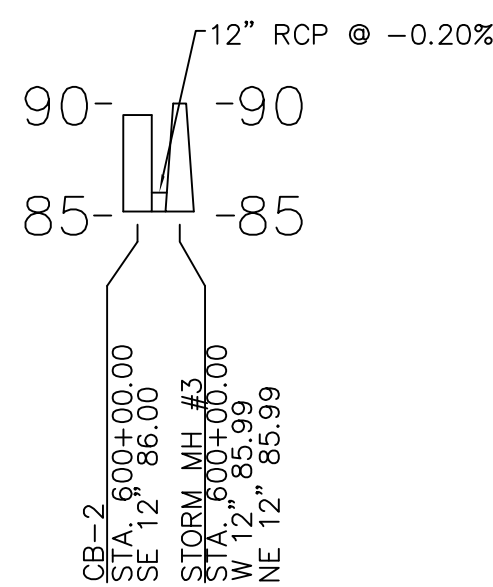

PROFILE 4

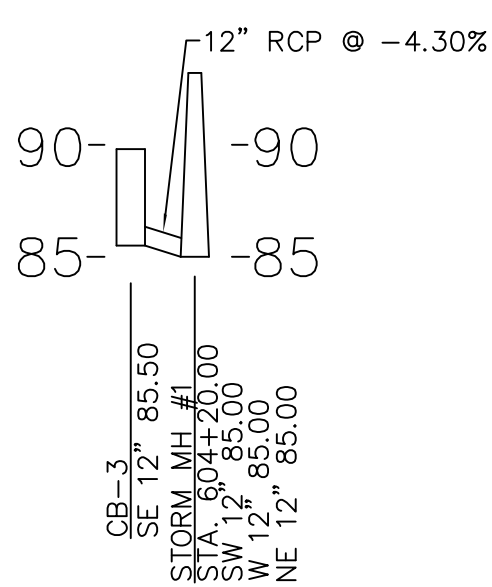

PROFILE 5

THESE RECORD DOCUMENTS HAVE BEEN PREPARED
BASED ON INFORMATION PROVIDED BY OTHERS. CTI
ENVIRONMENTAL HAS REVIEWED THE INFORMATION
SUBMITTED AND BELIEVES IT REFLECTS THE WORK AS
CONSTRUCTED. HOWEVER, ALL PERSONS SHALL
VERIFY INFORMATION TAKEN FROM THIS DRAWING.

THIS DRAWING IS AN INSTRUMENT OF SERVICE OWNED
BY CTI ENVIRONMENTAL, INC. WHICH SHALL BE DEEMED
TO BE THE PROPERTY OF CTI ENVIRONMENTAL, INC. FOR
AND COMMON LAW RIGHTS, INCLUDING COPYRIGHTS,
TRADEMARKS, AND PATENTS, SHALL BE RESERVED FOR
CTI ENVIRONMENTAL, INC. AND SHALL NOT BE REPRODUCED OR
TRANSMITTED IN ANY FORM OR BY ANY MEANS, ELECTRONIC OR
MECHANICAL, INCLUDING PHOTOCOPYING, RECORDING, OR
BY ANY INFORMATION STORAGE AND RETRIEVAL SYSTEM,
WITHOUT THE WRITTEN PERMISSION OF CTI ENVIRONMENTAL, INC.
ELECTRONIC COPIES OF THIS DRAWING ARE EXACT
REPRODUCTIONS OF THE ORIGINAL DRAWING. IN THE EVENT OF A
CONFLICT BETWEEN AN ELECTRONIC COPY AND THE ORIGINAL
DRAWING, THE ORIGINAL DRAWING SHALL GOVERN.

DESIGNED BY		NO.		DATE		BY		APP'D	
KOS		1		9/14		AJP		WAD	
KOS		2		9/21		AJP		WAD	
WAD		2		12/28		AJP		WAD	
WAD									

ENVIRONMENTAL, INC.
ENGINEERS IN WATER AND EARTH SCIENCES
UNIONTOWN, OHIO
CITY OF MASSILLON, OHIO
WWTP UPGRADE 2000
STORM SEWER
PROFILE

JOB NO. E9031
DATE 9/21/01
SCALE AS SHOWN
SHEET C35