


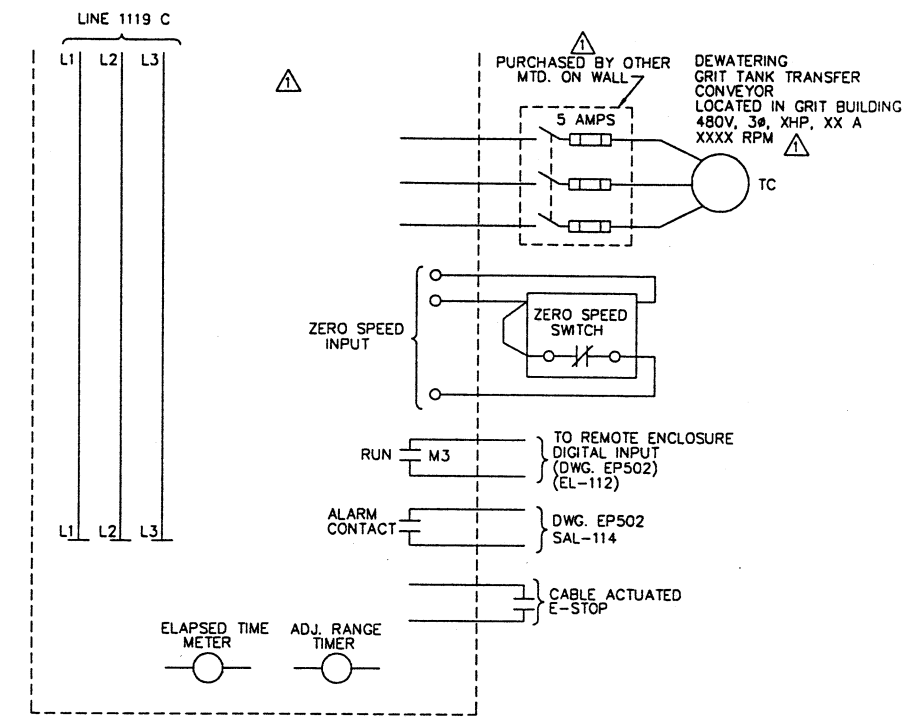

REVISIONS					
DESIGNED BY	DRAWN BY	NO.	DESCRIPTIONS	DATE	BY
	STI/TSS	1	CHANGES MADE TO MCC A1	11/27/02	TSS R.J.L.
	STI/ELG	2	REMOTE RUN CONTACT	11/27/02	R.J.L.
CHECKED BY					
APPROVED BY					
	STI/RJL				

CTI ENVIRONMENTAL, INC.
ENGINEERS IN WATER AND EARTH SCIENCES
UNIONTOWN, OHIO

CITY OF MASSILLON, OHIO
WWTP UPGRADE 2000
TRANSFORMER "A1", MCC-A1
GRIT TANK CONTROL SCHEMATIC DIAGRAM

JOB NO.	9031
DATE	4/03/01
SCALE	N/A
SHEET	EP11-2