
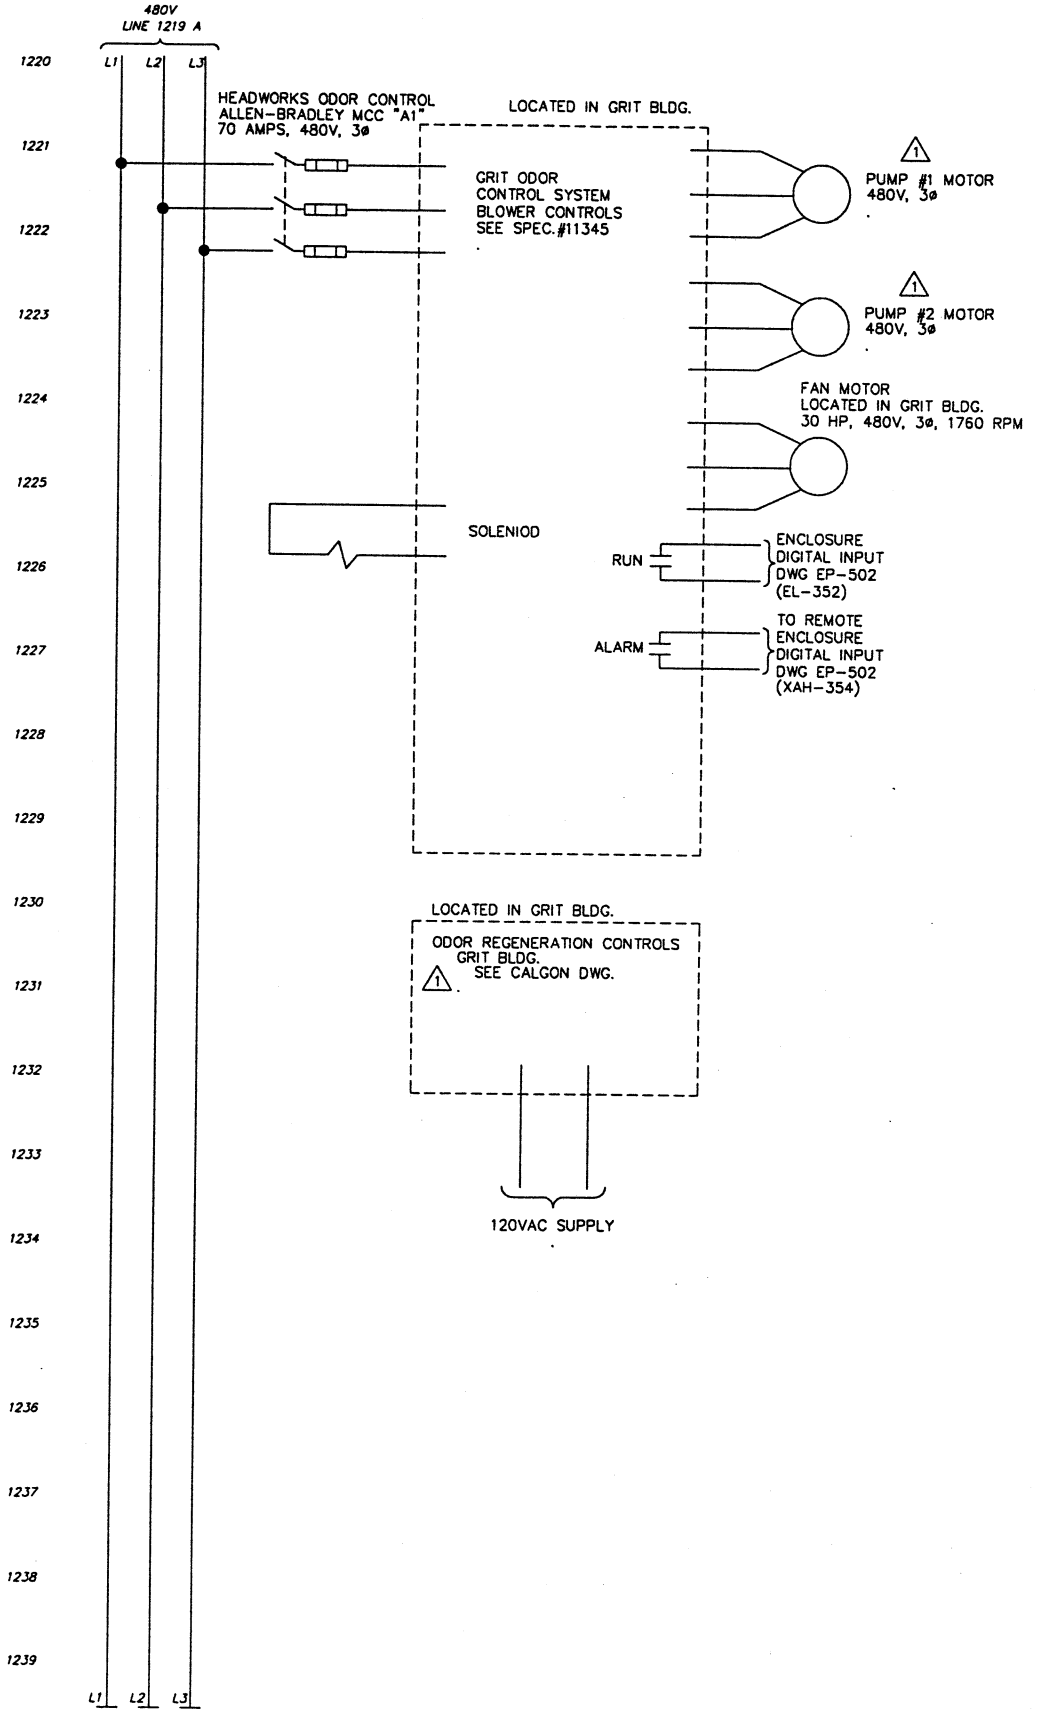


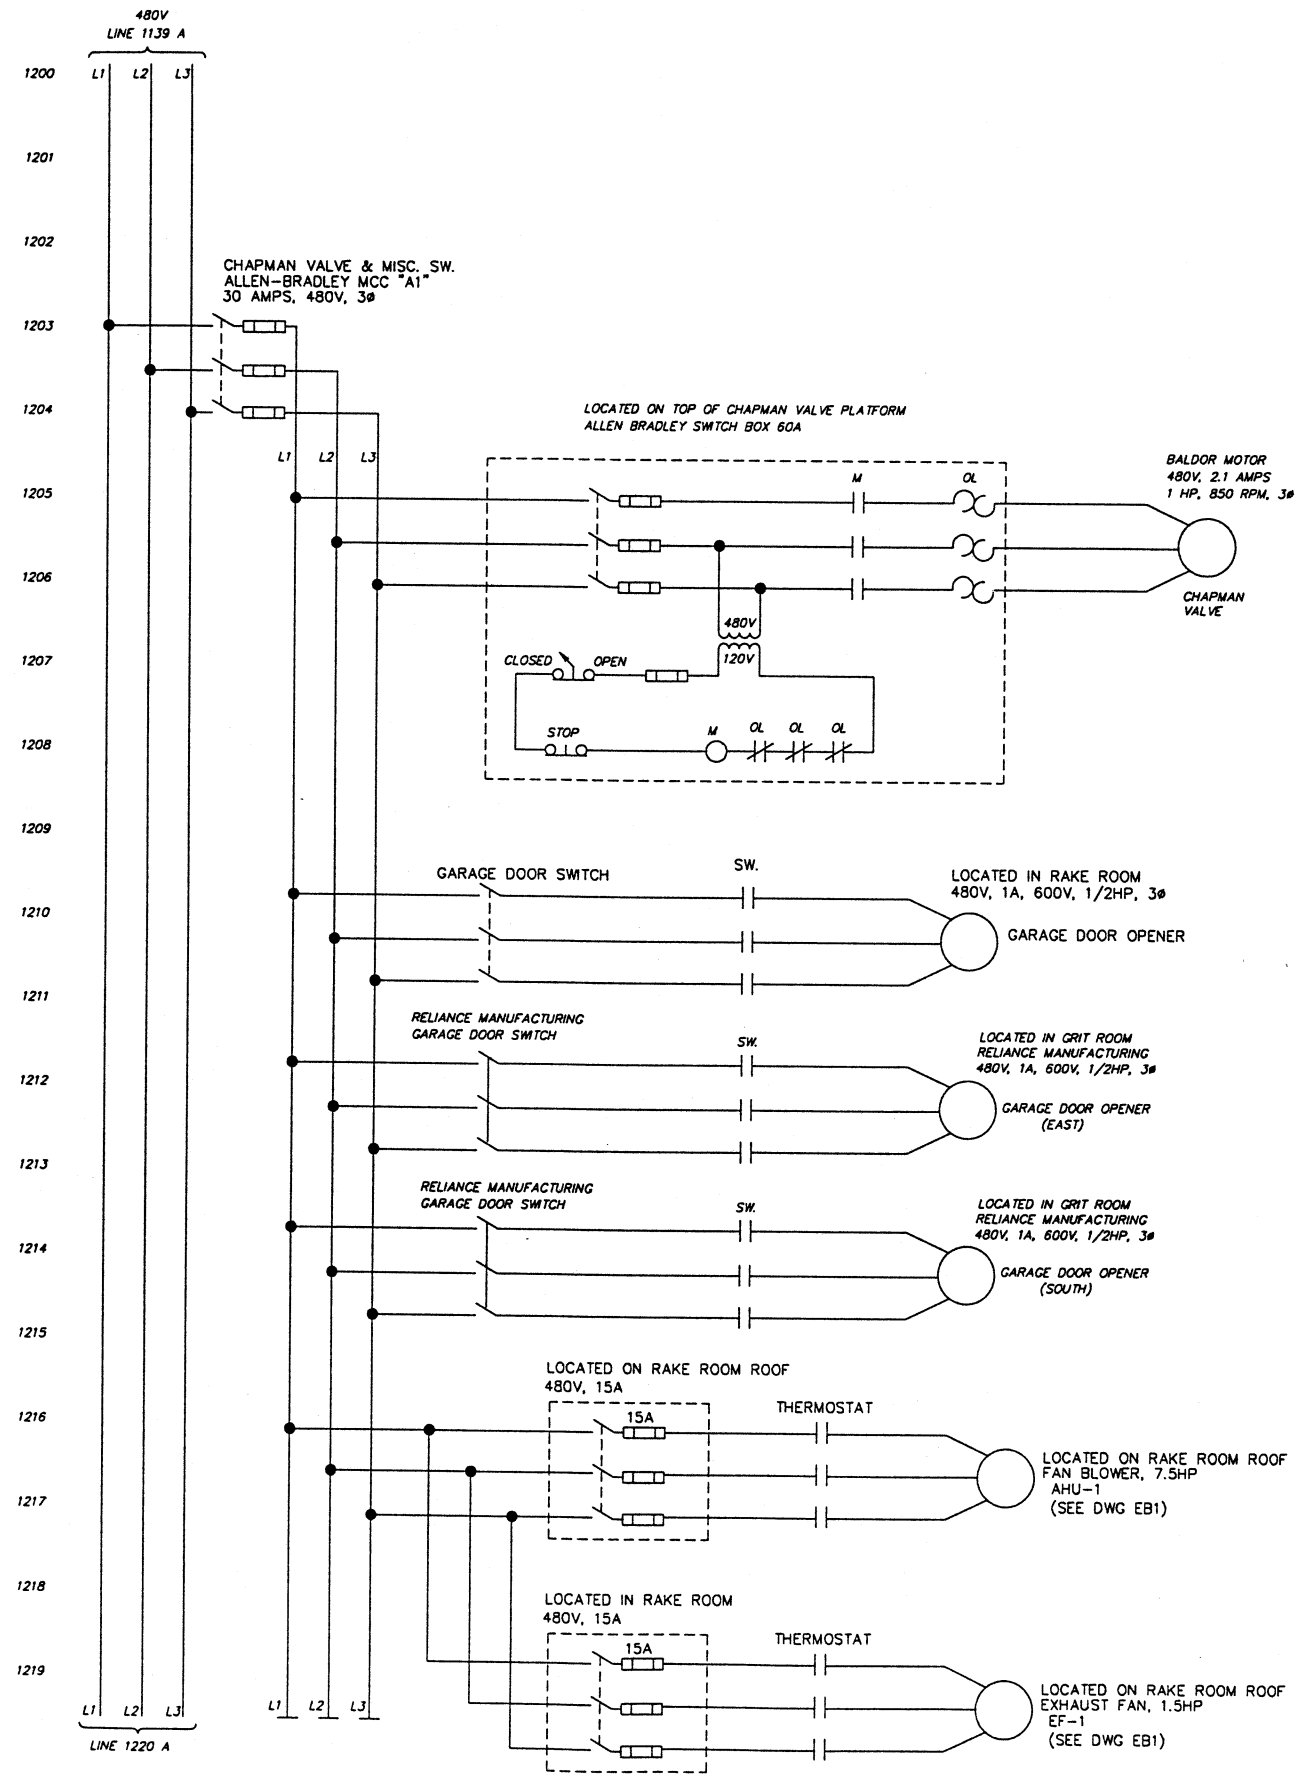

SWIRE TECHNOLOGIES, INC.
MASSILLON, OHIO
567-4-1111

REVISIONS		DATE	BY	APP'D
NO.	DESCRIPTIONS			
1	ODOR PUMPS, AUX CONTACTS		R/L	

DESIGNED BY	STI/TSS	DRAWN BY	STI/TSS	CHECKED BY	STI/TSS	APPROVED BY	STI/R/L

ENVIRONMENTAL, INC.
ENGINEERS IN WATER AND EARTH SCIENCES
UNIONTOWN, OHIO

CITY OF MASSILLON, OHIO
WWTP UPGRADE 2000
TRANSFORMER "A1", MCC-A1
CHAPMAN VALVE, FAN, GARAGE DOORS, ODOR BLOWER SCHEM

JOB NO.	9031
DATE	2/16/01
SCALE	N/A
SHEET	EP12-1