




NOTES
1. ITEMS TO BE ADDED

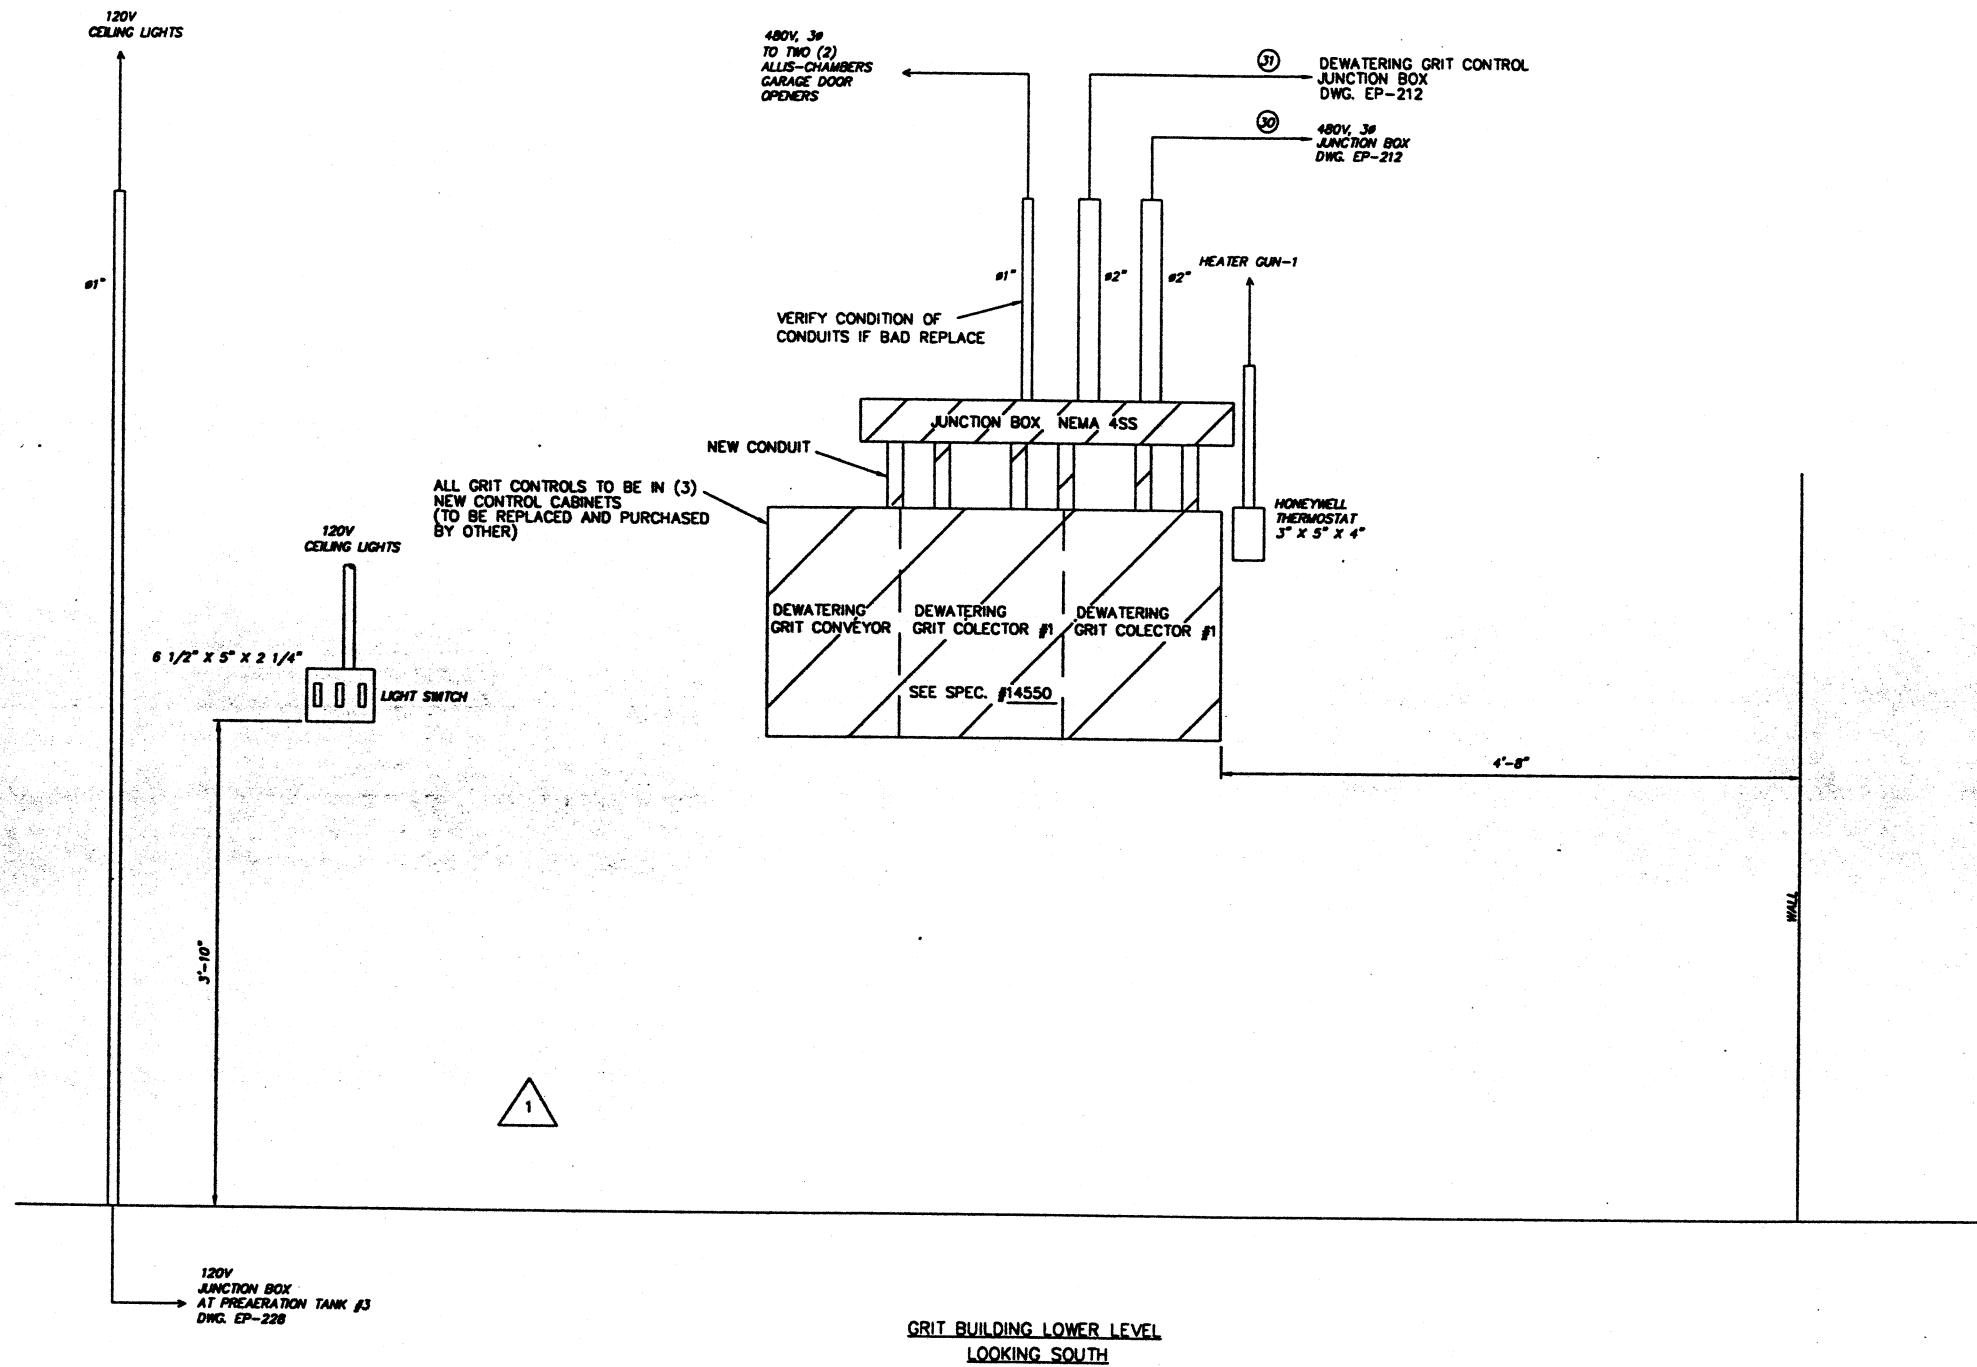

ENVIRONMENTAL, INC.
ENGINEERS IN WATER AND EARTH SCIENCES
UNIONTOWN, OHIO

CITY OF MASSILLON, OHIO
WWTP UPGRADE 2000
SCREEN BLDG. (GRIT ROOM) DEWATERING GRIT
COLLECTORS, & CONVEYOR CONTROLS

DESIGNED BY	NO.	DESCRIPTION	DATE	BY	APP'D
STI/TSS	1	REMOVED GAS MONITOR EQUIPMENT	1/1/01	JCH	R/L
DRAWN BY					
STI/TSS					
CHECKED BY					
STI/TSS					
APPROVED BY					
STI/R/L					

JOB NO.	E9031
DATE	4/27/01
SCALE	1 1/2" = 12"
SHEET	EP213-1

9031SPLE213.DWG

