
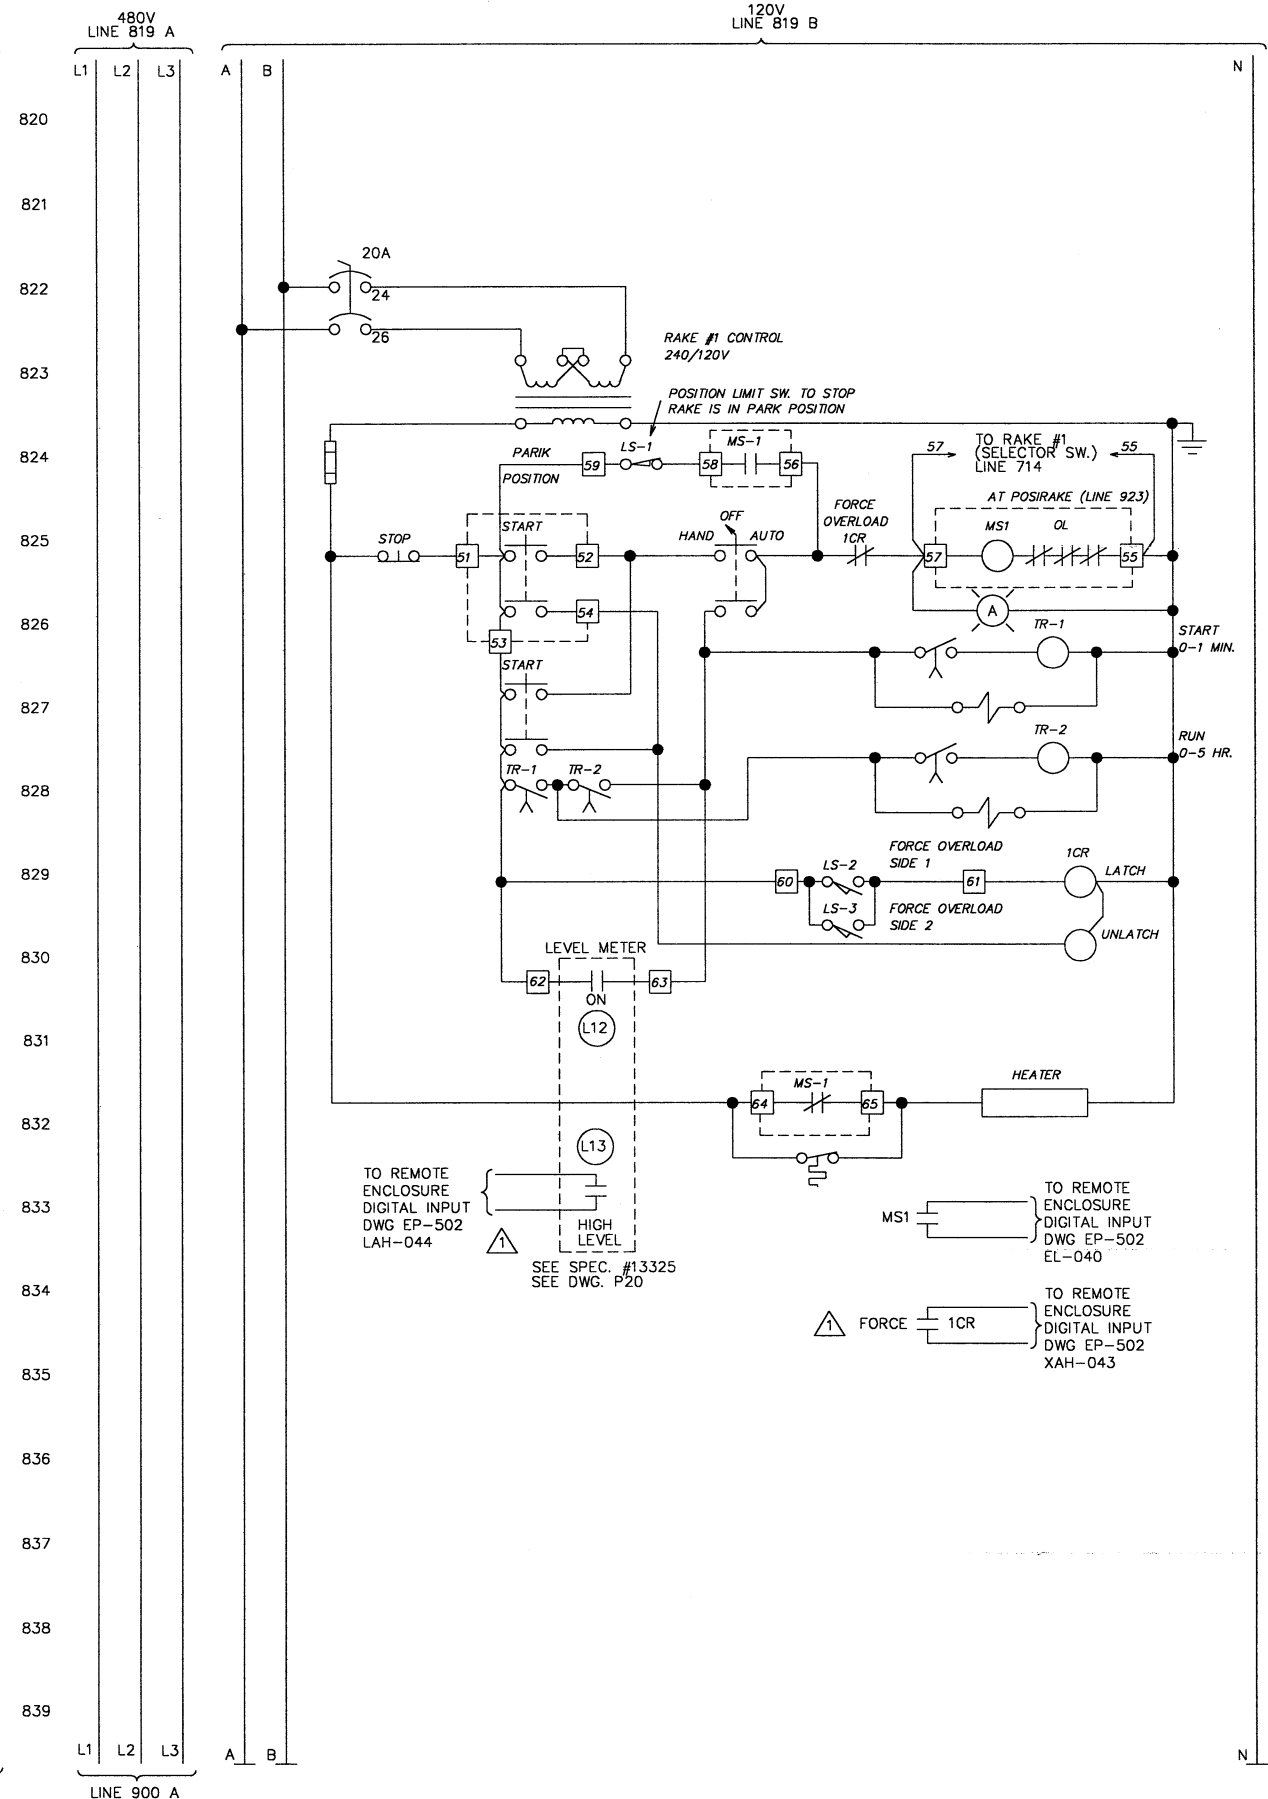


DESIGNED BY		REVISIONS		DATE		BY	
STI/TSS	STI/TSS	NO.	DESCRIPTIONS	1	REVISED AS PER CONSTRUCTION	1/7/03	BY APPD
STI/TSS	STI/TSS	1					

ENVIRONMENTAL, INC.
UNIONTOWN, OHIO

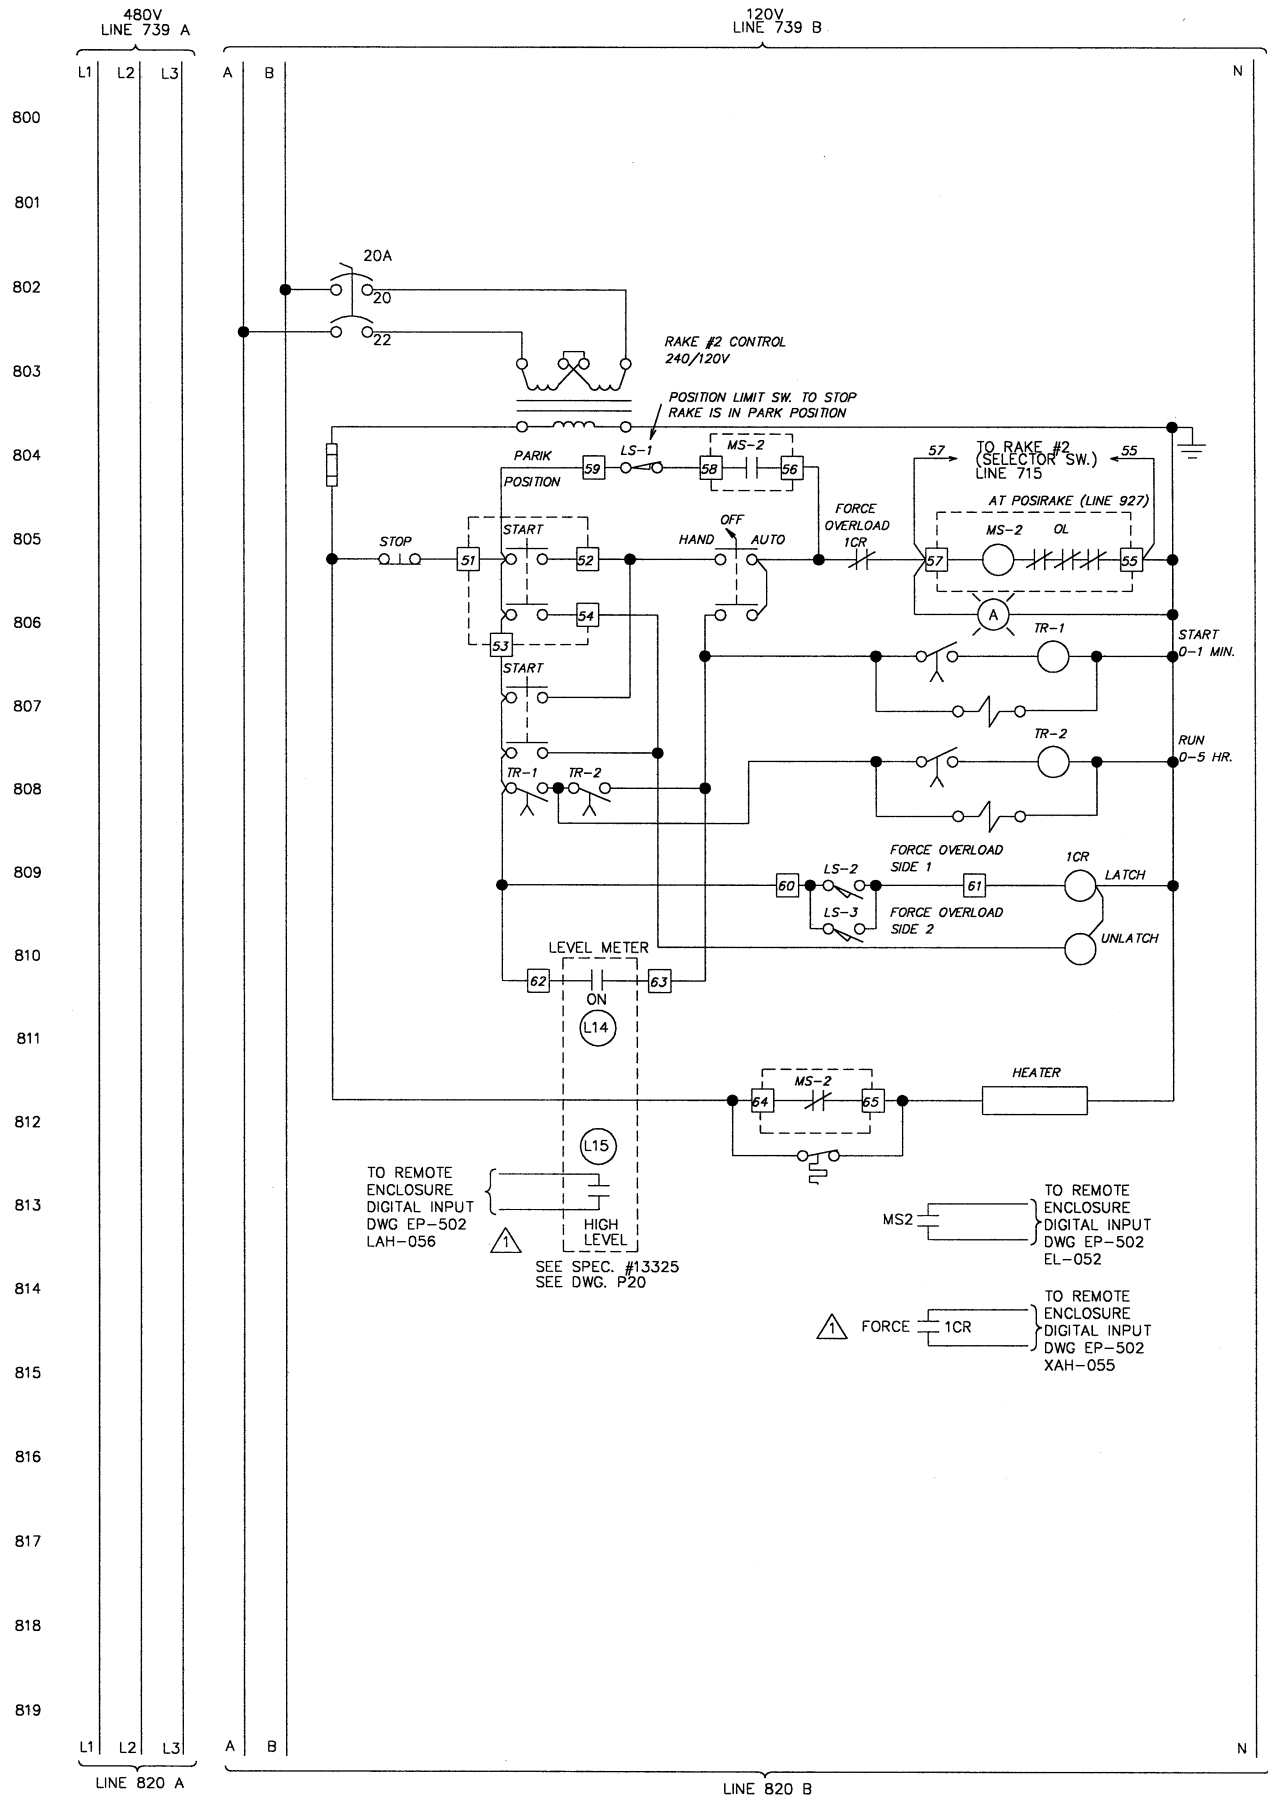

CITY OF MASSILLON, OHIO
WWTP UPGRADE, 2000
TRANSFORMER "A1", MCC-A1
RAKE CONTROLS #1 & #2 SCHEMATIC DIAGRAM

JOB NO.	9031
DATE	2/16/01
SCALE	N/A
SHEET	EP8-1