
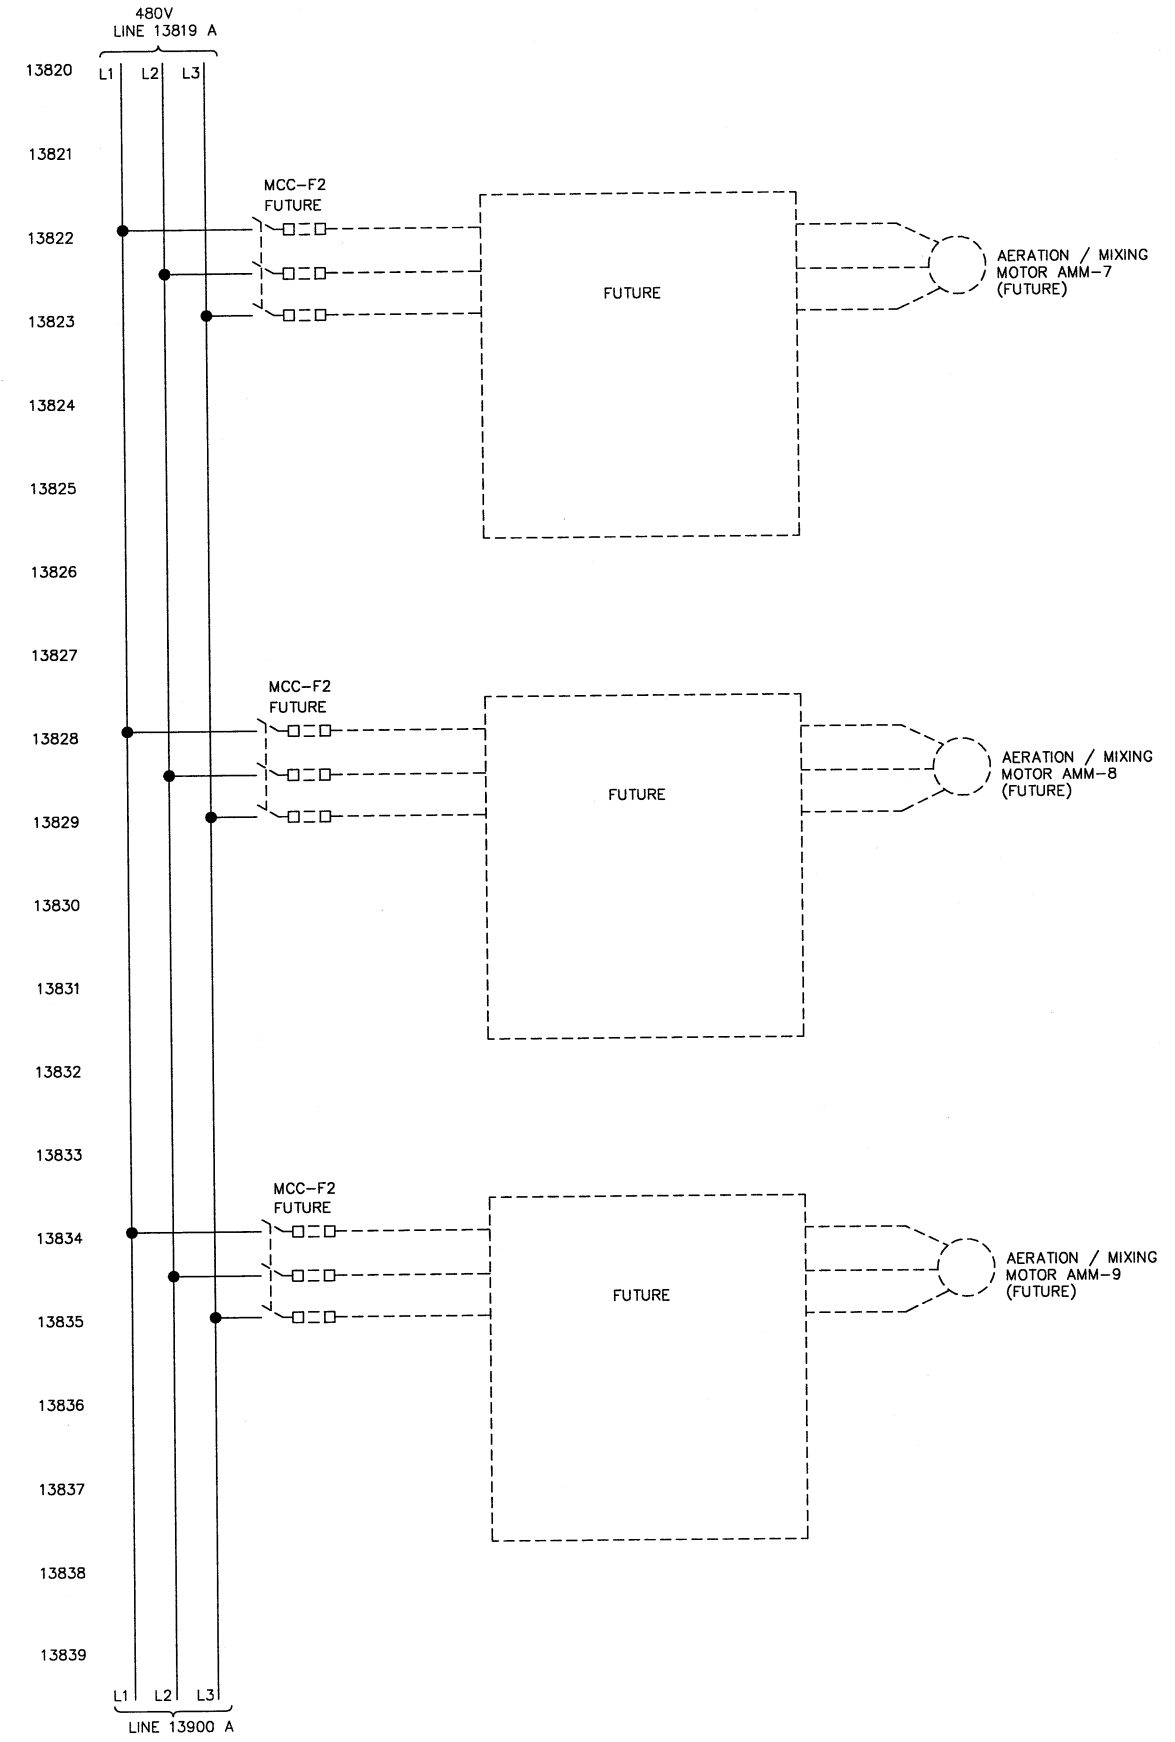


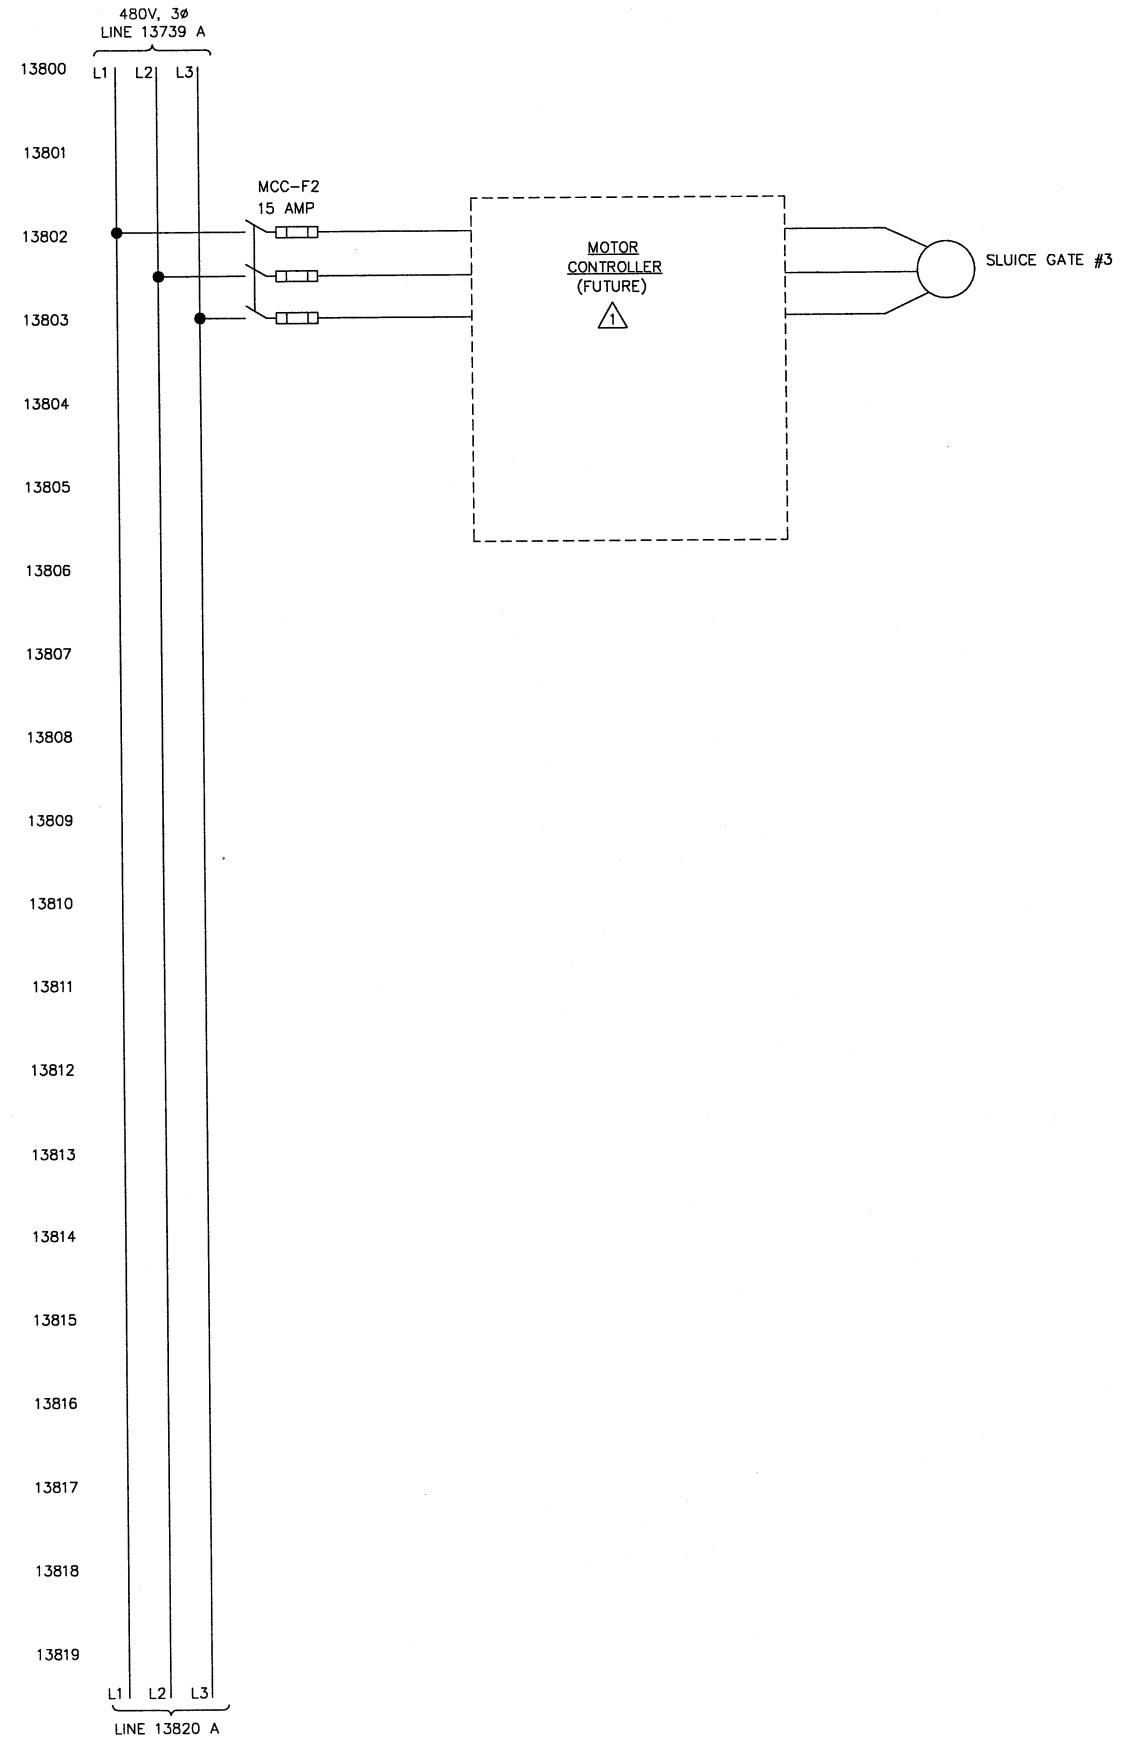

REVISIONS			
NO.	DESCRIPTIONS	DATE	BY
1	NOTED FUTURE	3/2/01	TSS
DESIGNED BY	STI/RRR	DATE	BY
DRAWN BY	STI/RRR	DATE	BY
CHECKED BY	STI/RLL	DATE	BY
APPROVED BY	STI/RLL	DATE	BY

ENVIRONMENTAL, INC.
 ENGINEERS IN WATER AND EARTH SCIENCES
 UNIONTOWN, OHIO
 CITY OF MASSILLON, OHIO
 WWTP UPGRADE 2000
 TRANSFORMER "F2", MCC-F2
 SLUICE GATE & AERATION / MIXING MOTORS SCHEMATIC DIAGRAM

JOB NO.	E9031
DATE	3/2/01
SCALE	N/A
SHEET	EP138-1