


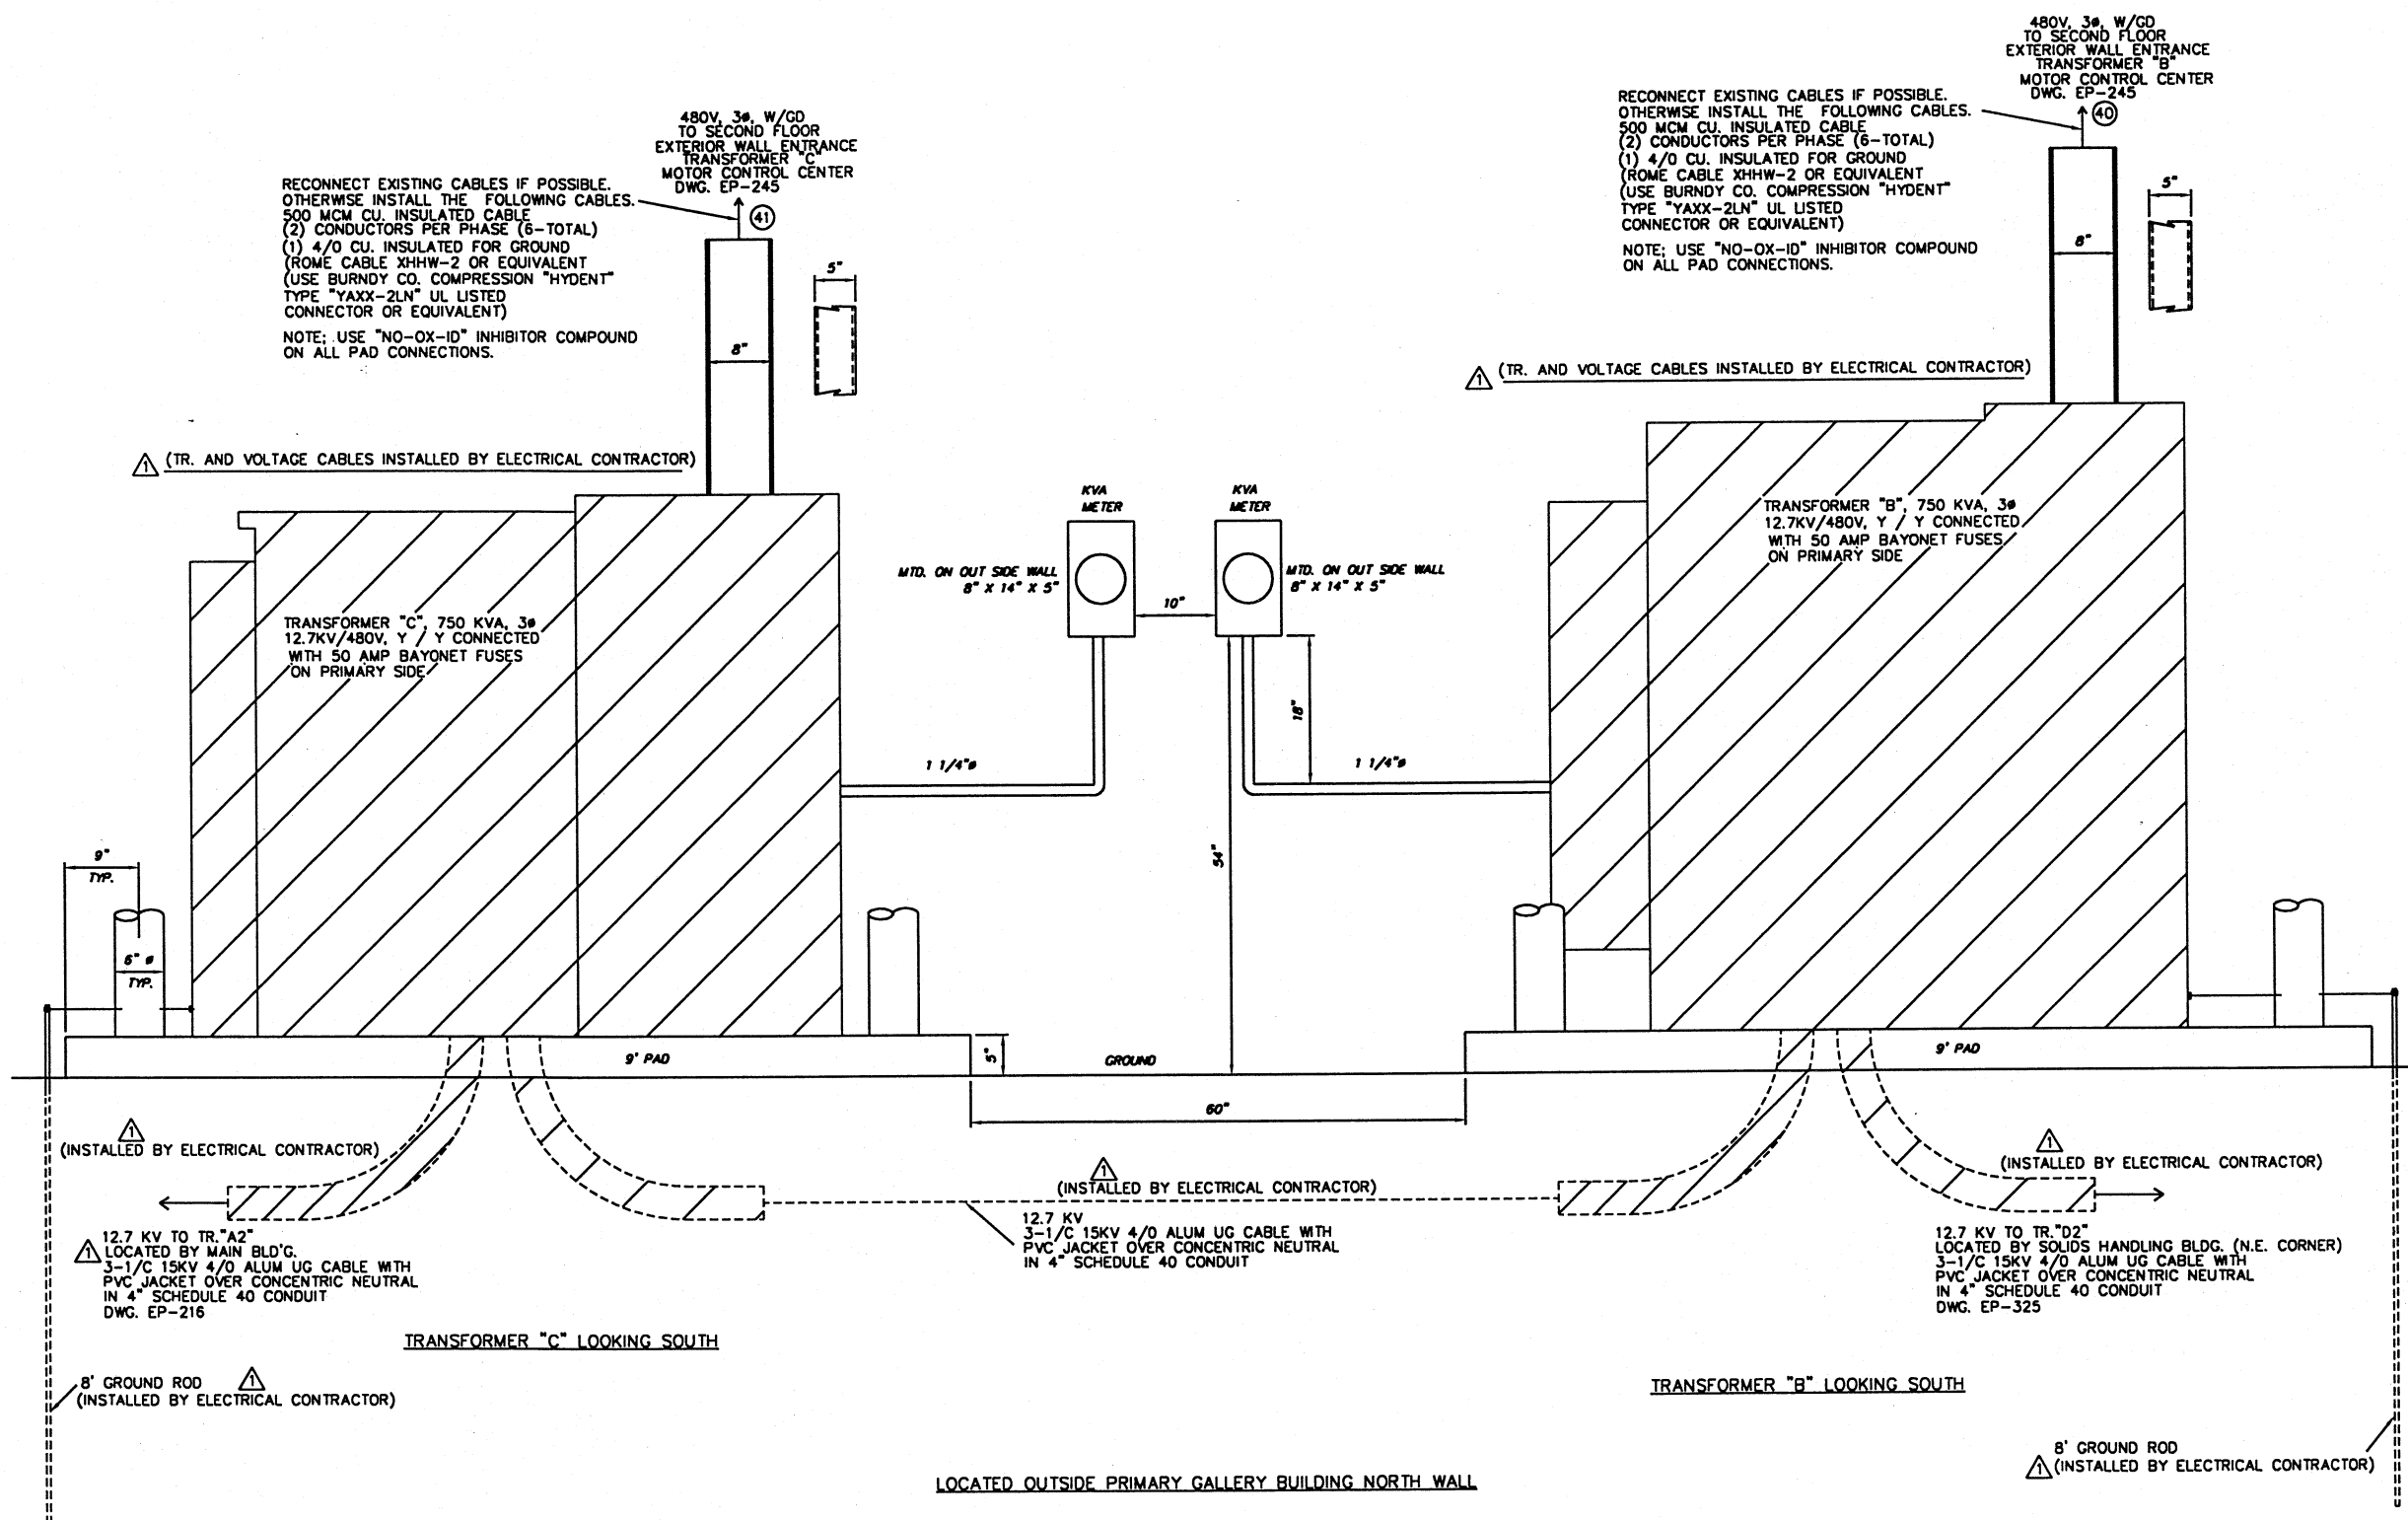

NOTE

1. ITEMS FOR ADDITION 

2. FOR ELECTRICAL SCHEMATICS SEE EP30THRU EP45

REVISIONS					
NO.	DESCRIPTIONS	DATE	BY	APPRO'D	
1	REVISED AS PER CONSTRUCTION	9/20/88	TSS	R.L.	

ENVIRONMENTAL, INC.
ENGINEERS IN WATER AND EARTH SCIENCES

**CITY OF MASSILLON, OHIO
WWTP UPGRADE 2000
TRANSFORMERS "B" & "C" LAYOUT
LOCATED OUTSIDE PRIMARY GALLERY BLDG**

JOB NO.
E9031
DATE
2/21/01
SCALE
1"=10"
SHEET
EP240-1