


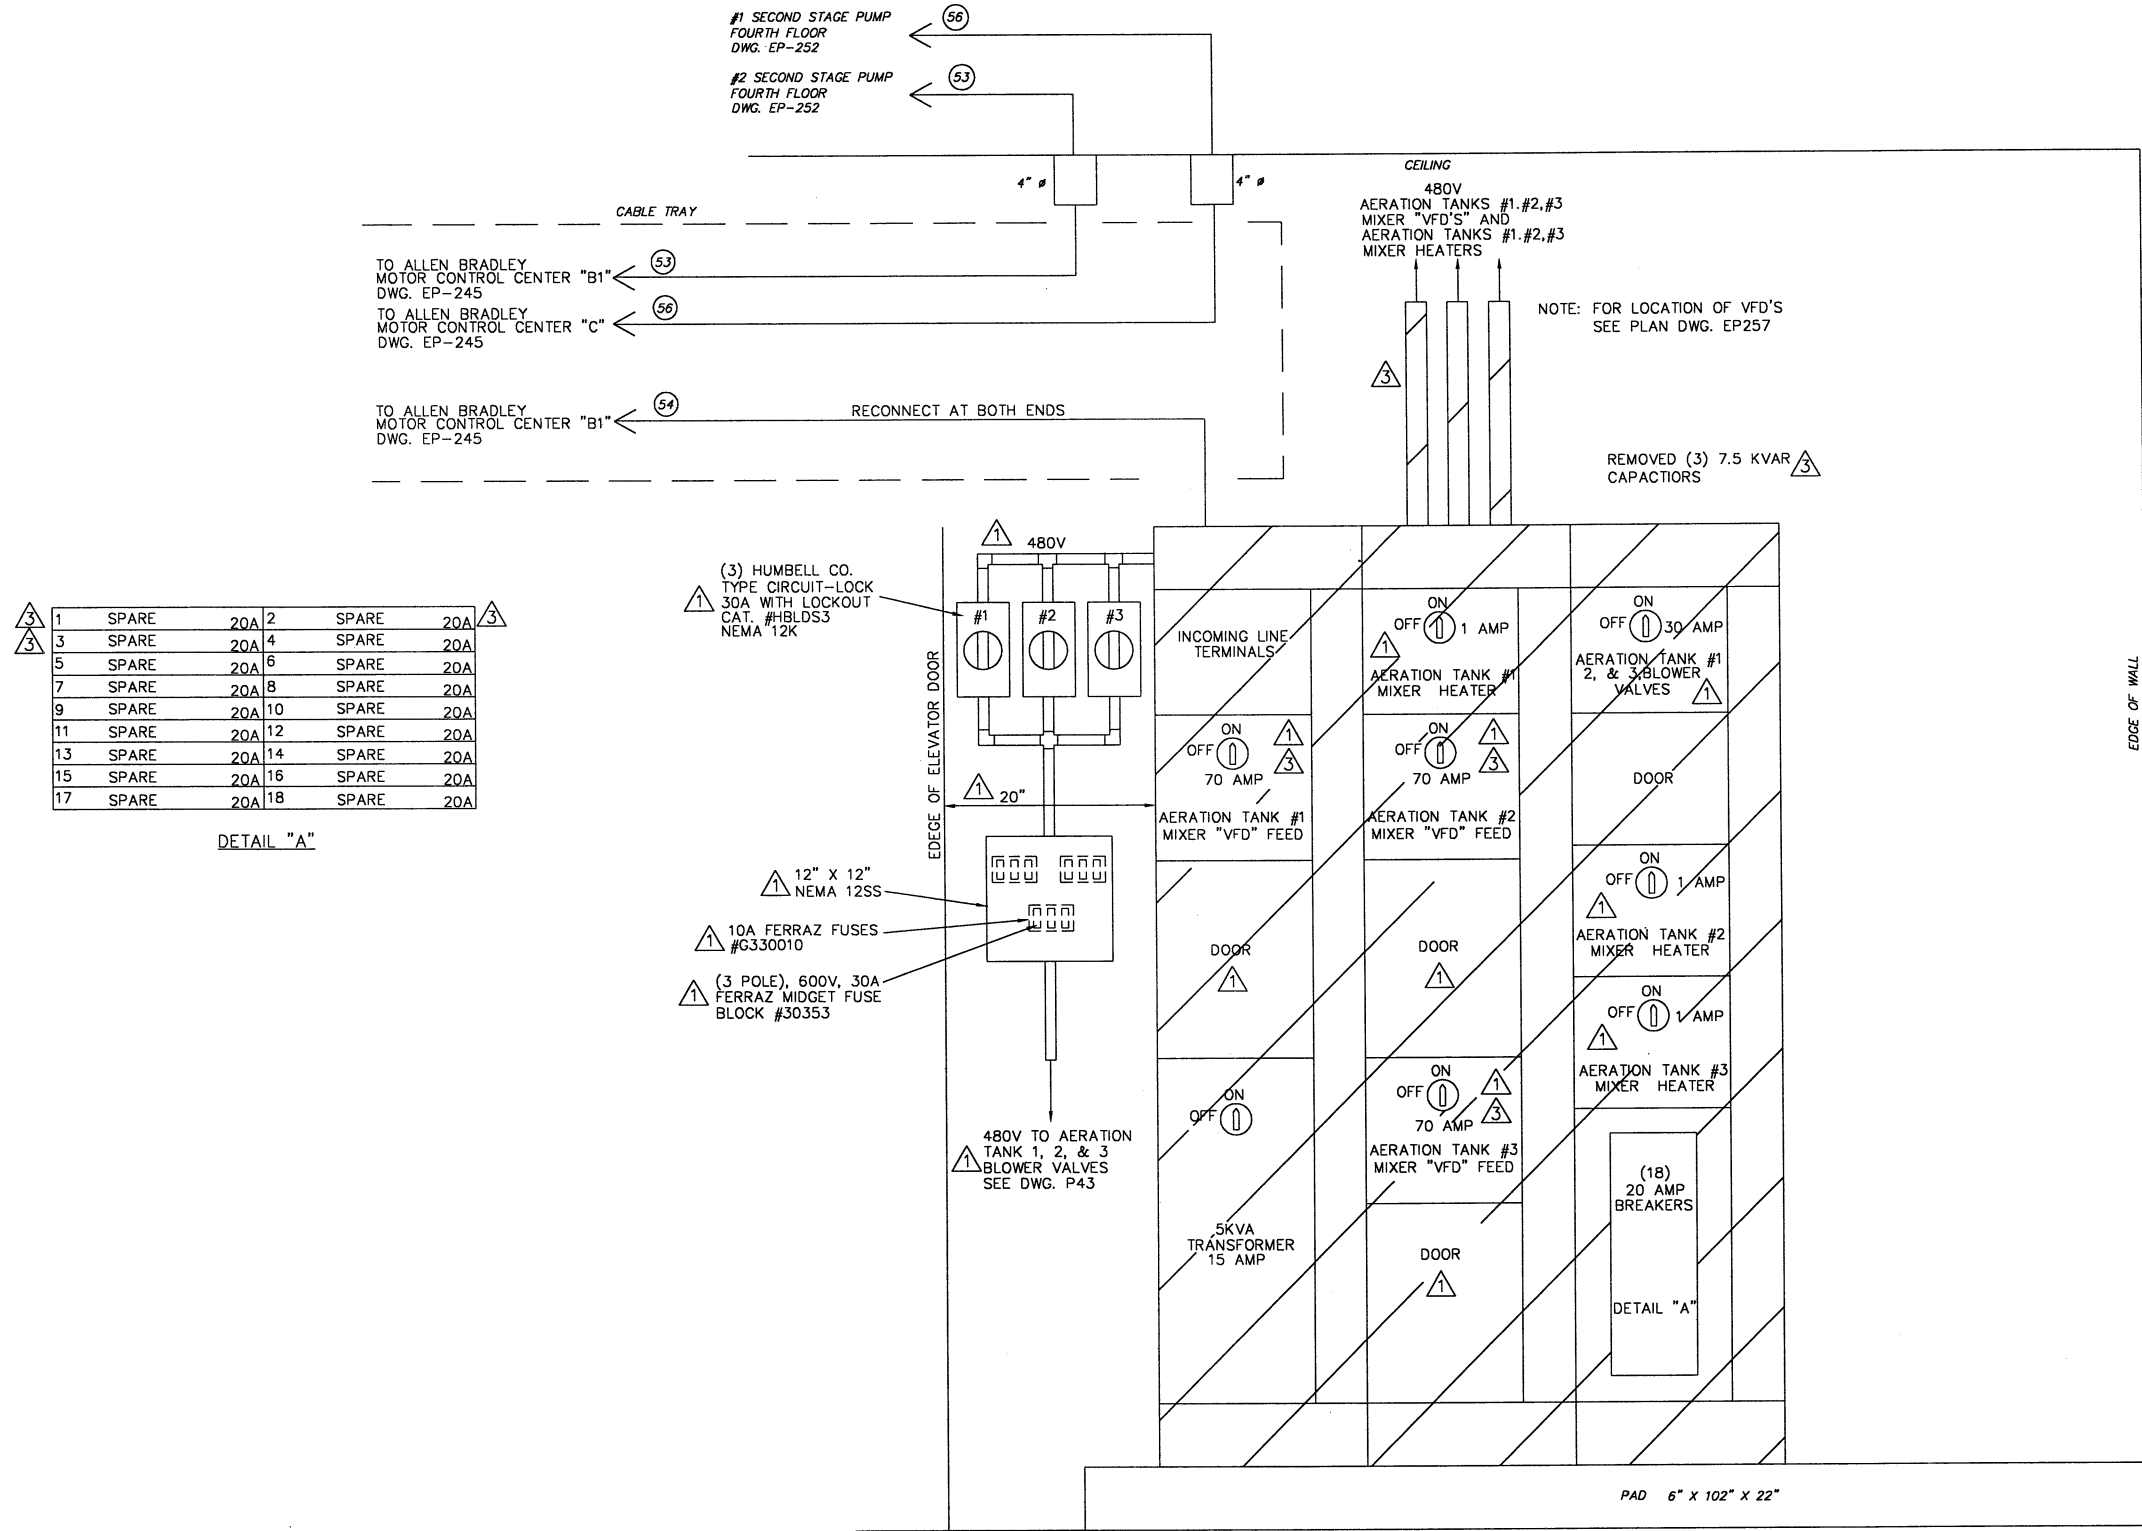

ENVIRONMENTAL, INC.
ENGINEERS IN WATER AND EARTH SCIENCES
UNION TOWN, OHIO

CITY OF MASSILLON, OHIO
WWTP UPGRADE 2000
TRANSFORMERS "B & C", MCC-B2 LAYOUT
PRIMARY GALLERY BLDG

DESIGNED BY
STI/TSS

NO.

DATE
2/15/01

BY
TSS

REVISIONS

DESCRIPTIONS

DATE

BY

APPROVED

JOB NO.
E9031

DATE
2/15/01

SCALE
1 1/2" = 12"

SHEET
EP248-3

9031SPLE248.DWG

NOTE
1. ITEMS FOR ADDITION