


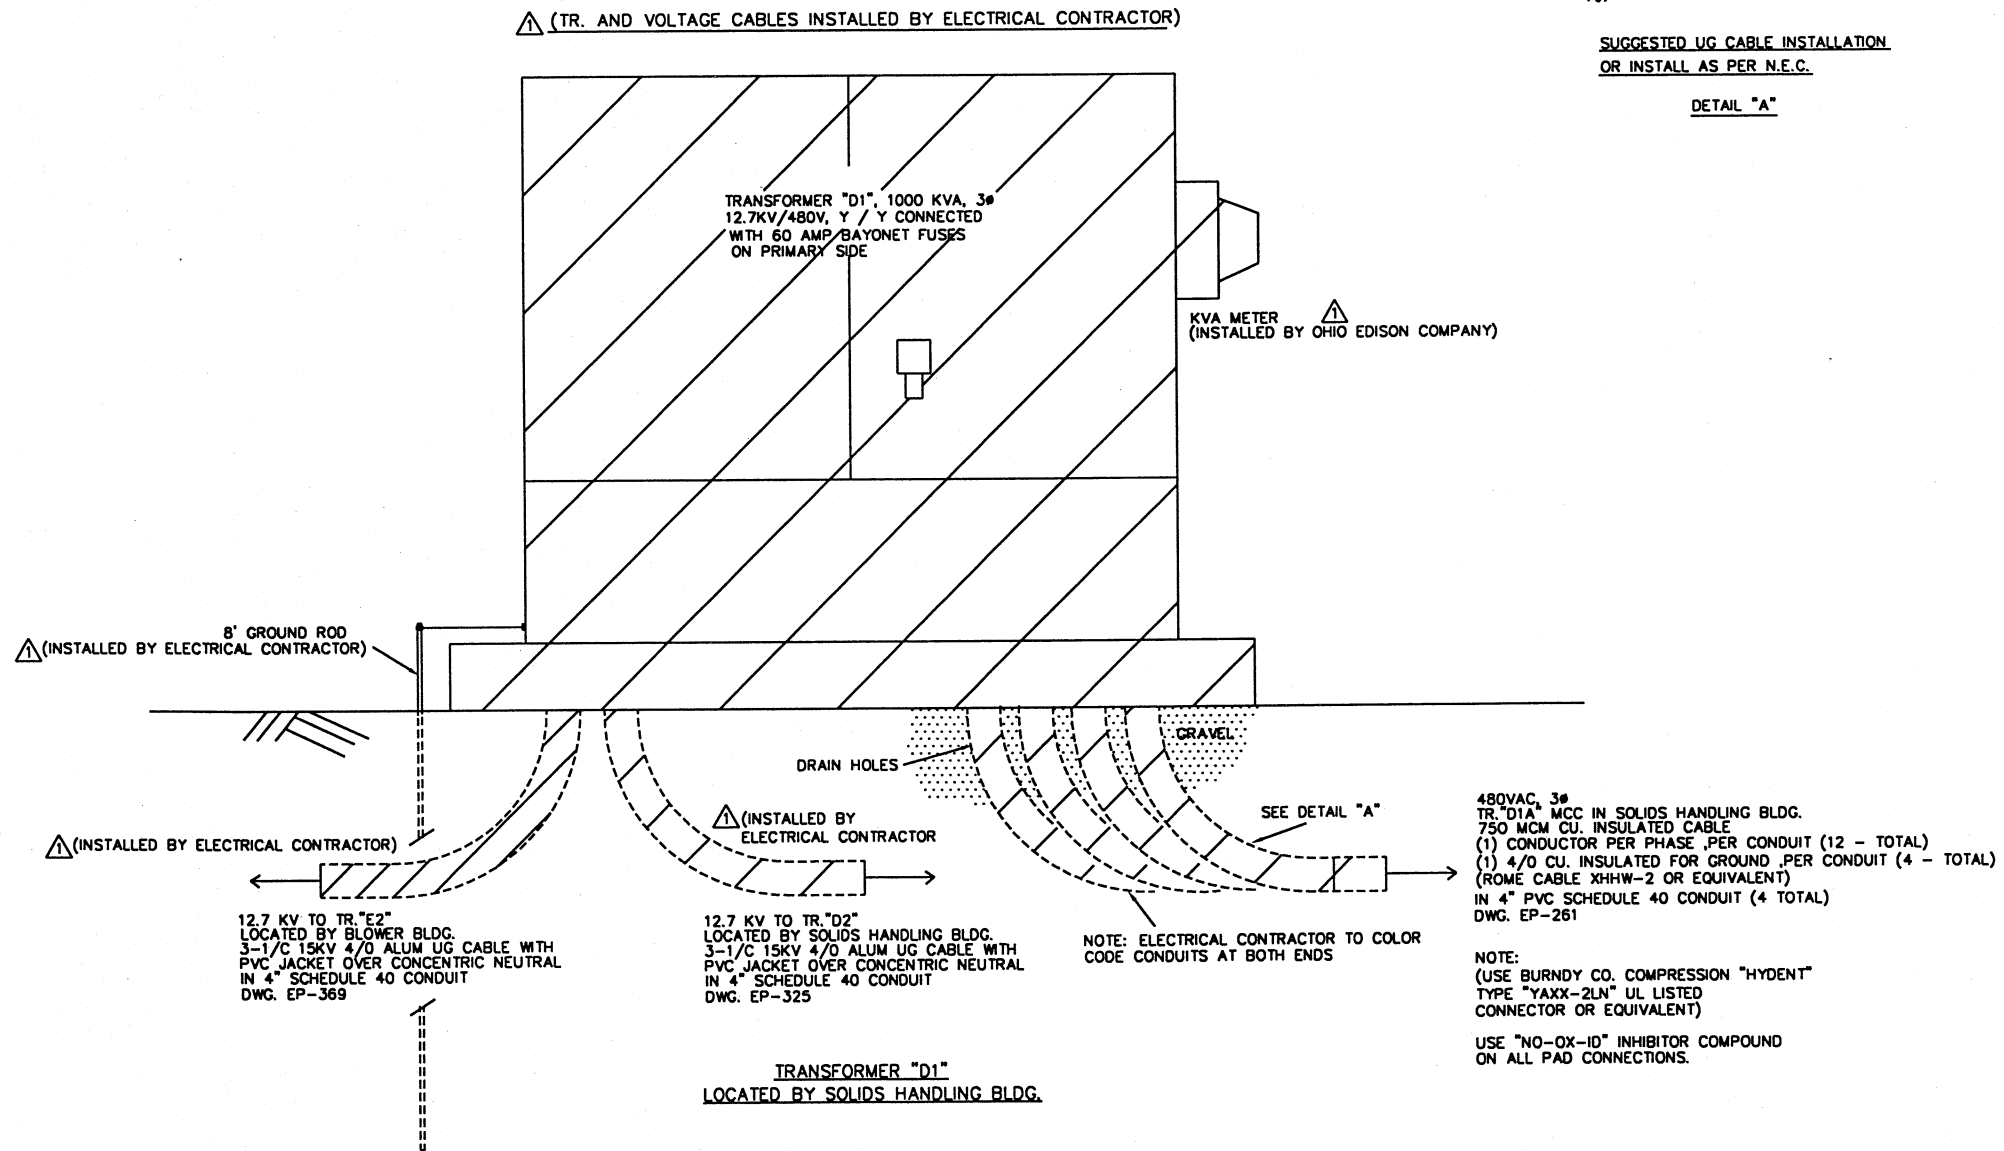

NOTE
1. ITEMS FOR ADDITION 
2. FOR ELECTRICAL SCHEMATICS SEE EP50 THRU EP71

CTI
ENVIRONMENTAL, INC.
ENGINEERS IN WATER AND EARTH SCIENCES
UNIONTOWN, OHIO

CITY OF MASSILLON, OHIO
WWTP UPGRADE 2000
TRANSFORMER "D1" LAYOUT
LOCATED BY SOLIDS HANDLING BLDG

JOB NO.
E9031
DATE
2/15/01
SCALE
1"=10'
SHEET
EP260-1

9031SPLE260.DWG

DESIGNED BY	NO.	REVISIONS	DATE	BY	APP'D
STI/TSS	1	REVISED AS PER CONSTRUCTION	4/14/01	TSS	R.L.
STI/TSS					
STI/TSS					
