



SEE EP-262 FOR ABOVE GROUND CONDUIT

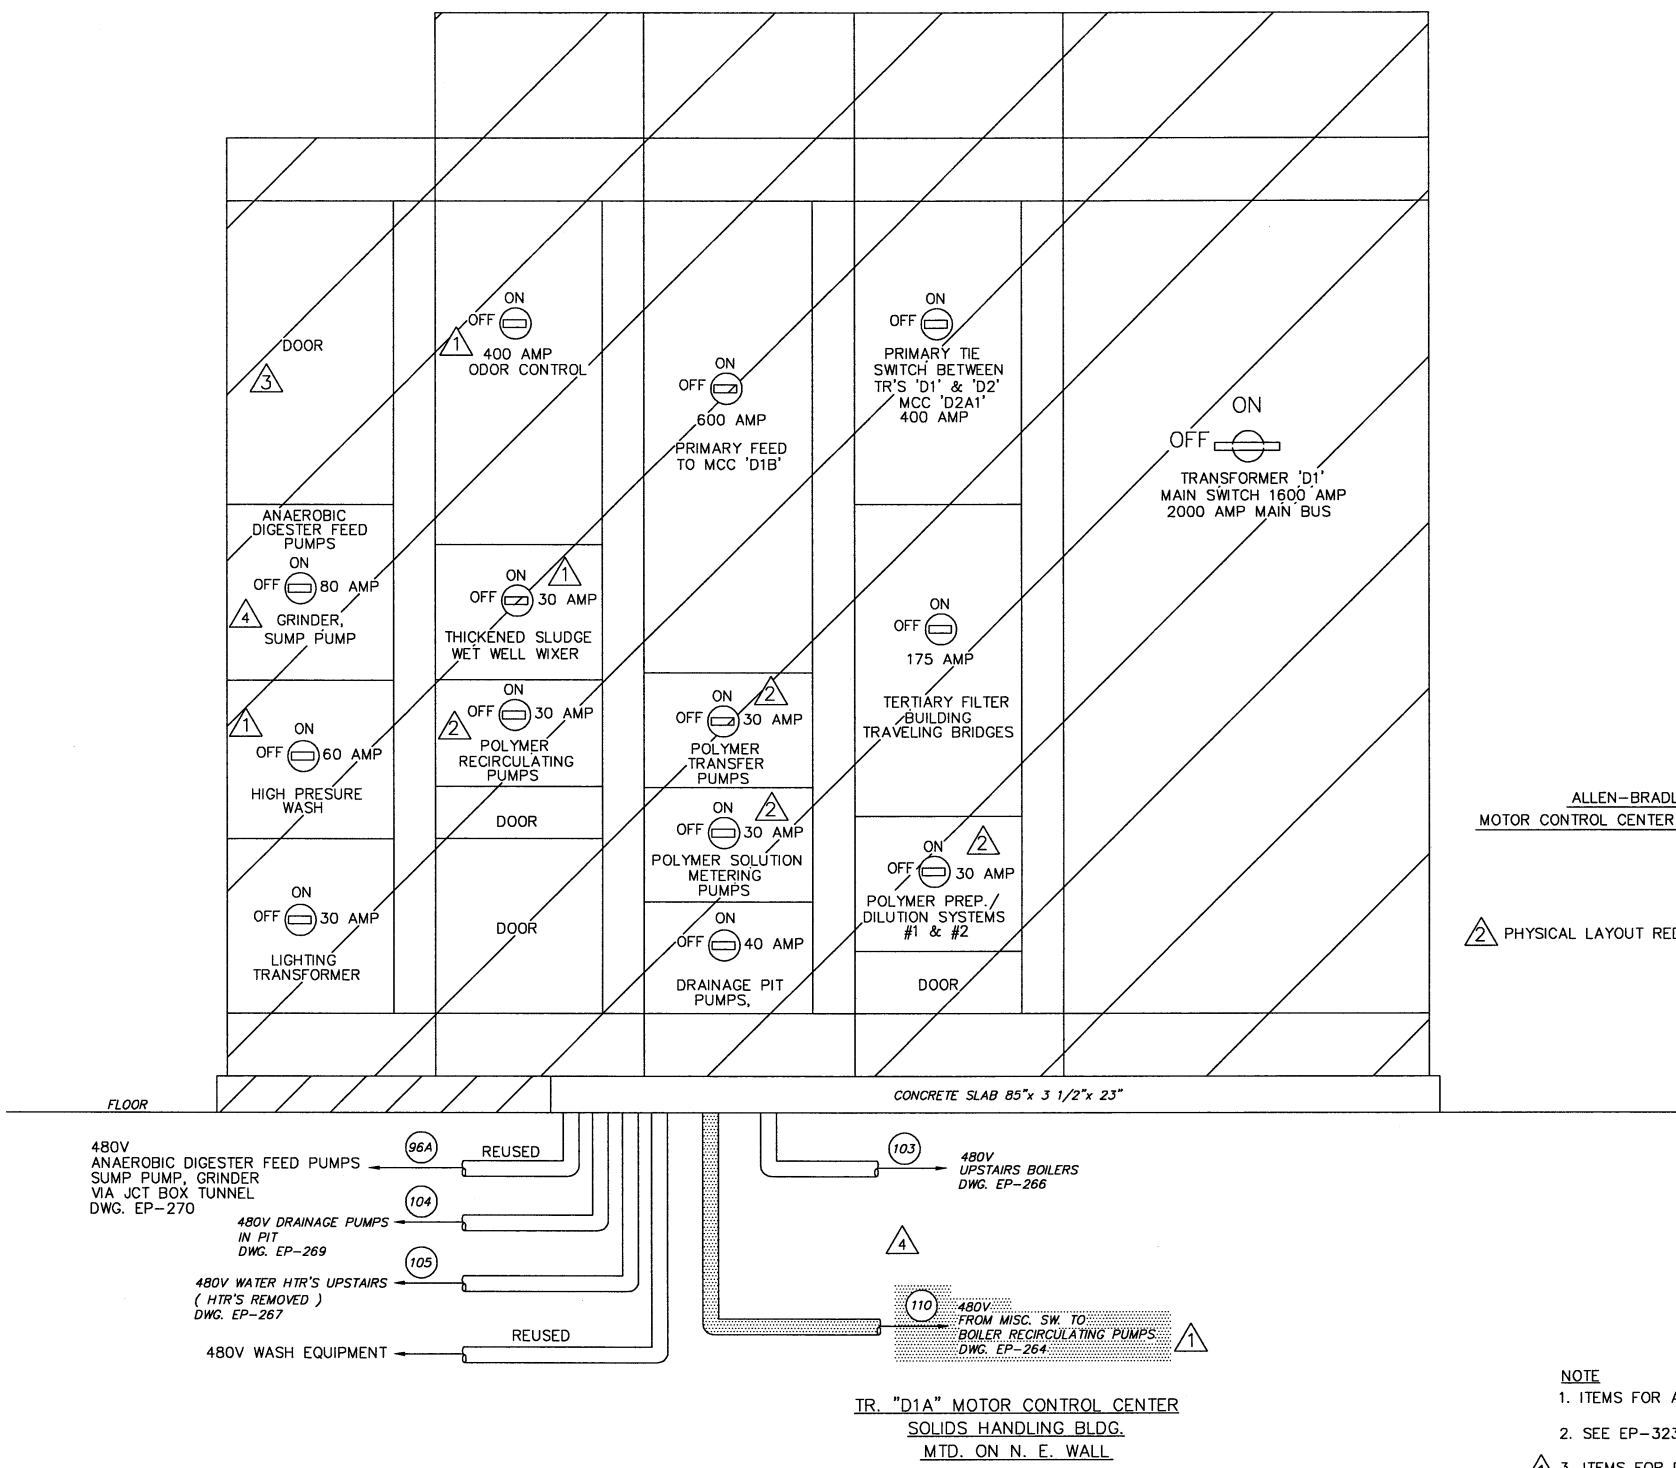

ALLEN-BRADLEY
MOTOR CONTROL CENTER SPEC. #16480

2 PHYSICAL LAYOUT REDRAWN

- NOTE
1. ITEMS FOR ADDITION
 2. SEE EP-323 FOR PLAN VIEW OF CONDUIT RUNS
 3. ITEMS FOR DEMOLITION

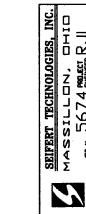

ENVIRONMENTAL, INC.
ENGINEERS IN WATER AND EARTH SCIENCES
UNION TOWN, OHIO



CITY OF MASSILLON, OHIO
WWTP UPGRADE 2000
TRANSFORMER "D1" - MOTOR CONTROL CENTER "D1A"
SOLIDS HANDLING BLDG. - MCC UNDERGROUND CONDUIT

JOB NO.	E9031
DATE	01/08/01
SCALE	1 1/2" = 12"
SHEET	EP263-4