


DESIGNED BY		REVISIONS		DATE		BY		APPD	
NO.	DESCRIPTIONS	NO.	DESCRIPTIONS	NO.	DESCRIPTIONS	NO.	DESCRIPTIONS	NO.	DESCRIPTIONS

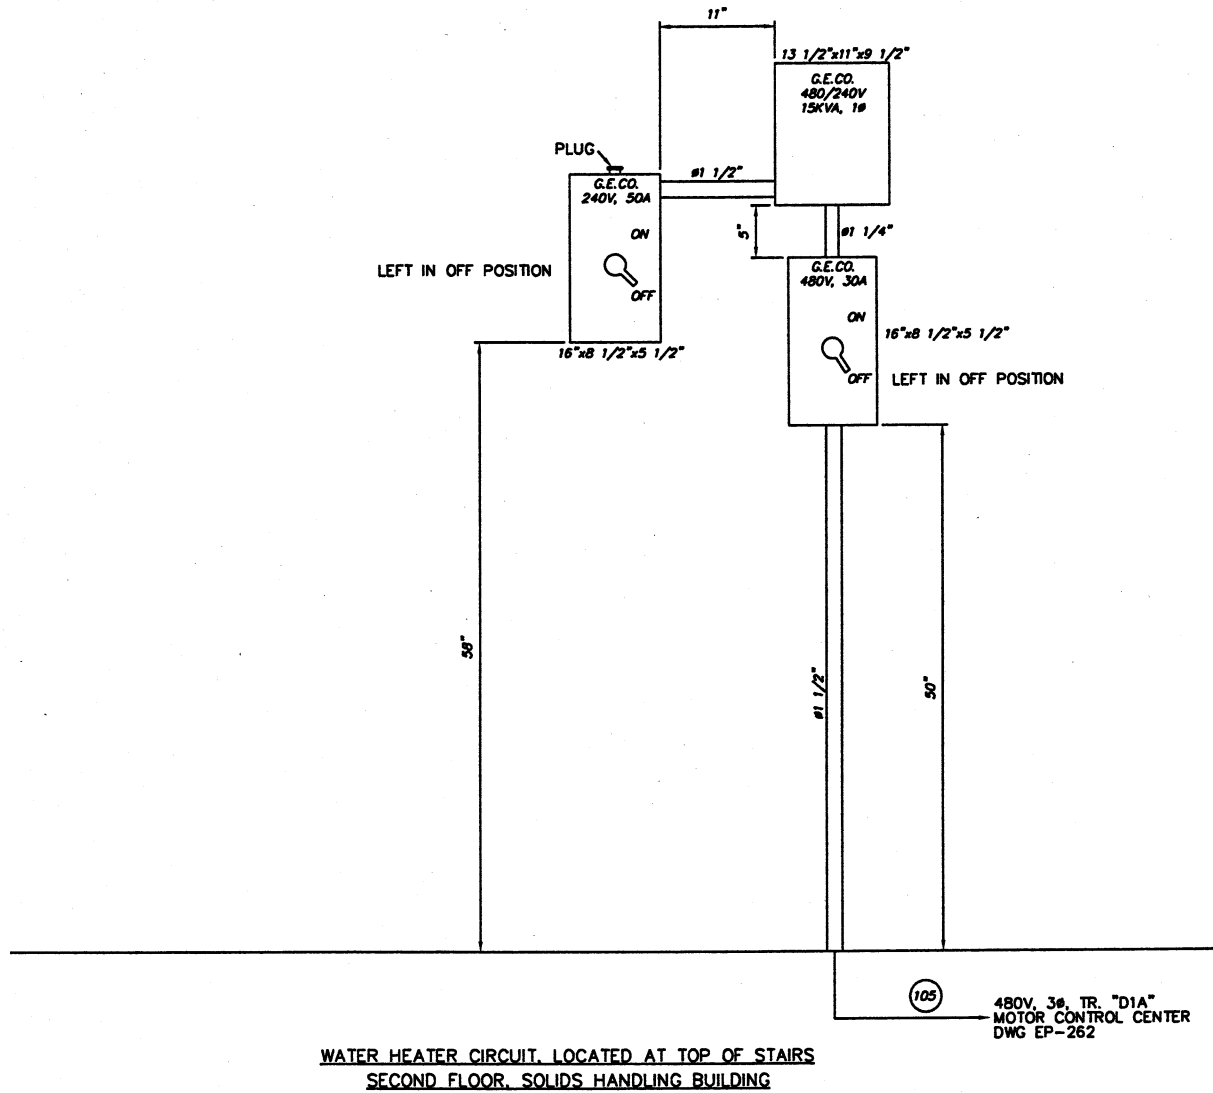

ENVIRONMENTAL, INC.
ENGINEERS IN WATER AND EARTH SCIENCES
UNIONTOWN, OHIO

CITY OF MASSILLON, OHIO
WWTP UPGRADE 2000
TRANSFORMER "D1", WATER HEATER CKT
SOLIDS HANDLING BLDG

JOB NO.	E9031
DATE	2/15/01
SCALE	1 1/2" = 12"
SHEET	EP267