



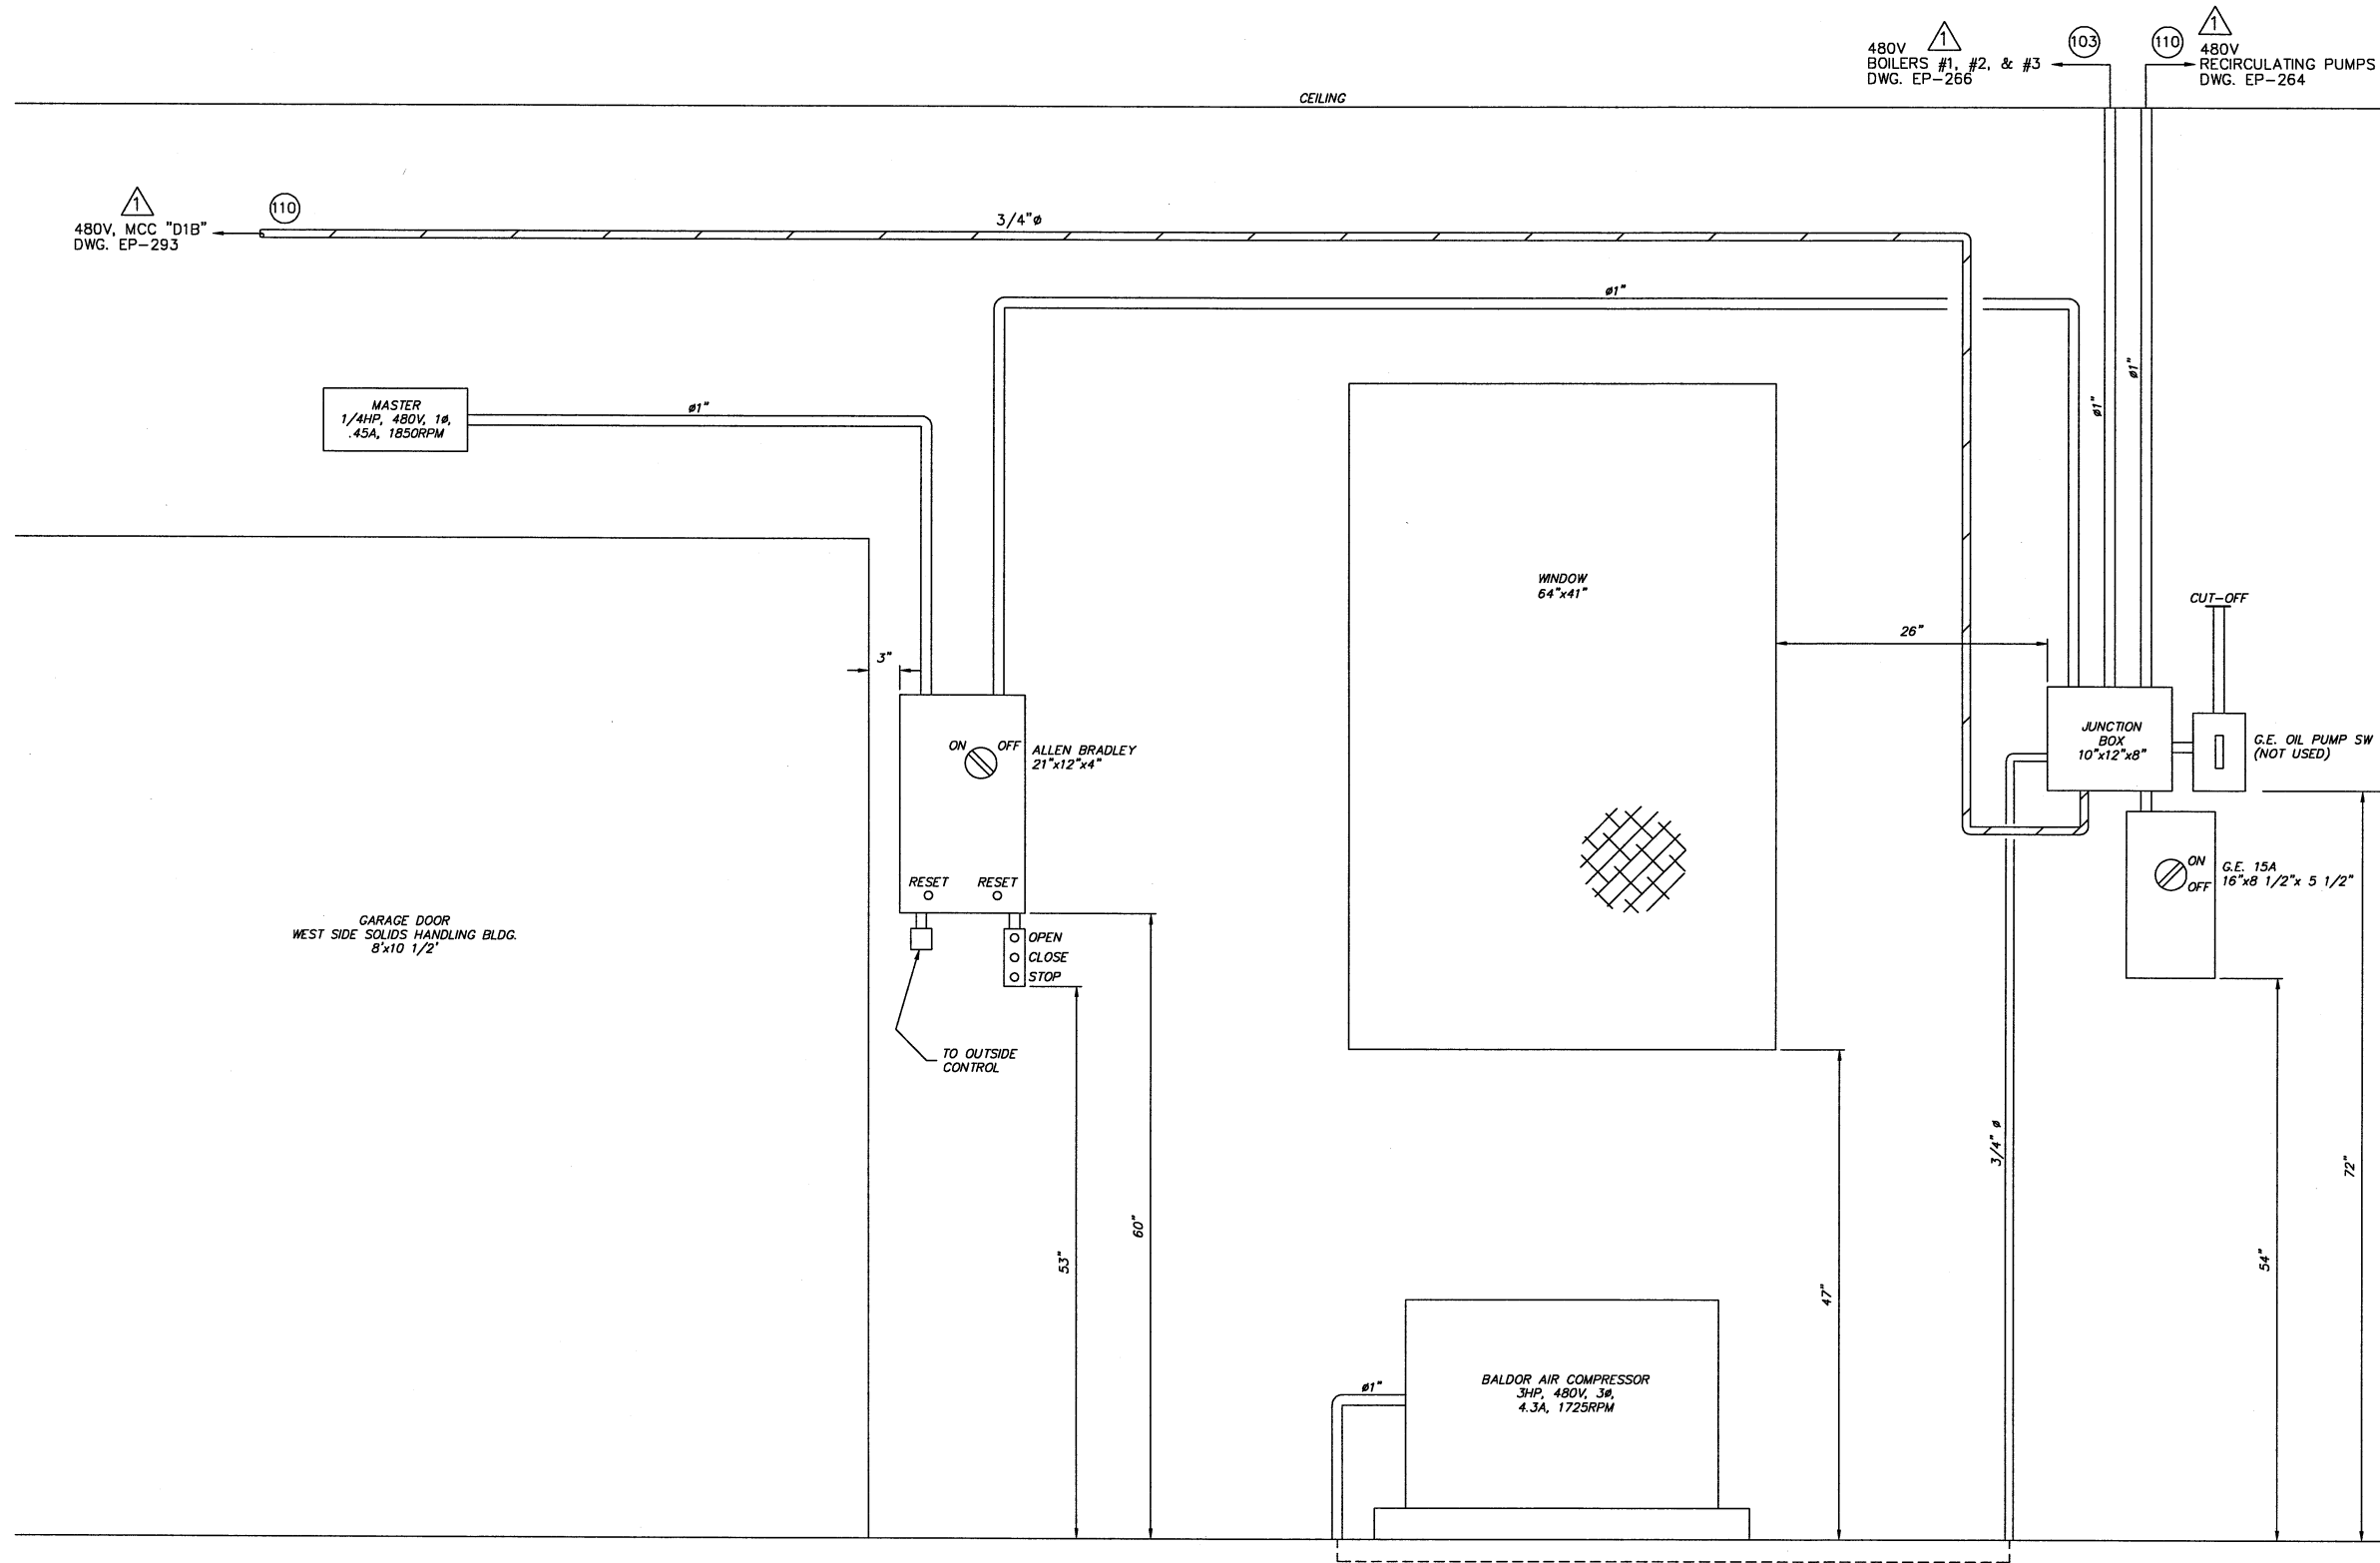

LOCATED IN SOLIDS HANDLING BLDG.
POLYMER STORAGE ROOM

NOTE
1. ITEMS FOR ADDITION

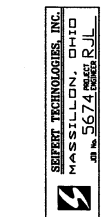

DESIGNED BY		REVISIONS		DATE		BY	
STI/TSS	STI/TSS	NO.	DESCRIPTIONS	DATE	BY	APPD	
STI/TSS	STI/TSS	1	REVISED PER CONSTRUCTION	7/26/03	TSS	RLL	
STI/TSS	STI/TSS						
STI/TSS	STI/TSS						
ENVIRONMENTAL, INC.
ENGINEERS IN WATER AND EARTH SCIENCES
UNIONTOWN, OHIO



CITY OF MASSILLON, OHIO
WWTP UPGRADE 2000
TRANSFORMER "D1", AIR COMP & GARAGE DOOR LAYOUT
SOLIDS HANDLING BLDG

JOB NO.	E9031
DATE	2/15/01
SCALE	1 1/2" = 12"
SHEET	EP268-1