


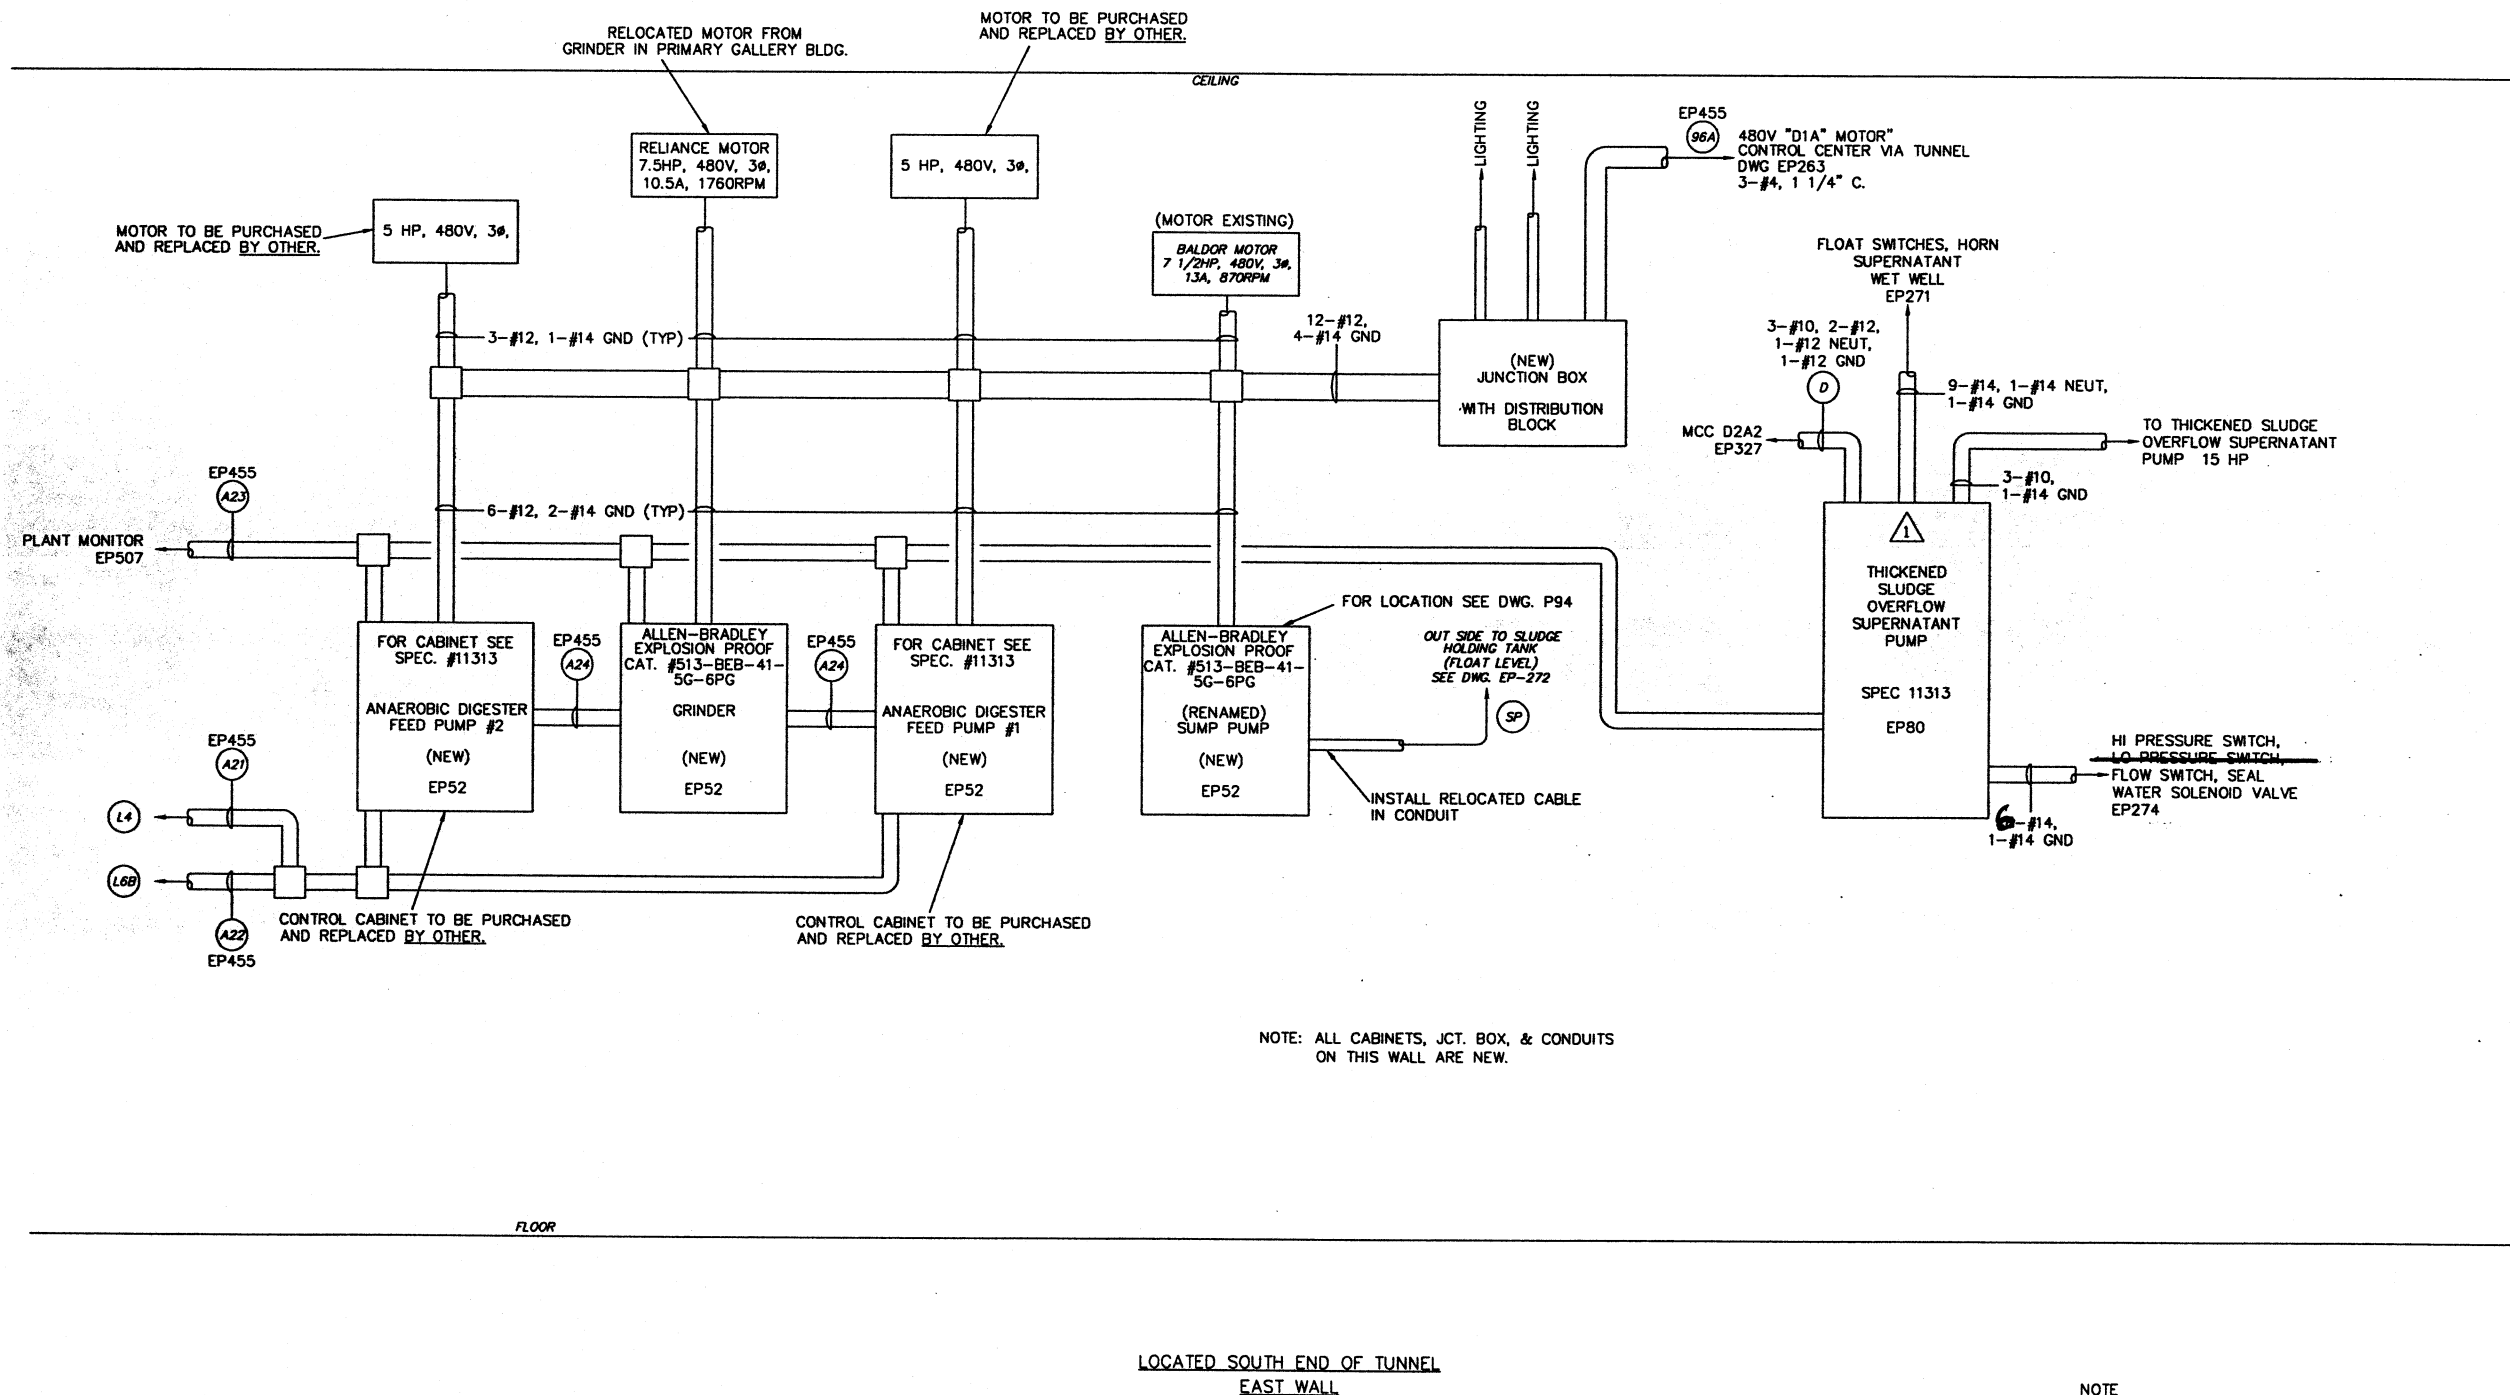

NO.	DESCRIPTIONS	DATE	BY	APP'D
1	ADDED SLUDGE PUMP	5/8/03	GCD	R.J.L.

ENVIRONMENTAL, INC.
ENGINEERS IN WATER AND EARTH SCIENCES
UNIONTOWN, OHIO



CITY OF MASSILLON, OHIO
WWTP UPGRADE 2000
TRANSFORMER "D1", CONTROL CABINET & PUMP SW LAYOUT
TRANSFORMER "D1", SOUTH END OF TUNNEL

NOTE
1. ALL BOXES, MOTORS, & CONDUITS TO MEET (NEC) CLASSIFIED HAZARDOUS LOCATION CLASS 1, DIVISION 1, GROUP D

JOB NO.	E9031
DATE	2/16/01
SCALE	1 1/2" = 12"
SHEET	EP270-1