


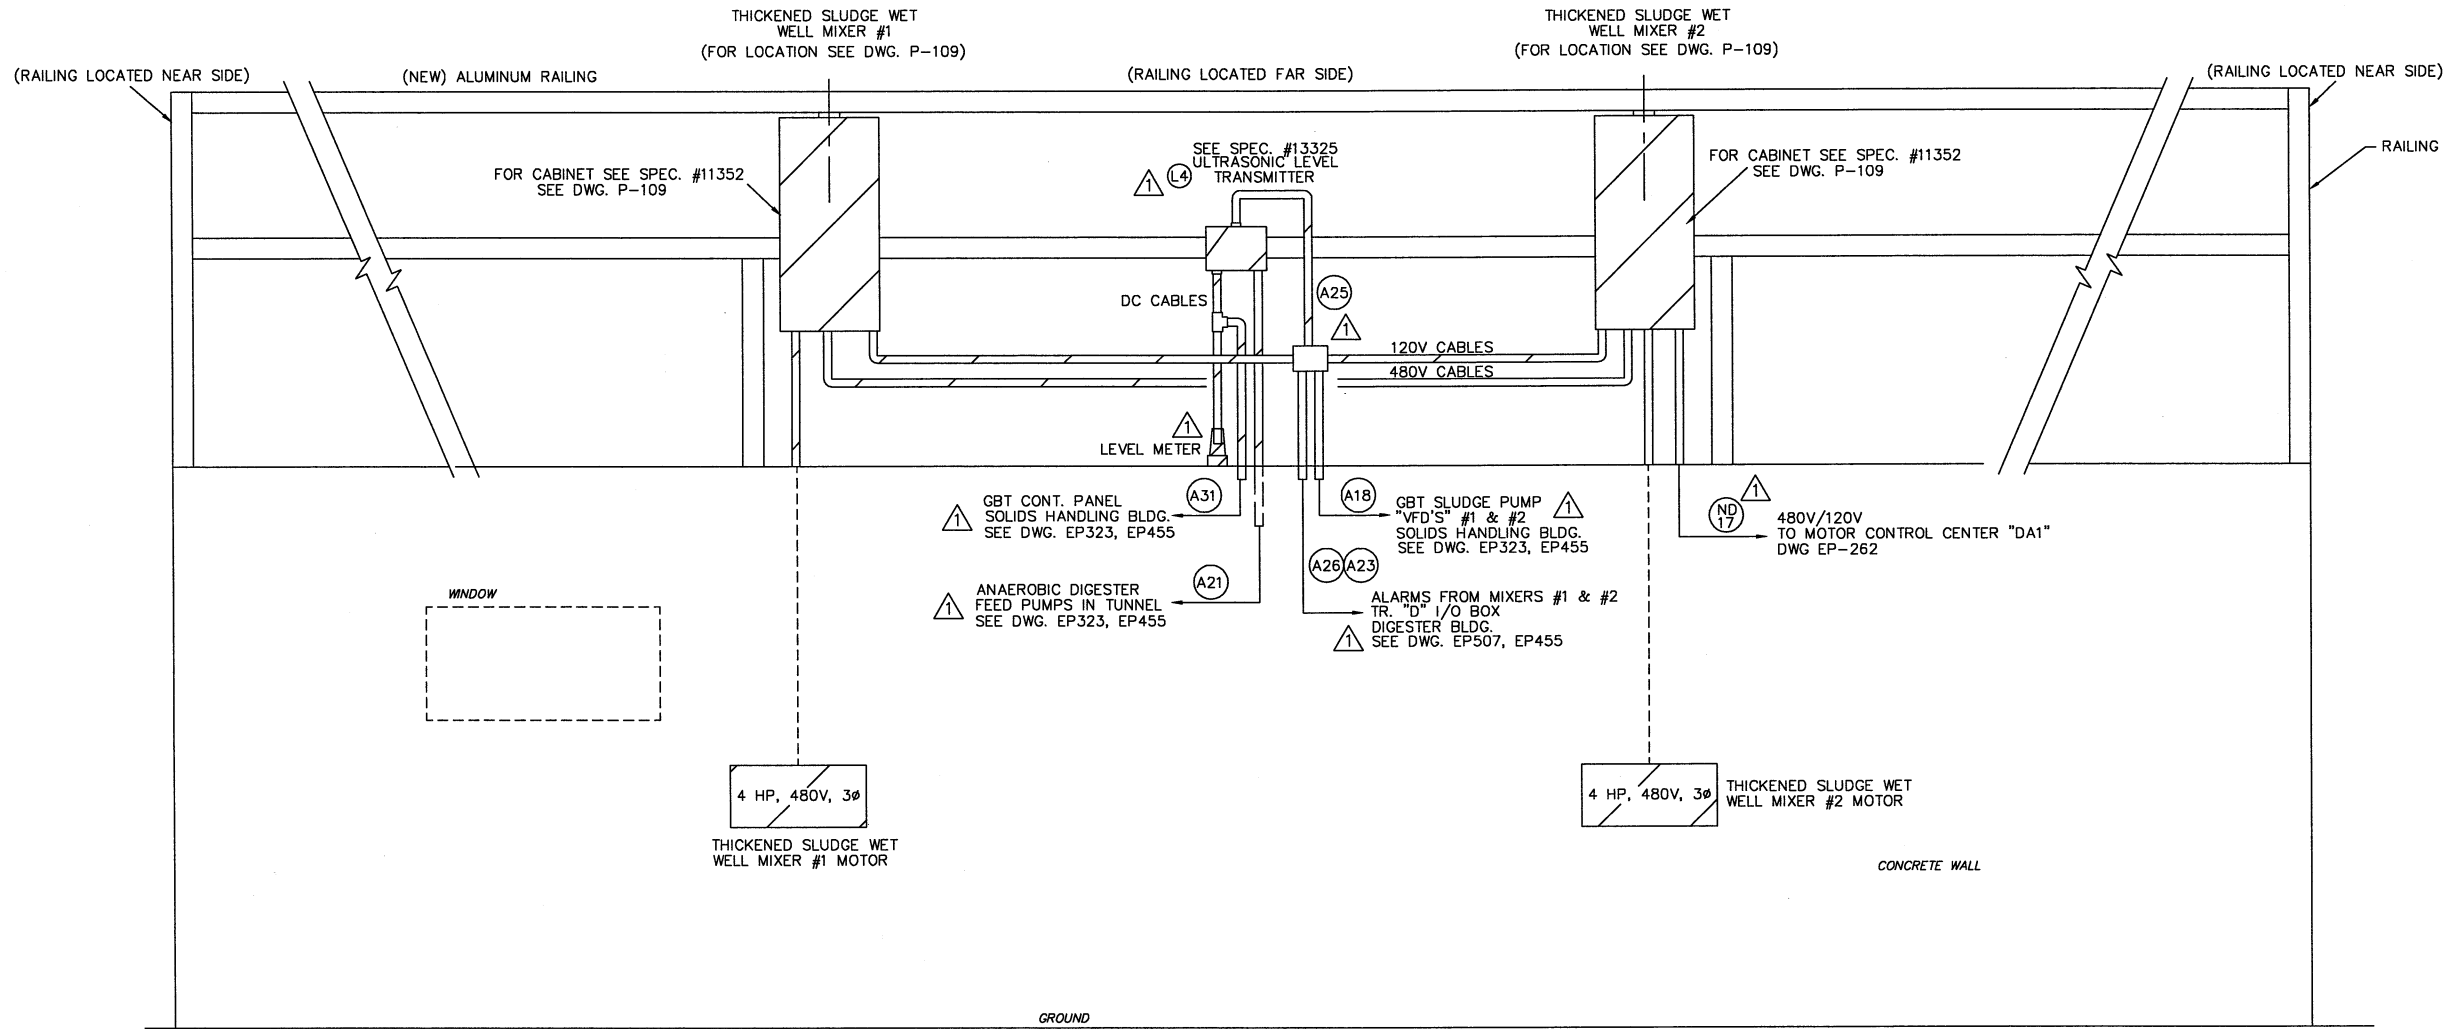

THICKENED SLUDGE WET WELL MIXERS
LOCATED AT SLUDGE HOLDING TANK
LOOKING EAST

- NOTE
- ITEMS FOR ADDITION
 - ALL CONDUIT IS 3/4" AS PER SPEC. #16111 UNLESS NOTED.



REVISIONS			
NO.	DESCRIPTIONS	DATE	BY
1	REVISED FOR CONSTRUCTION	7/26/03	TSS R/L
DESIGNED BY	STI/TSS		
DRAWN BY	STI/RRR		
CHECKED BY	STI/TSS		
APPROVED BY	STI/R/L		

ENVIRONMENTAL, INC.
ENGINEERS IN WATER AND EARTH SCIENCES
UNIONTOWN, OHIO



CITY OF MASSILLON, OHIO
WWTP UPGRADE 2000
TR "D1", THICKENED SLUDGE WET WELL MIXERS LAYOUT
SLUDGE HOLDING TANK

JOB NO.	E9031
DATE	4/27/01
SCALE	1 1/2" = 12"
SHEET	EP272-1