


1	LIGHTS	20A	2	NEW BOILERS	20A
3	LIGHTS	20A	4	SOL. HAND. UNIT #1 MONITOR CABINET	20A
5	LIGHTS	20A	6	SPARE	20A
7	SHOP LIGHTS	20A	8	SOL. HAND. UNIT #2 MONITOR CABINET	20A
9	CENTER LIGHTS	20A	10	SHOP-WEST WALL RECEPT	20A
11	OFFICE LIGHTS	20A	12	WATER HTR PHONE BUZZER	20A
13	UNKNOWN	20A	14	N.E. OUTLETS	20A
15	MARLOW TIMERS REC ON E. WALL	20A	16	OUTLETS - BIG OVERHEAD DOOR SINK	20A
17	UNKNOWN	20A	18	N.E. CONTROLS FOR GAS BURNER & N.W. WALL REC-SHOP	20A
19	S.E. HEATERS	20A	20	SPARE	---
21	N.W. LIGHTS OUTSIDE MERCURY	20A	22	SPARE	50A
23	S.W. HEATERS	20A	24	SHOP-EAST WALL RECEPT	20A
25	SHOP-NORTH WALL RECEPT	20A	26	OFFICE OUTLETS	20A
27	LIGHTS-TUNNEL UNDER DECANT	20A	28	SPARE	20A
29	OUTLETS BY BOILER CONTROL FIRST FLOOR	20A	30	AIR CONDITIONER	20A

BREAKER DETAIL

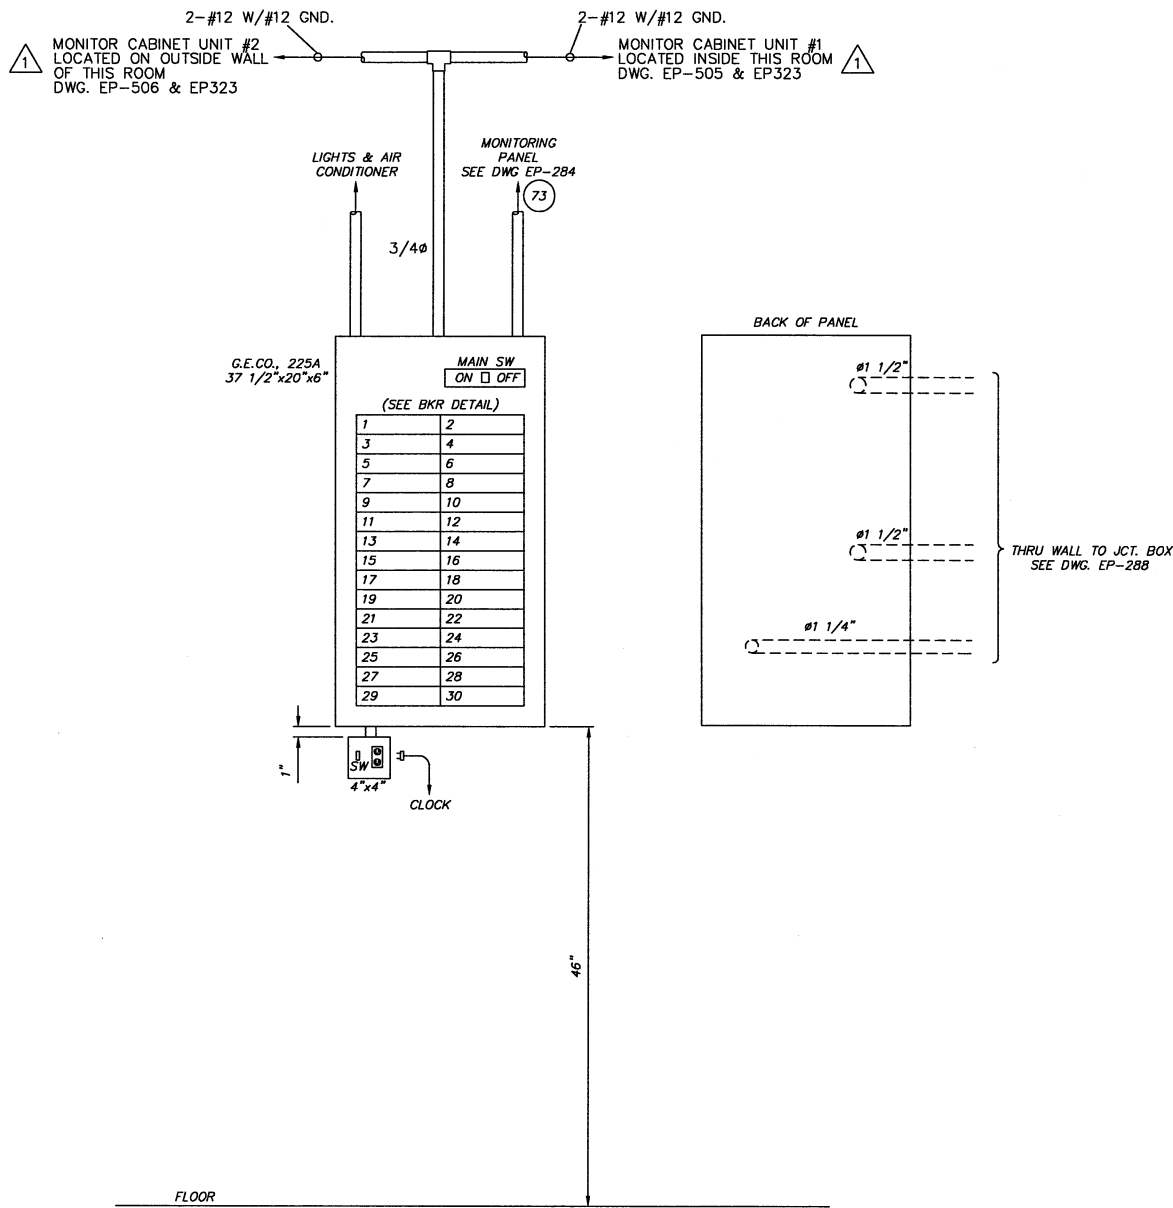

G.E. BREAKER BOX
LOCATED CENTER ROOM SOLIDS HANDLING BLDG.

NOTE
1. ITEMS FOR ADDITION

SHEEP TECHNOLOGIES, INC.
MASSILLON, OHIO
5674 R.J.L.

DESIGNED BY: STI/TSS
 DRAWN BY: STI/TSS
 CHECKED BY: STI/TSS
 APPROVED BY: STI/R/L

REVISIONS
 NO. 1
 DESCRIPTION: REVISED FOR CONSTRUCTION
 DATE: 7/29/03
 BY: TSS

ENVIRONMENTAL, INC.
 ENVIRONMENTAL WATER AND EARTH SCIENCES
 UNIONTOWN, OHIO

CITY OF MASSILLON, OHIO
 WWTP UPGRADE 2000
 TRANSFORMER "DT", BREAKER PANEL
 SOLIDS HANDLING BLDG

JOB NO.
E9031
 DATE
2/16/01
 SCALE
1 1/2" = 12"
 SHEET
EP285-1

9031SPLE285.DWG