


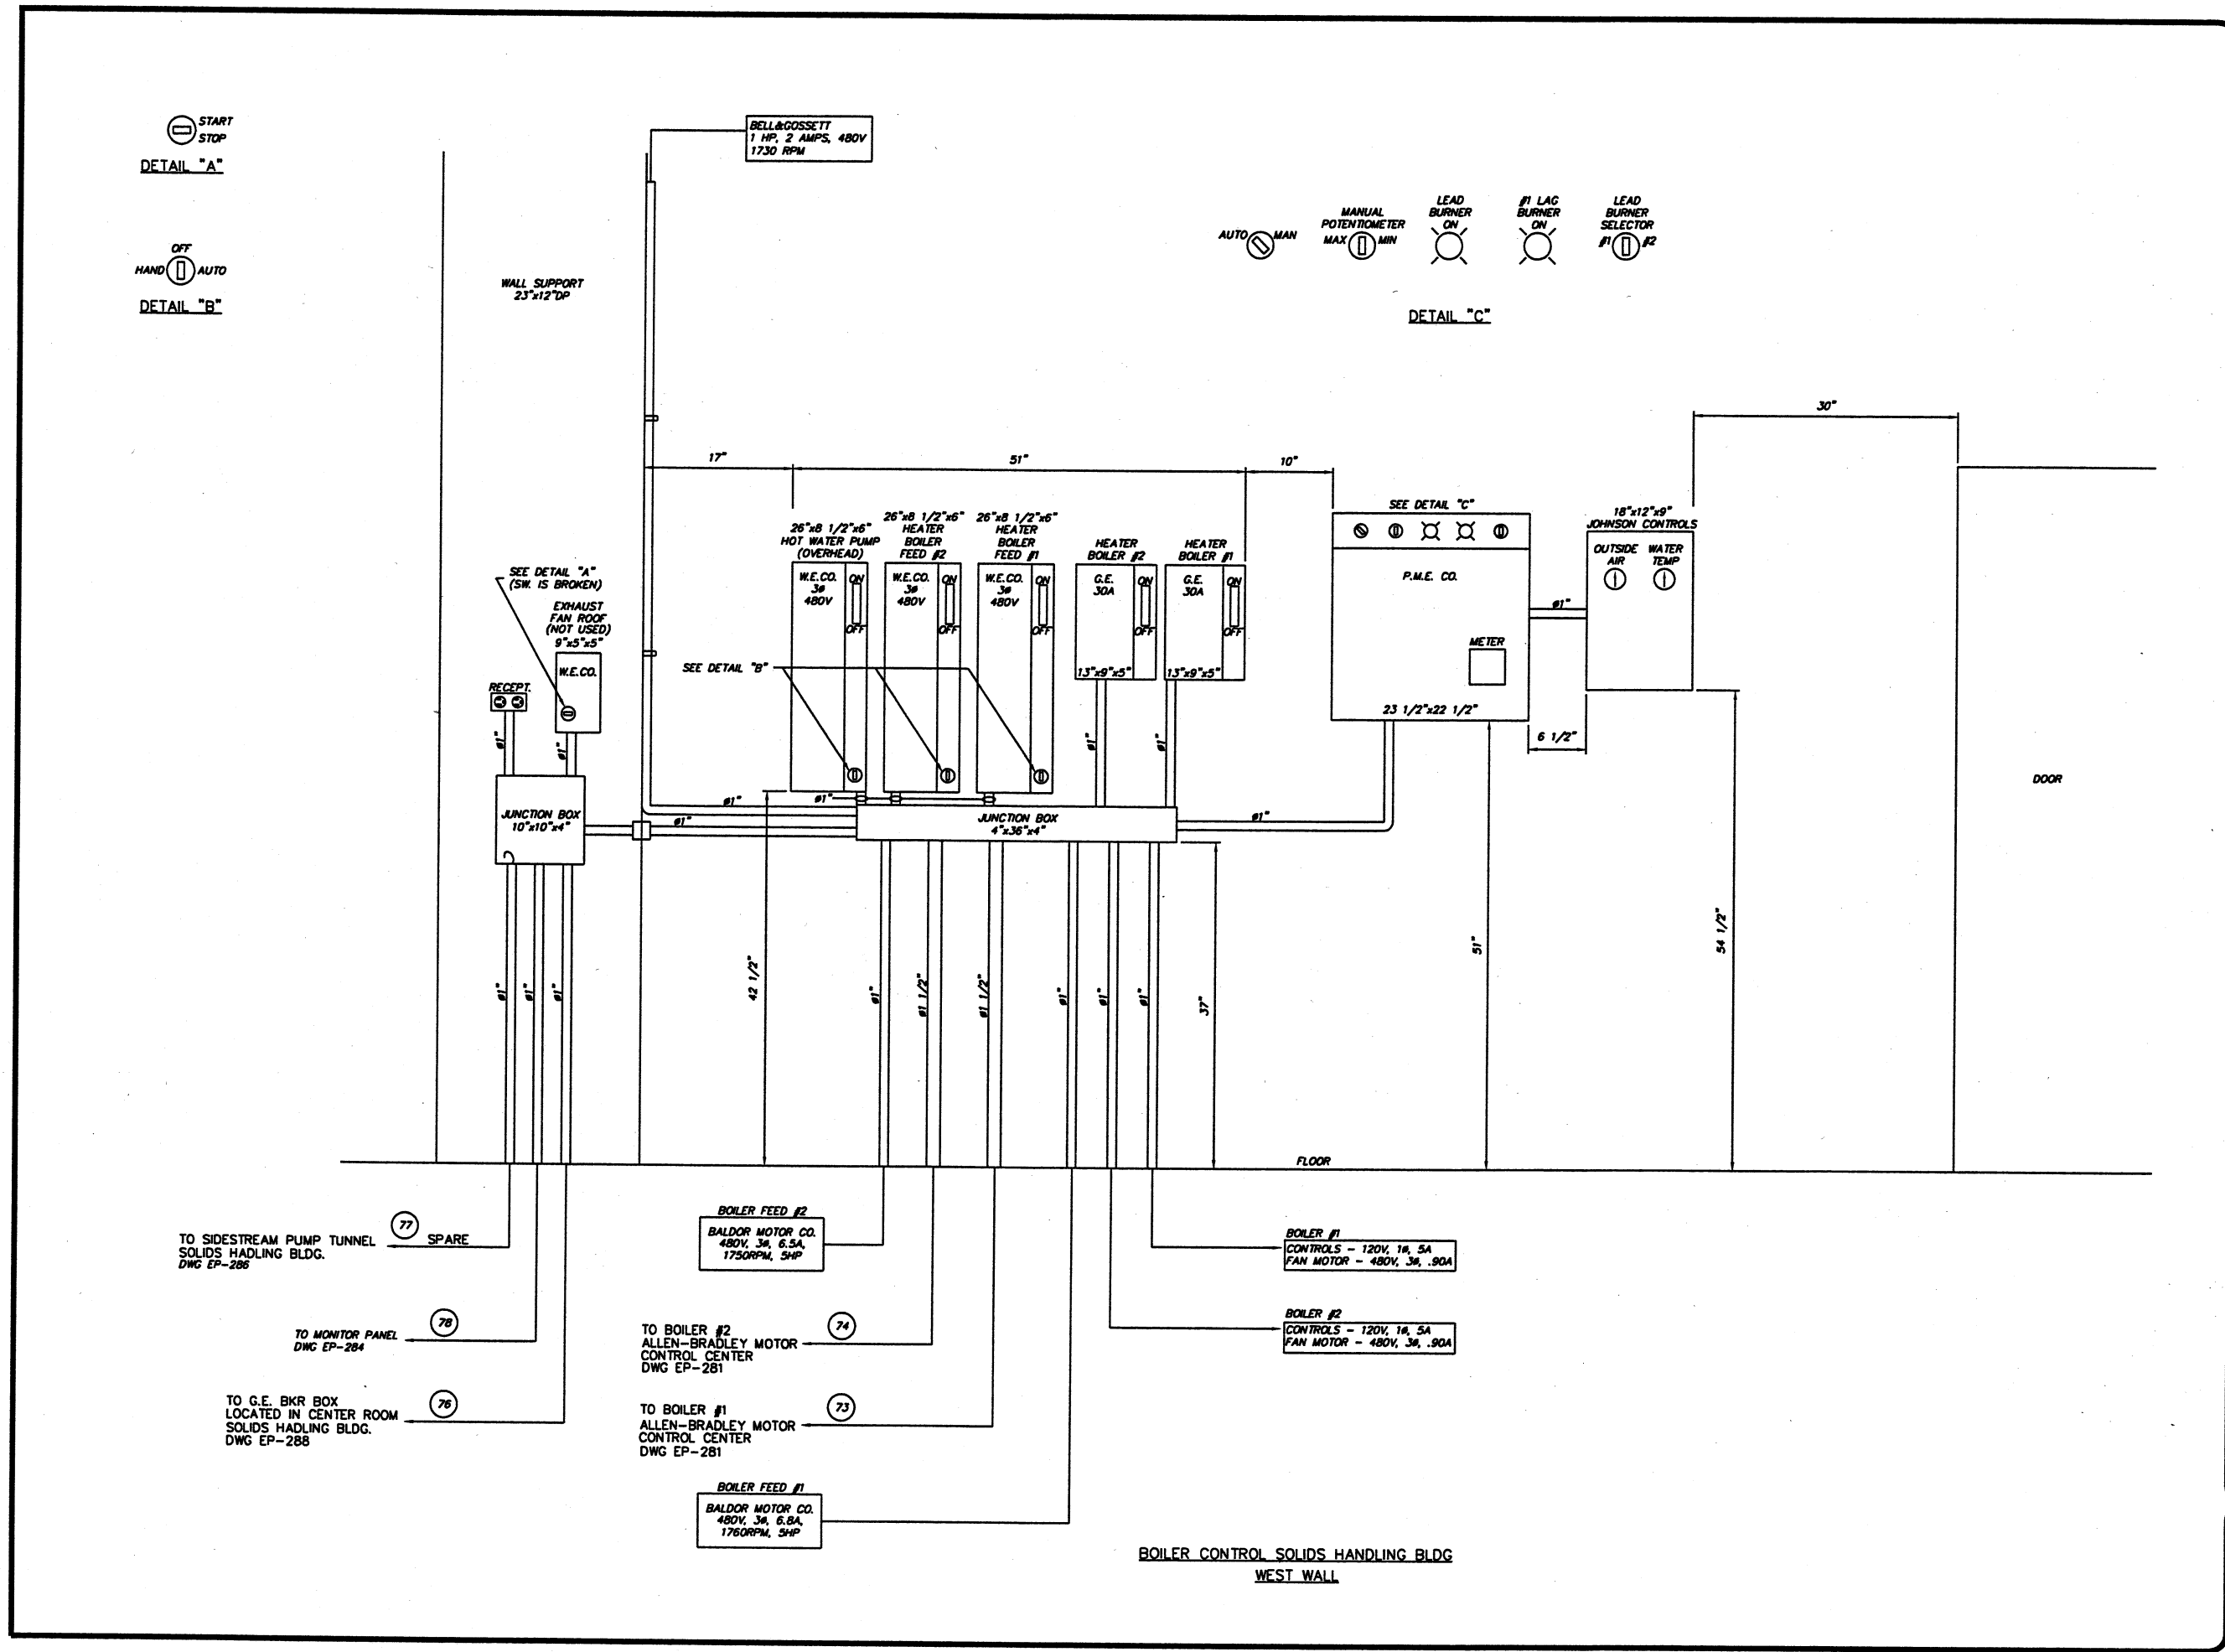

START
STOP
DETAIL "A"

OFF
HAND AUTO
DETAIL "B"

AUTO MAN
MANUAL
POTENTIOMETER
MAX MIN
LEAD
BURNER
ON
#1 LAG
BURNER
ON
LEAD
BURNER
SELECTOR
#1 #2

DETAIL "C"

ENVIRONMENTAL, INC.
ENGINEERS IN WATER AND EARTH SCIENCES
UNIONTOWN, OHIO

CTI

CITY OF MASSILLON, OHIO
WWTP UPGRADE 2000
TRANSFORMER "D1" BOILER CONTROL LAYOUT
SOLIDS HANDLING BLDG (WEST WALL)

DESIGNED BY		REVISIONS		DATE		BY		APP'D	
NO.	DESCRIPTION	NO.	DESCRIPTION	NO.	DESCRIPTION	NO.	DESCRIPTION	NO.	DESCRIPTION

JOB NO.
E9031

DATE
2/16/01

SCALE
1 1/2" = 12"

SHEET
EP291

9031SPLE291.DWG