
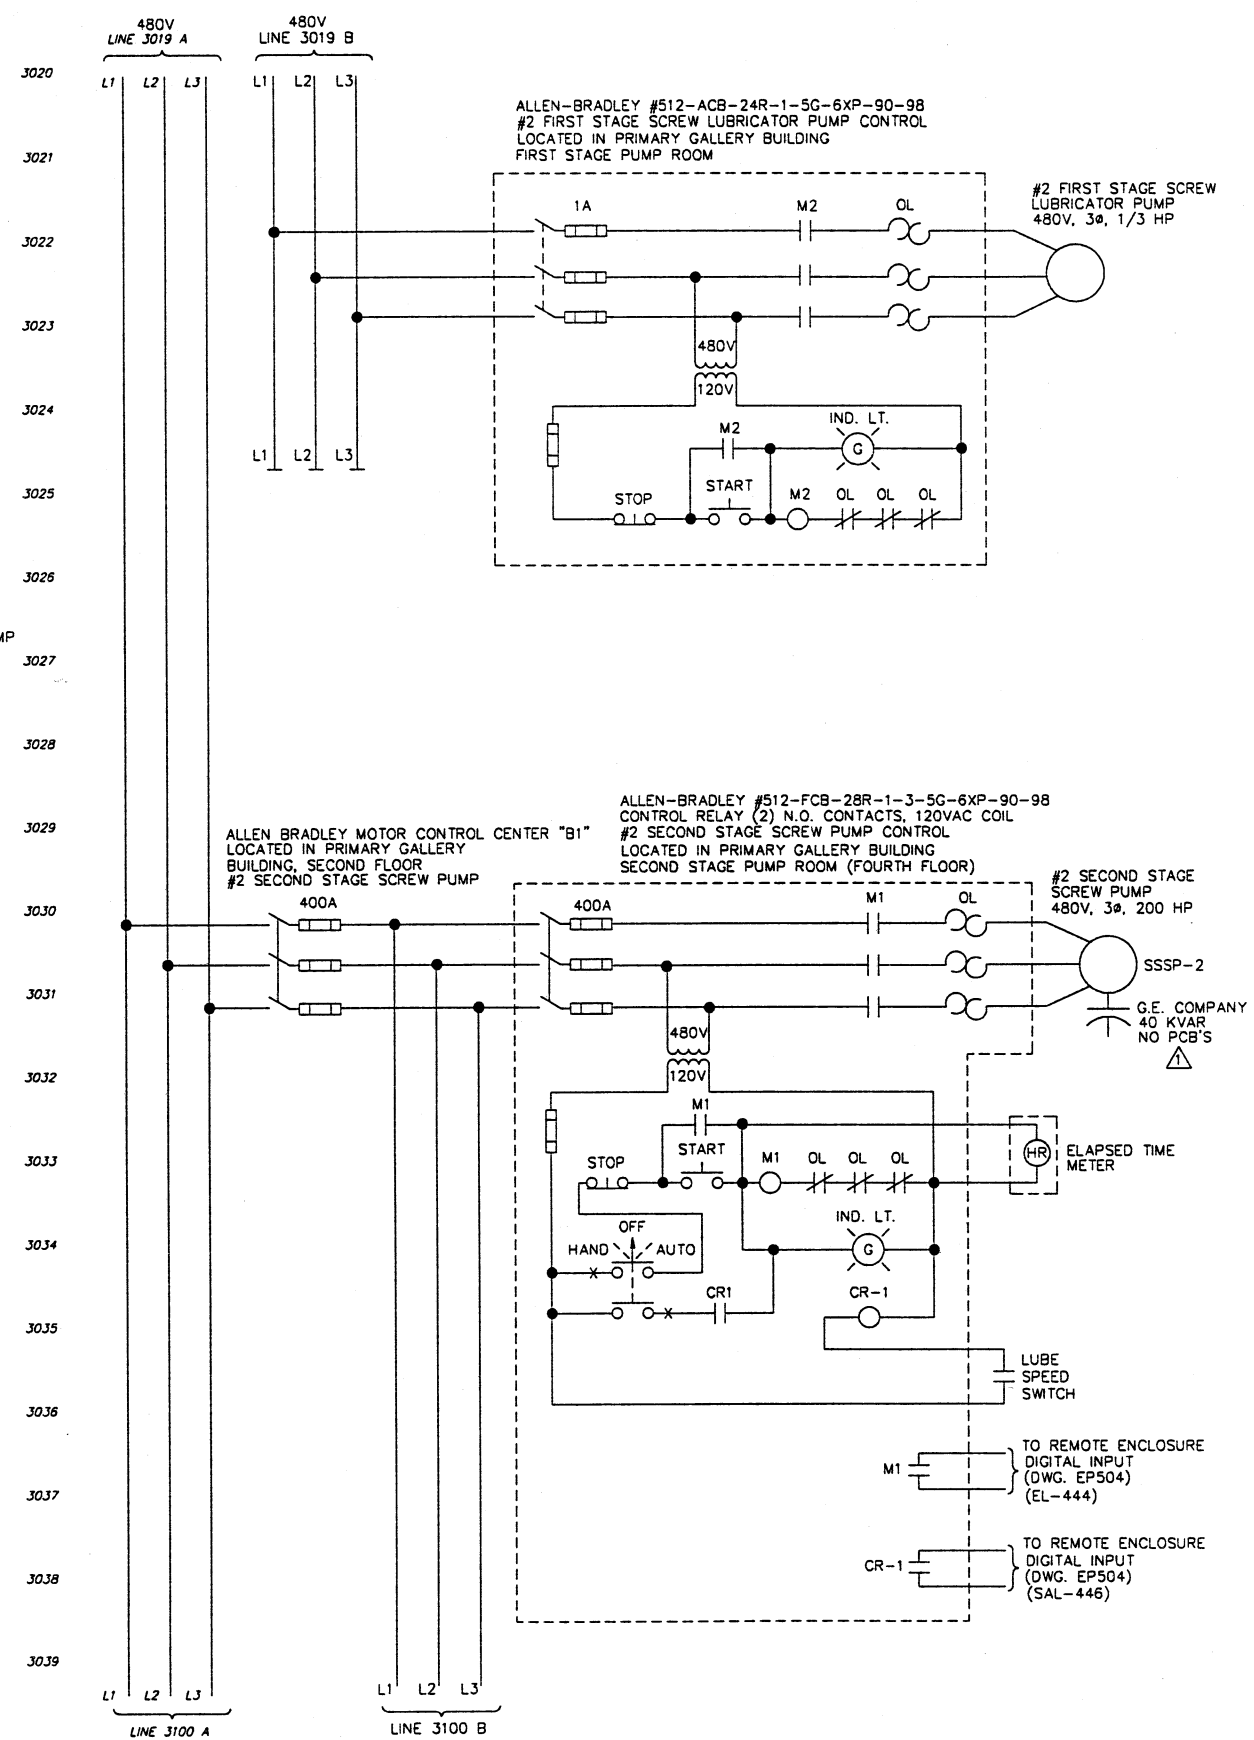
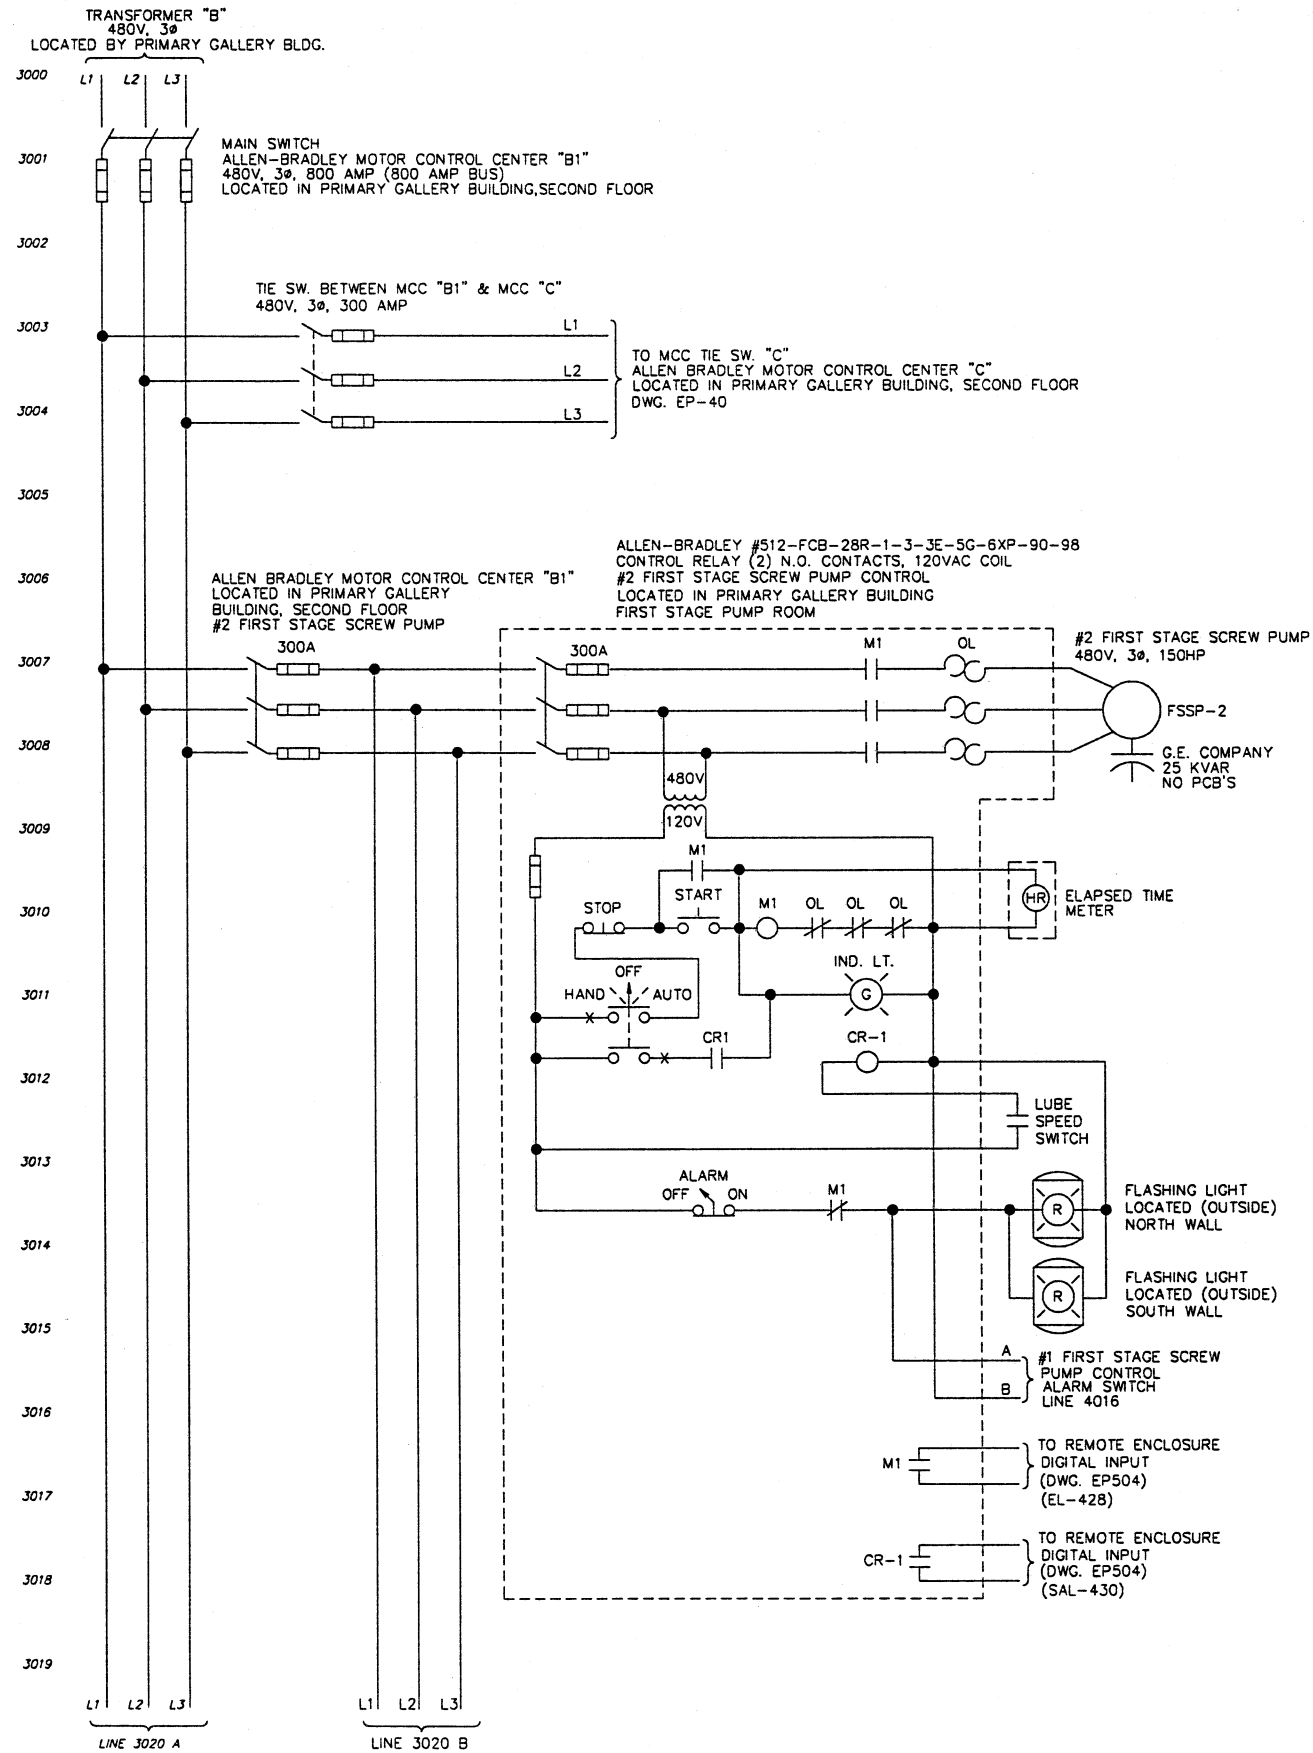
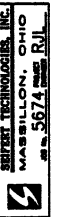
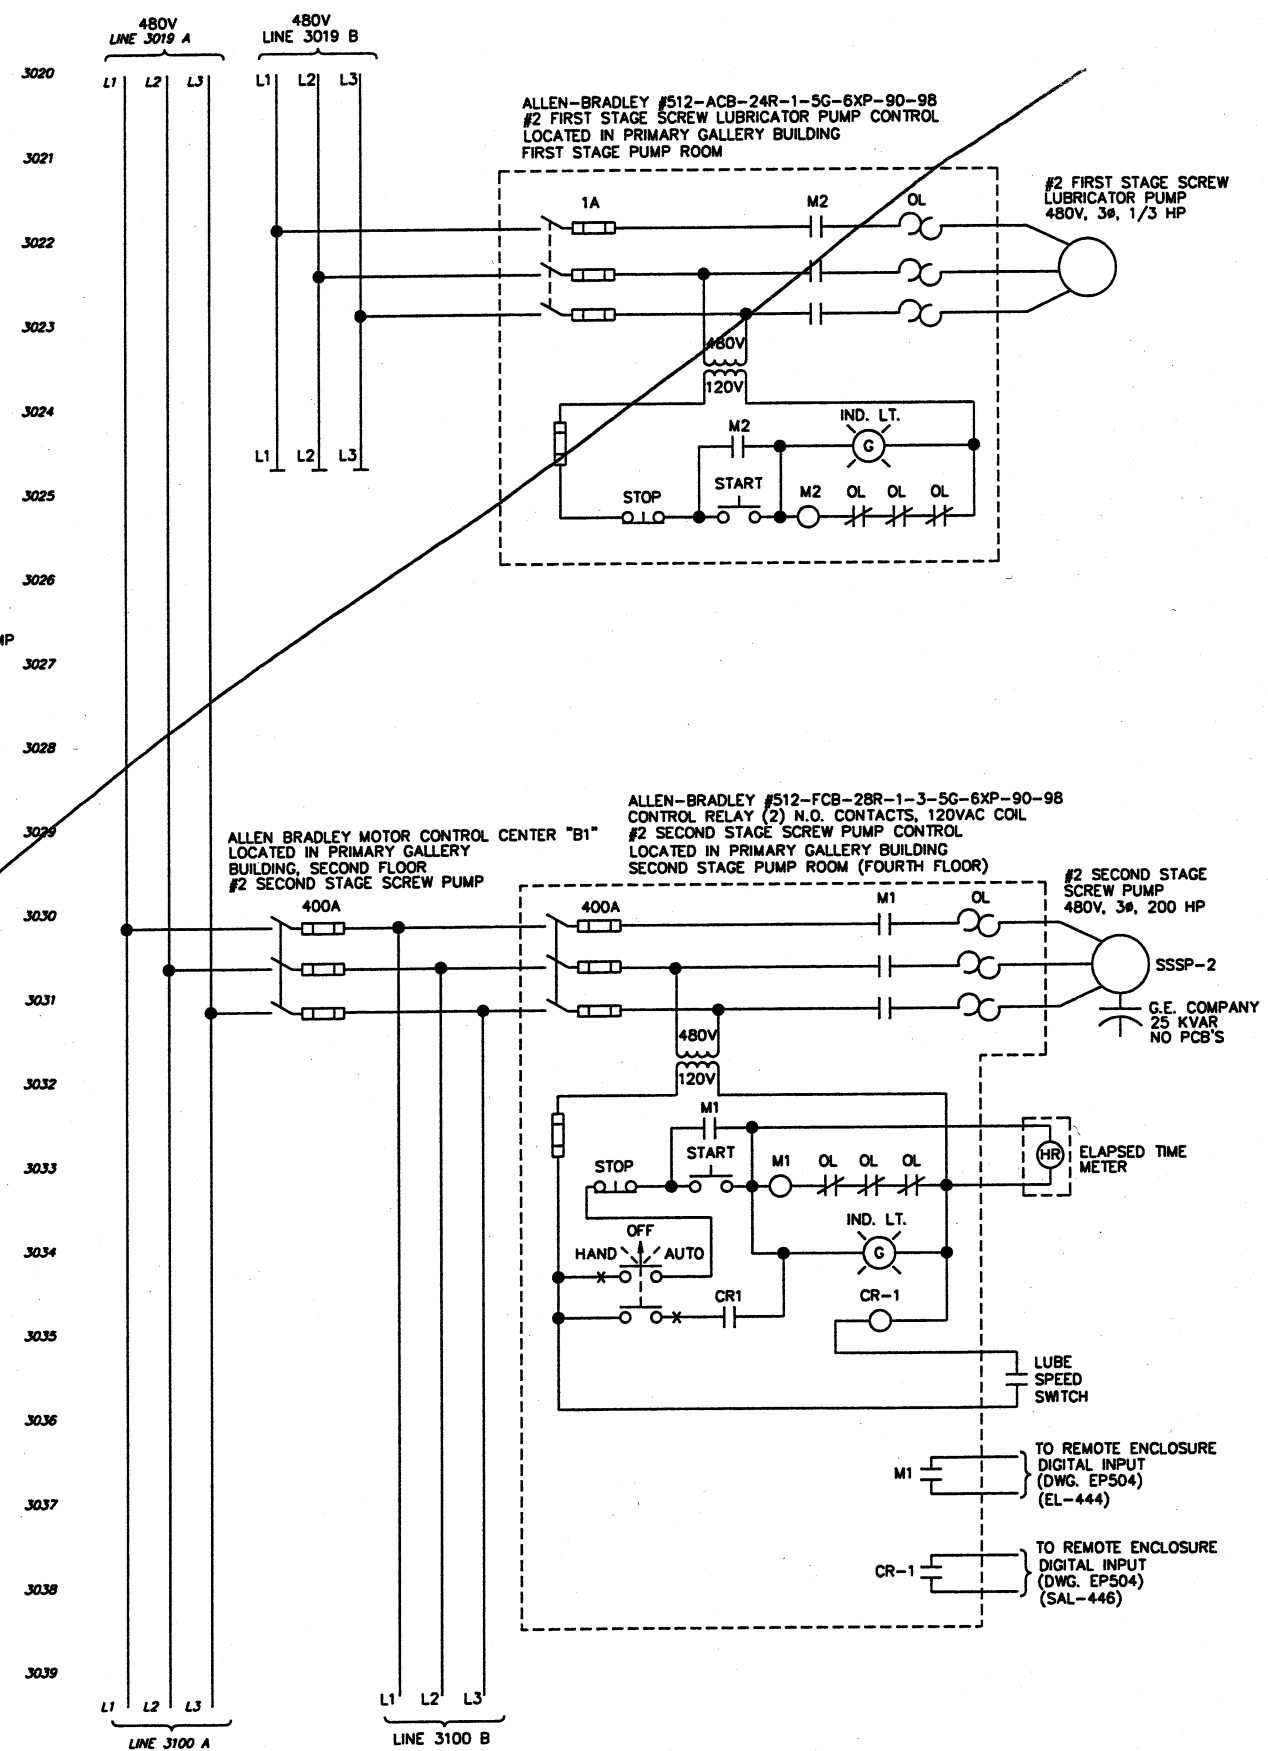


DESIGNED BY	STI/TSS	DATE	BY	APP'D
DRAWN BY	STI/TSS	9/13/00	TSS	
CHECKED BY	STI/TSS			
APPROVED BY	STI/TSS			
IF STI/TSS				

ENVIRONMENTAL, INC.
ENGINEERS IN WATER AND EARTH SCIENCES
UNIONTOWN, OHIO

CITY OF MASSILLON, OHIO
WWTP UPGRADE 2000
TRANSFORMER "B", MCC-B1
SCREW PUMPS SCHEMATIC DIAGRAM

JOB NO. E9031
DATE 2/16/01
SCALE N/A
SHEET EP30

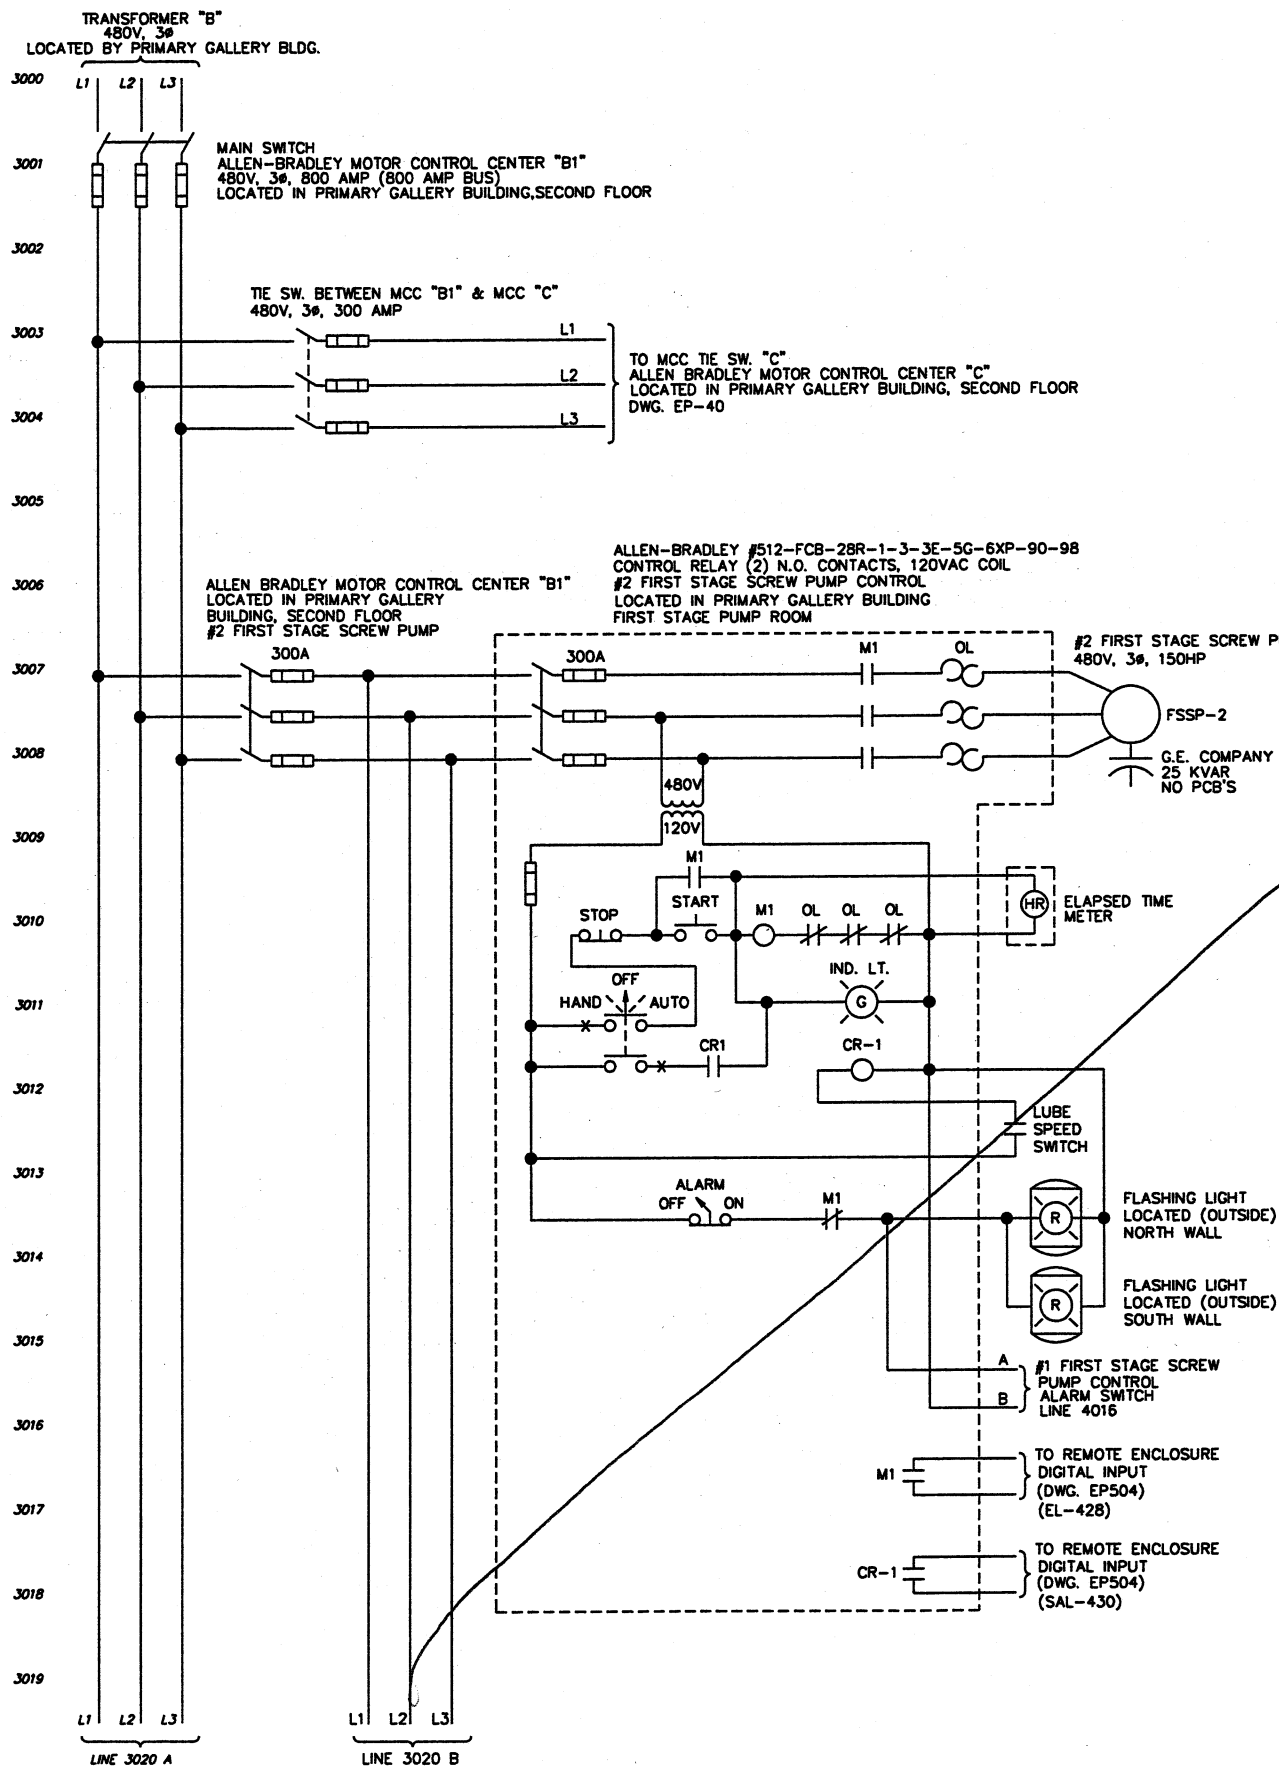

REVISIONS				
	NO.	DESCRIPTIONS	DATE	BY
DESIGNED BY	STI/TSS			
DRAWN BY	STI/TSS			
CHECKED BY	STI/TSS			
APPROVED BY	STI/R/L			

ENVIRONMENTAL, INC.
ENGINEERS IN WATER AND EARTH SCIENCES
UNIONTOWN, OHIO

CITY OF MASSILLON, OHIO
WWTP UPGRADE 2000
TRANSFORMER "B", MCC-B1
SCREW PUMPS SCHEMATIC DIAGRAM

JOB NO.	E9031
DATE	2/16/01
SCALE	N/A
SHEET	EP30