


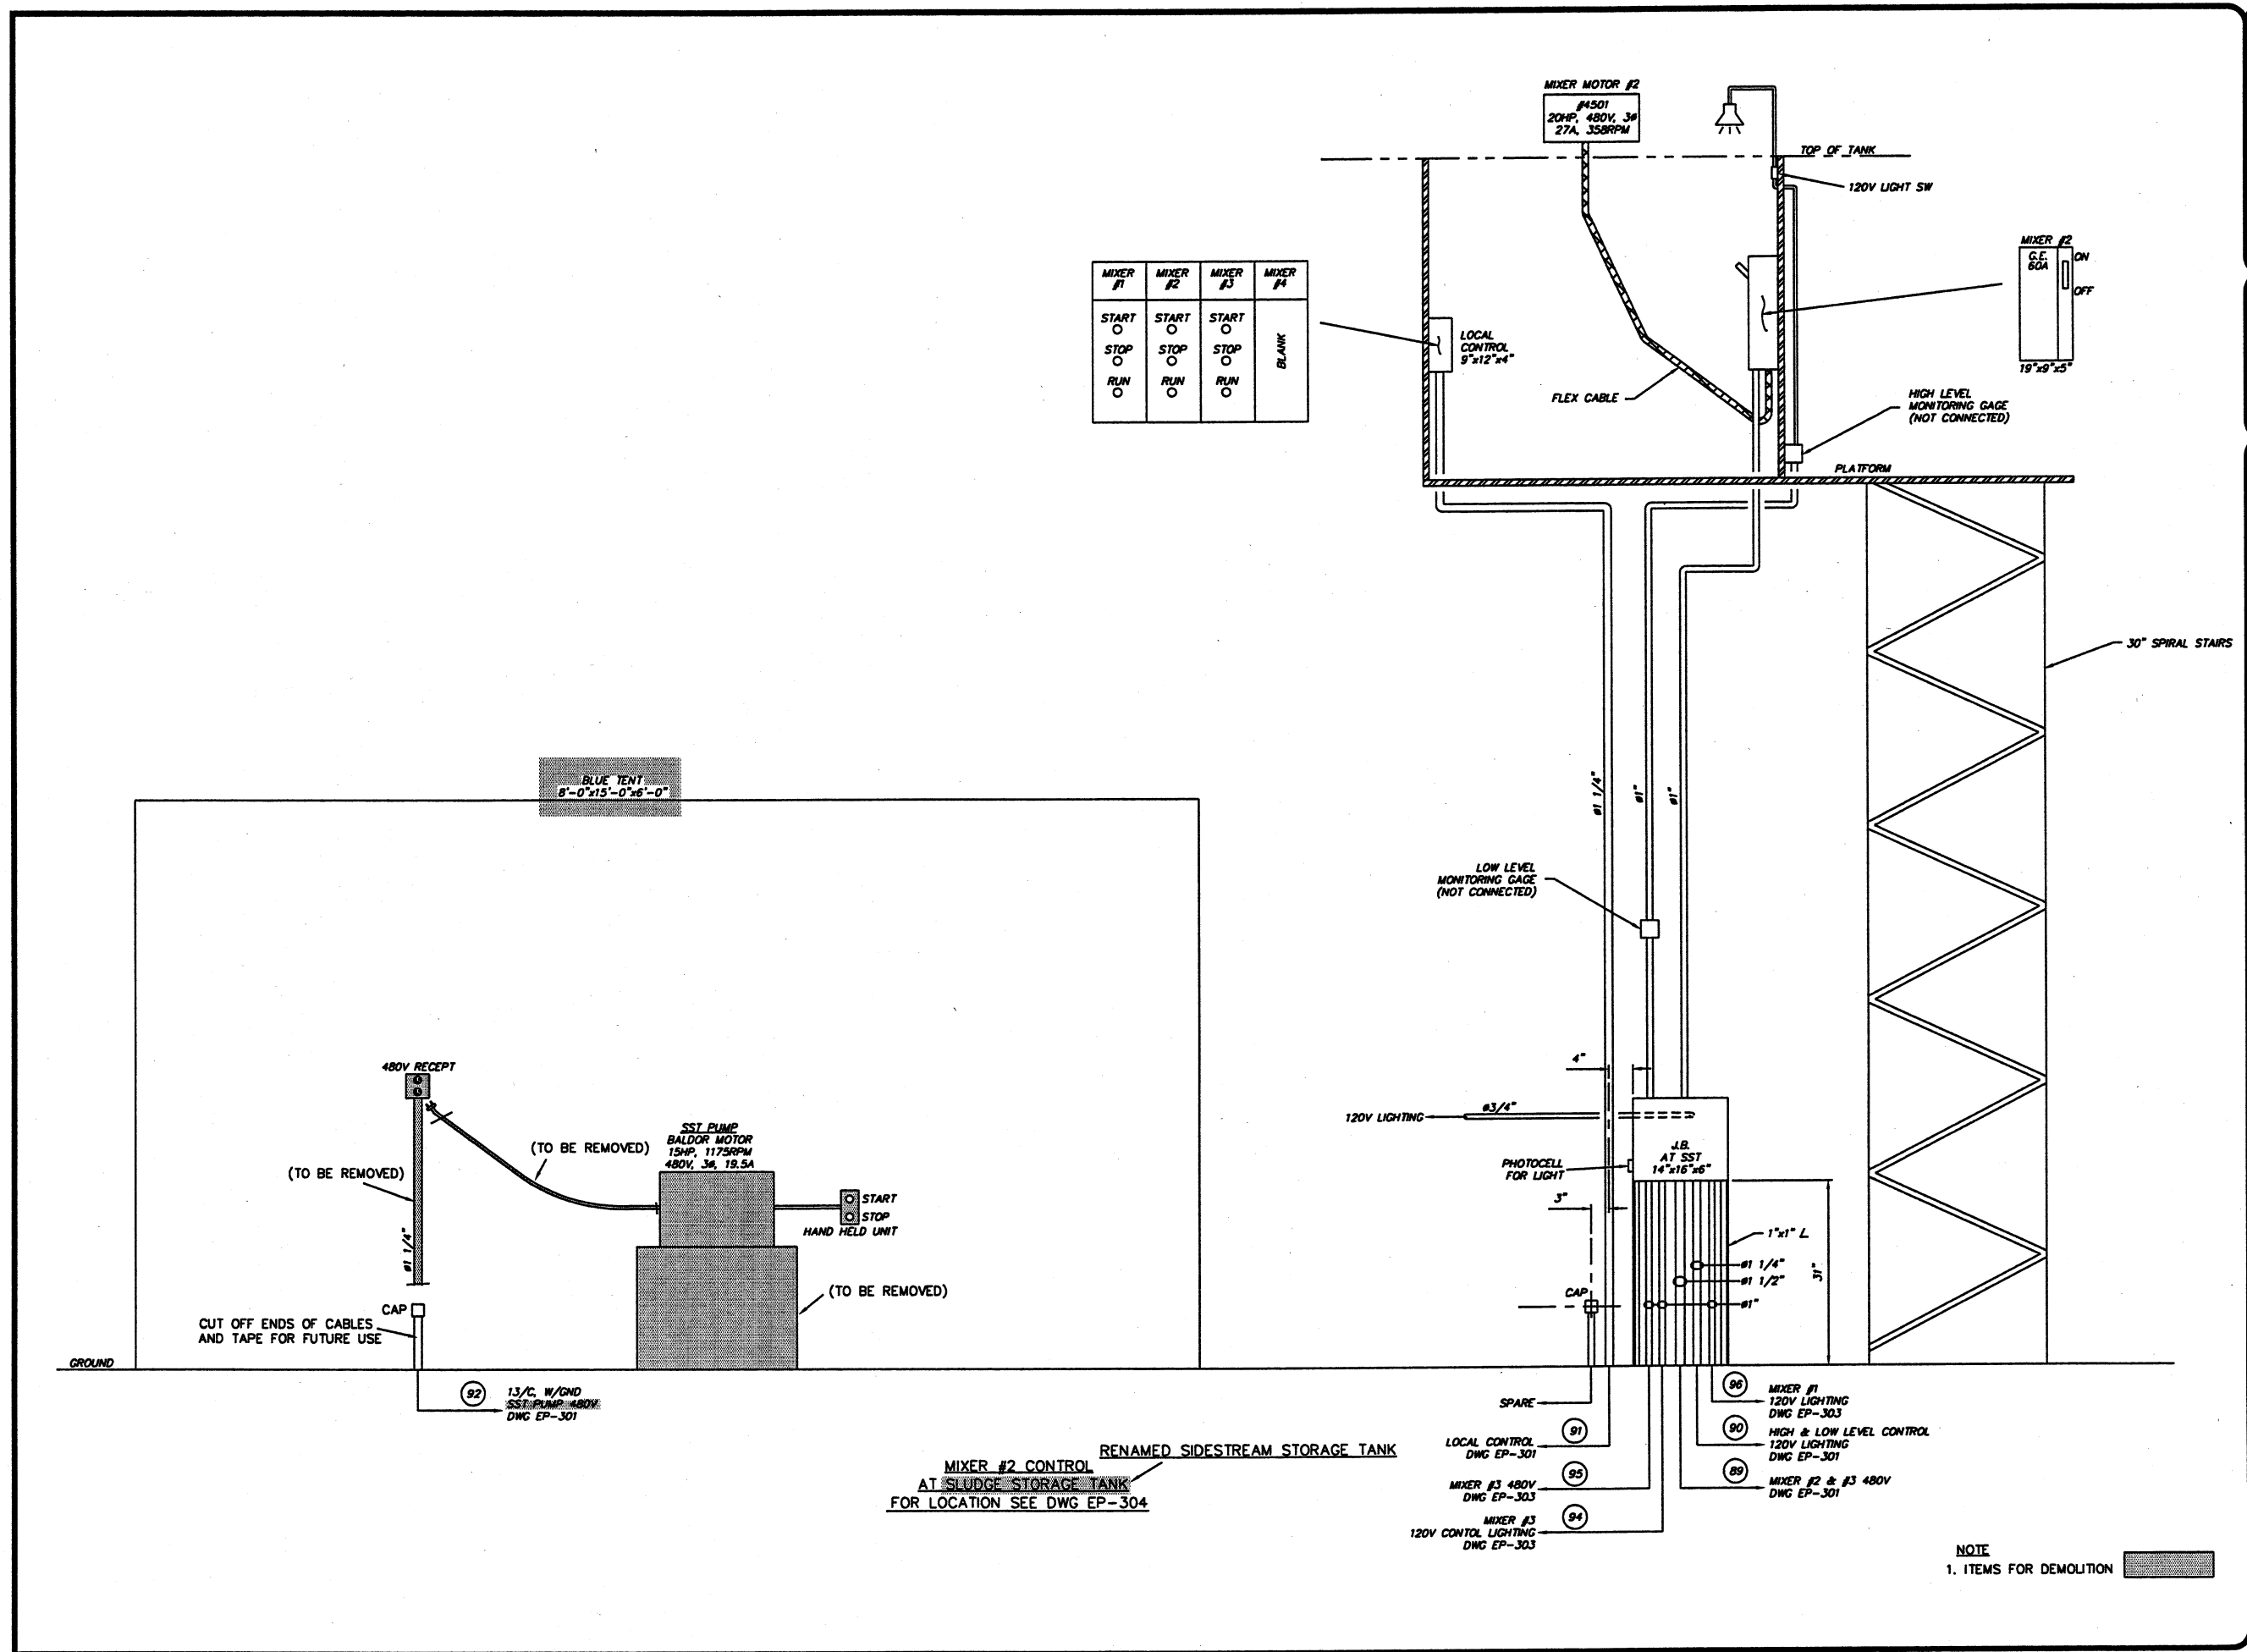

MIXER #1	MIXER #2	MIXER #3	MIXER #4
START ○	START ○	START ○	
STOP ○	STOP ○	STOP ○	
RUN ○	RUN ○	RUN ○	BLANK

SEBEST TECHNOLOGIES, INC.
MASSILLON, OHIO
5674 E. R.J.L.

DESIGNED BY
STI/TSS

DRAWN BY
STI/RRR

CHECKED BY
STI/TSS

APPROVED BY
STI/R/L

REVISIONS
NO. DESCRIPTIONS DATE BY APPD

ENVIRONMENTAL, INC.
ENGINEERS IN WATER AND EARTH SCIENCES
UNIONTOWN, OHIO

CITY OF MASSILLON, OHIO
WWTP UPGRADE 2000
MIXER #2 CONTROL, DEMOLITION PLAN
AT SLUDGE STORAGE TANK

JOB NO.
E9031
DATE
05/19/00
SCALE
1"=1'
SHEET
EP302-D

9031SPLE302D.DWG