


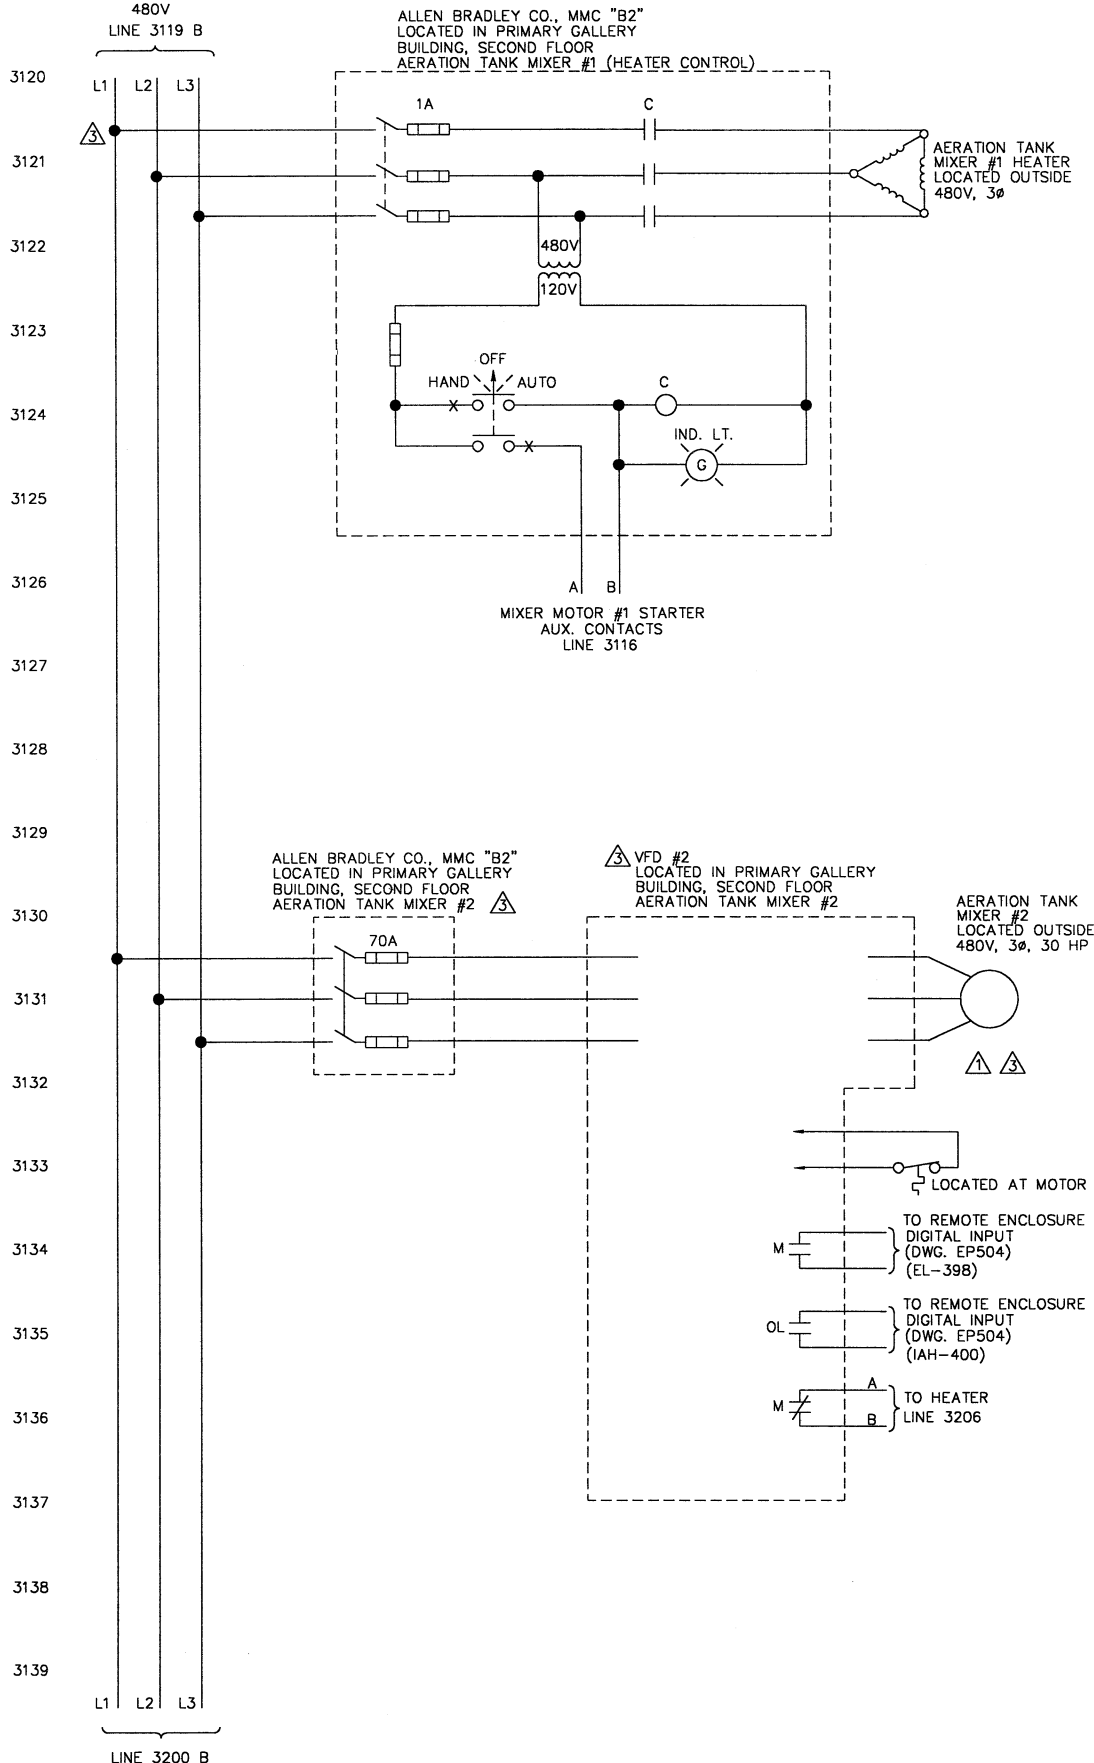

DESIGNED BY		REVISIONS				DATE		BY		APPROD	
STI/TSS		NO.		DESCRIPTIONS		DATE		BY		APPROD	
DRAWN BY		1		REVISED AS PER CONSTRUCTION		9/13/02		TSS			
STI/TSS		2		MARKED UP PRINTS		11/04/02		R/L			
CHECKED BY		3		ADDED (2) VTD'S, REMOVED CAP'S		5/06/04		TSS			
STI/TSS											
APPROVED BY											
STI/R/L											

CTI ENVIRONMENTAL, INC.
ENGINEERS IN WATER AND EARTH SCIENCES
UNIONTOWN, OHIO

CITY OF MASSILLON, OHIO
WWTP UPGRADE 2000
TRANSFORMER "B", MCC-B1 & B2
AERATION TANKS SCHEMATIC DIAGRAM

JOB NO.	E9031
DATE	2/16/01
SCALE	N/A
SHEET	EP31-3