


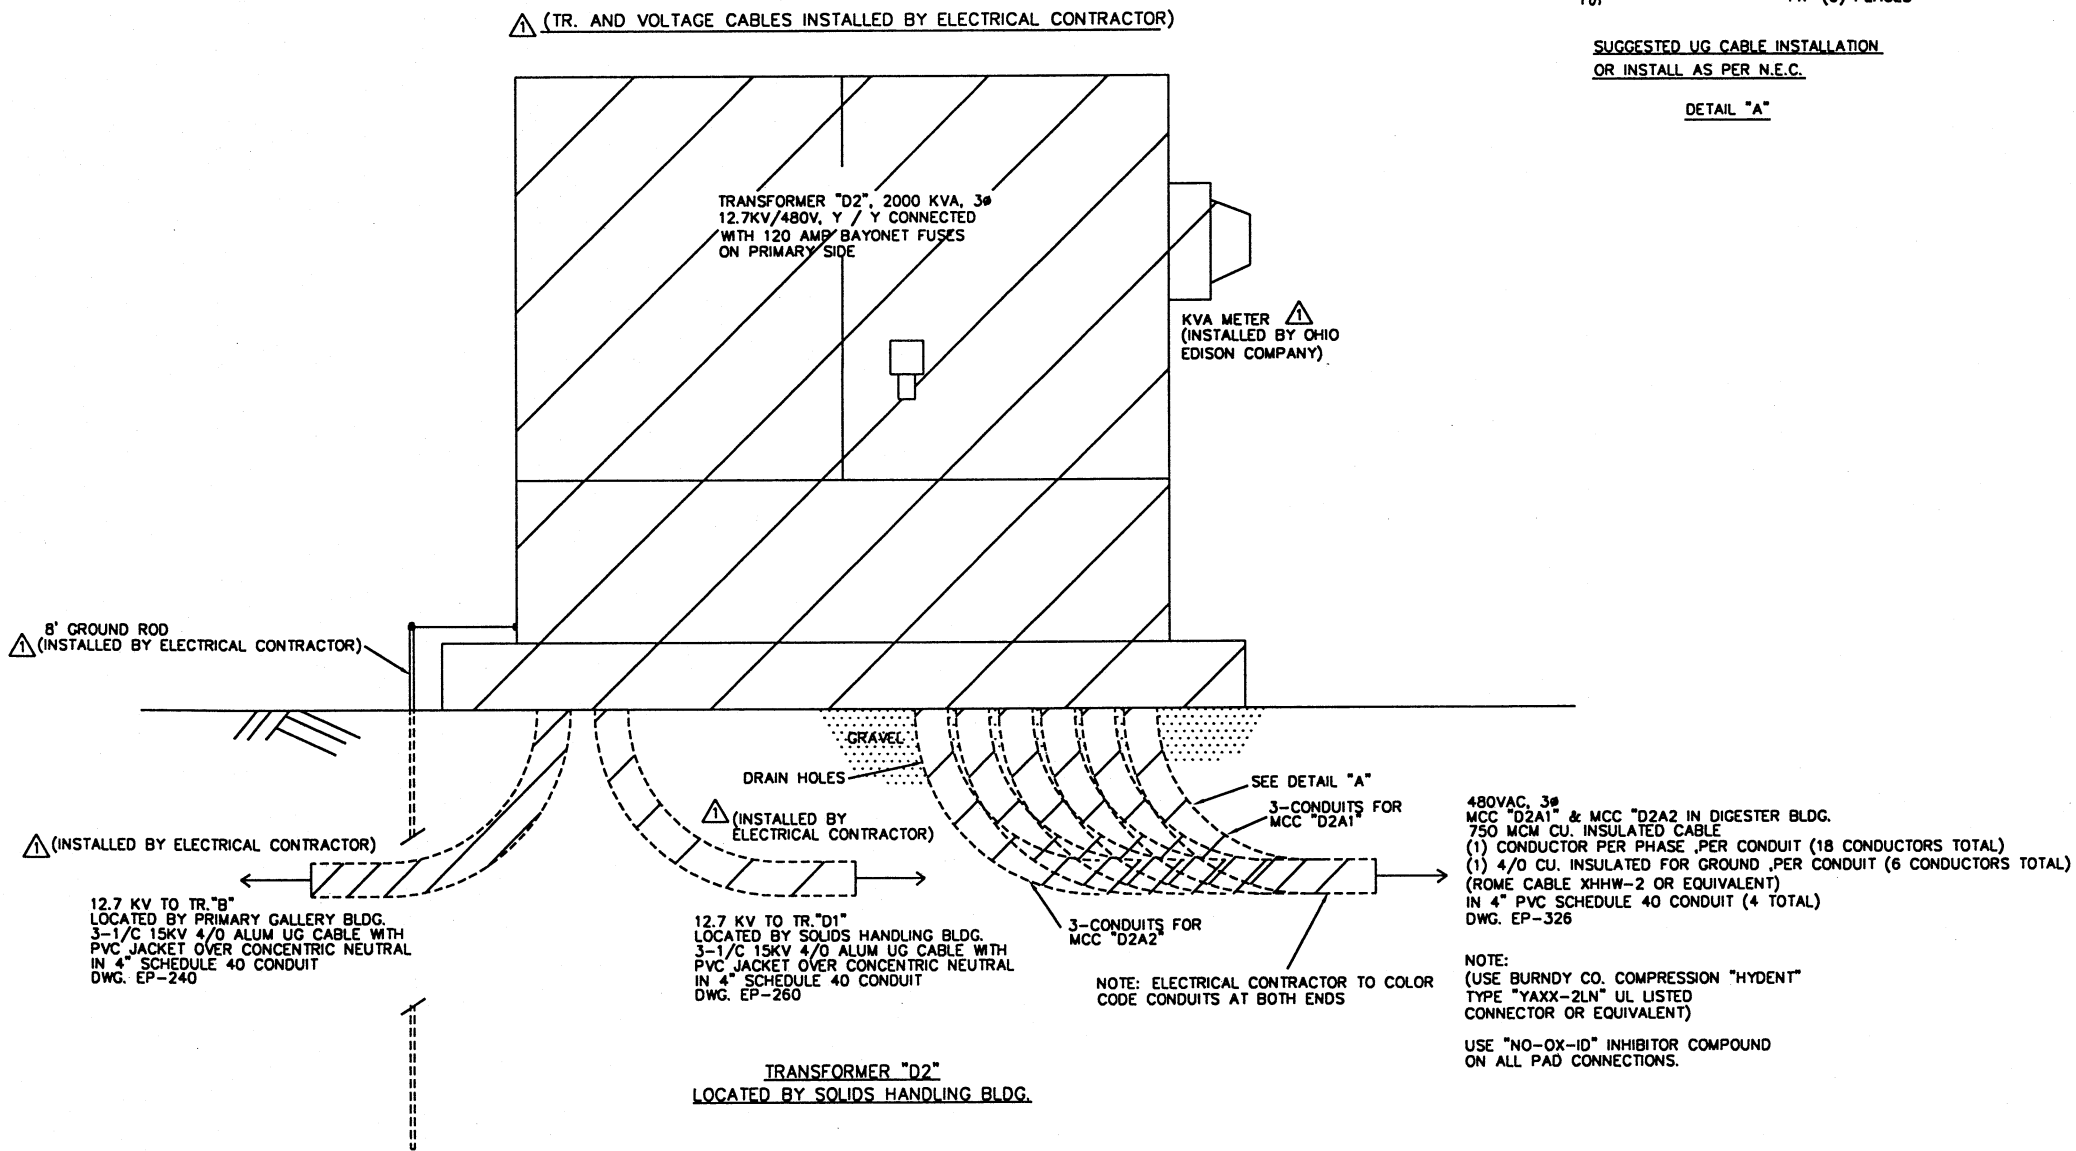

NOTE
1. ITEMS FOR ADDITION 
2. FOR ELECTRICAL SCHEMATICS SEE EP74 THRU EPXX

ENVIRONMENTAL, INC.
ENGINEERS IN WATER AND EARTH SCIENCES
UNIONTOWN, OHIO

CITY OF MASSILLON, OHIO
WWTP UPGRADE, 2000
TRANSFORMER "D2" LAYOUT
LOCATED BY SOLIDS HANDLING BLDG

JOB NO.
E9031
DATE
4/11/01
SCALE
1"=10'
SHEET
EP325-1

BITTERT TECHNOLOGIES, INC.
MASSILLON, OHIO
5674 2ND ST. S.W.
J.L.