


DESIGNED BY		REVISIONS		DATE		BY	
STI/TSS	1	DESCRIPTIONS	1	9/26/02	TSS	R.J.L.	
DRAWN BY	1	REVISED AS PER CONSTRUCTION	2	10/1/02	TSS	R.J.L.	
CHECKED BY		REVISED AS PER CONSTRUCTION					
STI/TSS							
APPROVED BY							
STI/RUL							

ENVIRONMENTAL, INC.
ENGINEERS IN WATER AND EARTH SCIENCES
UNIONTOWN, OHIO

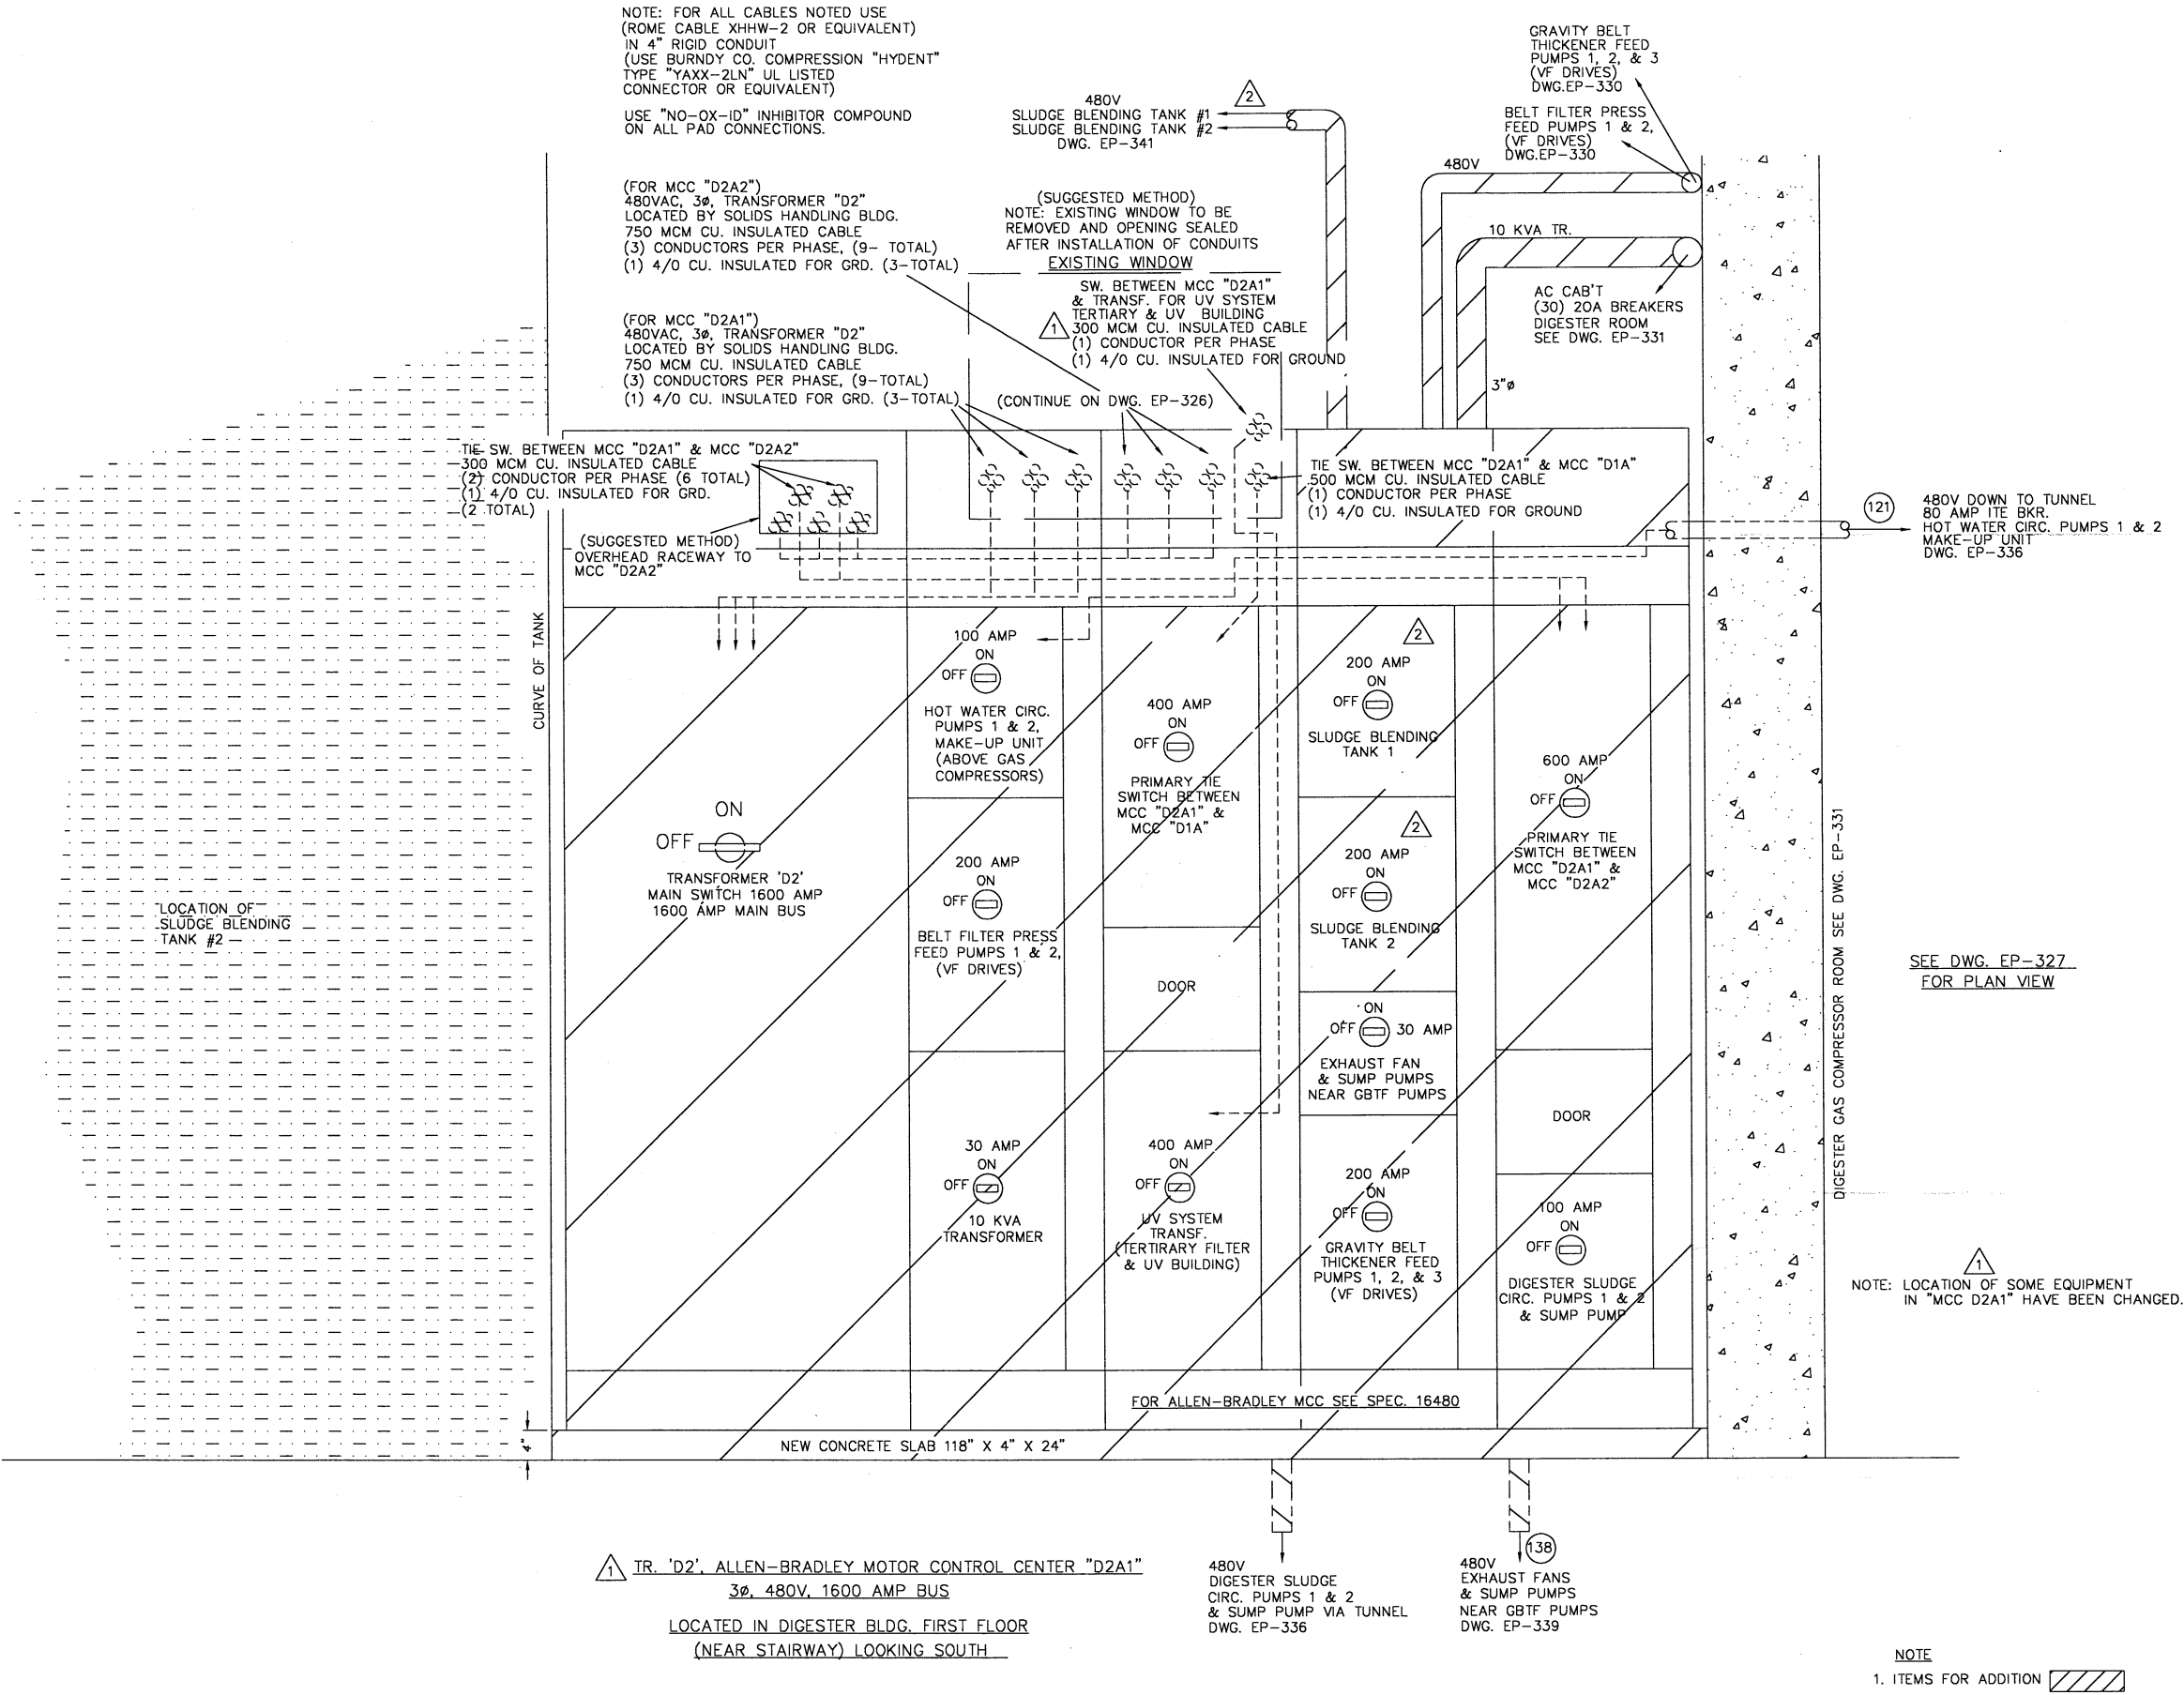

CITY OF MASSILLON, OHIO
WWTP UPGRADE 2000
TR. "D2", MCC "D2A1" INNER WALL, FIRST FLOOR
DIGESTER BUILDING

JOB NO. E9031
DATE 6/18/01
SCALE 1 1/2" = 12"
SHEET EP328-2