


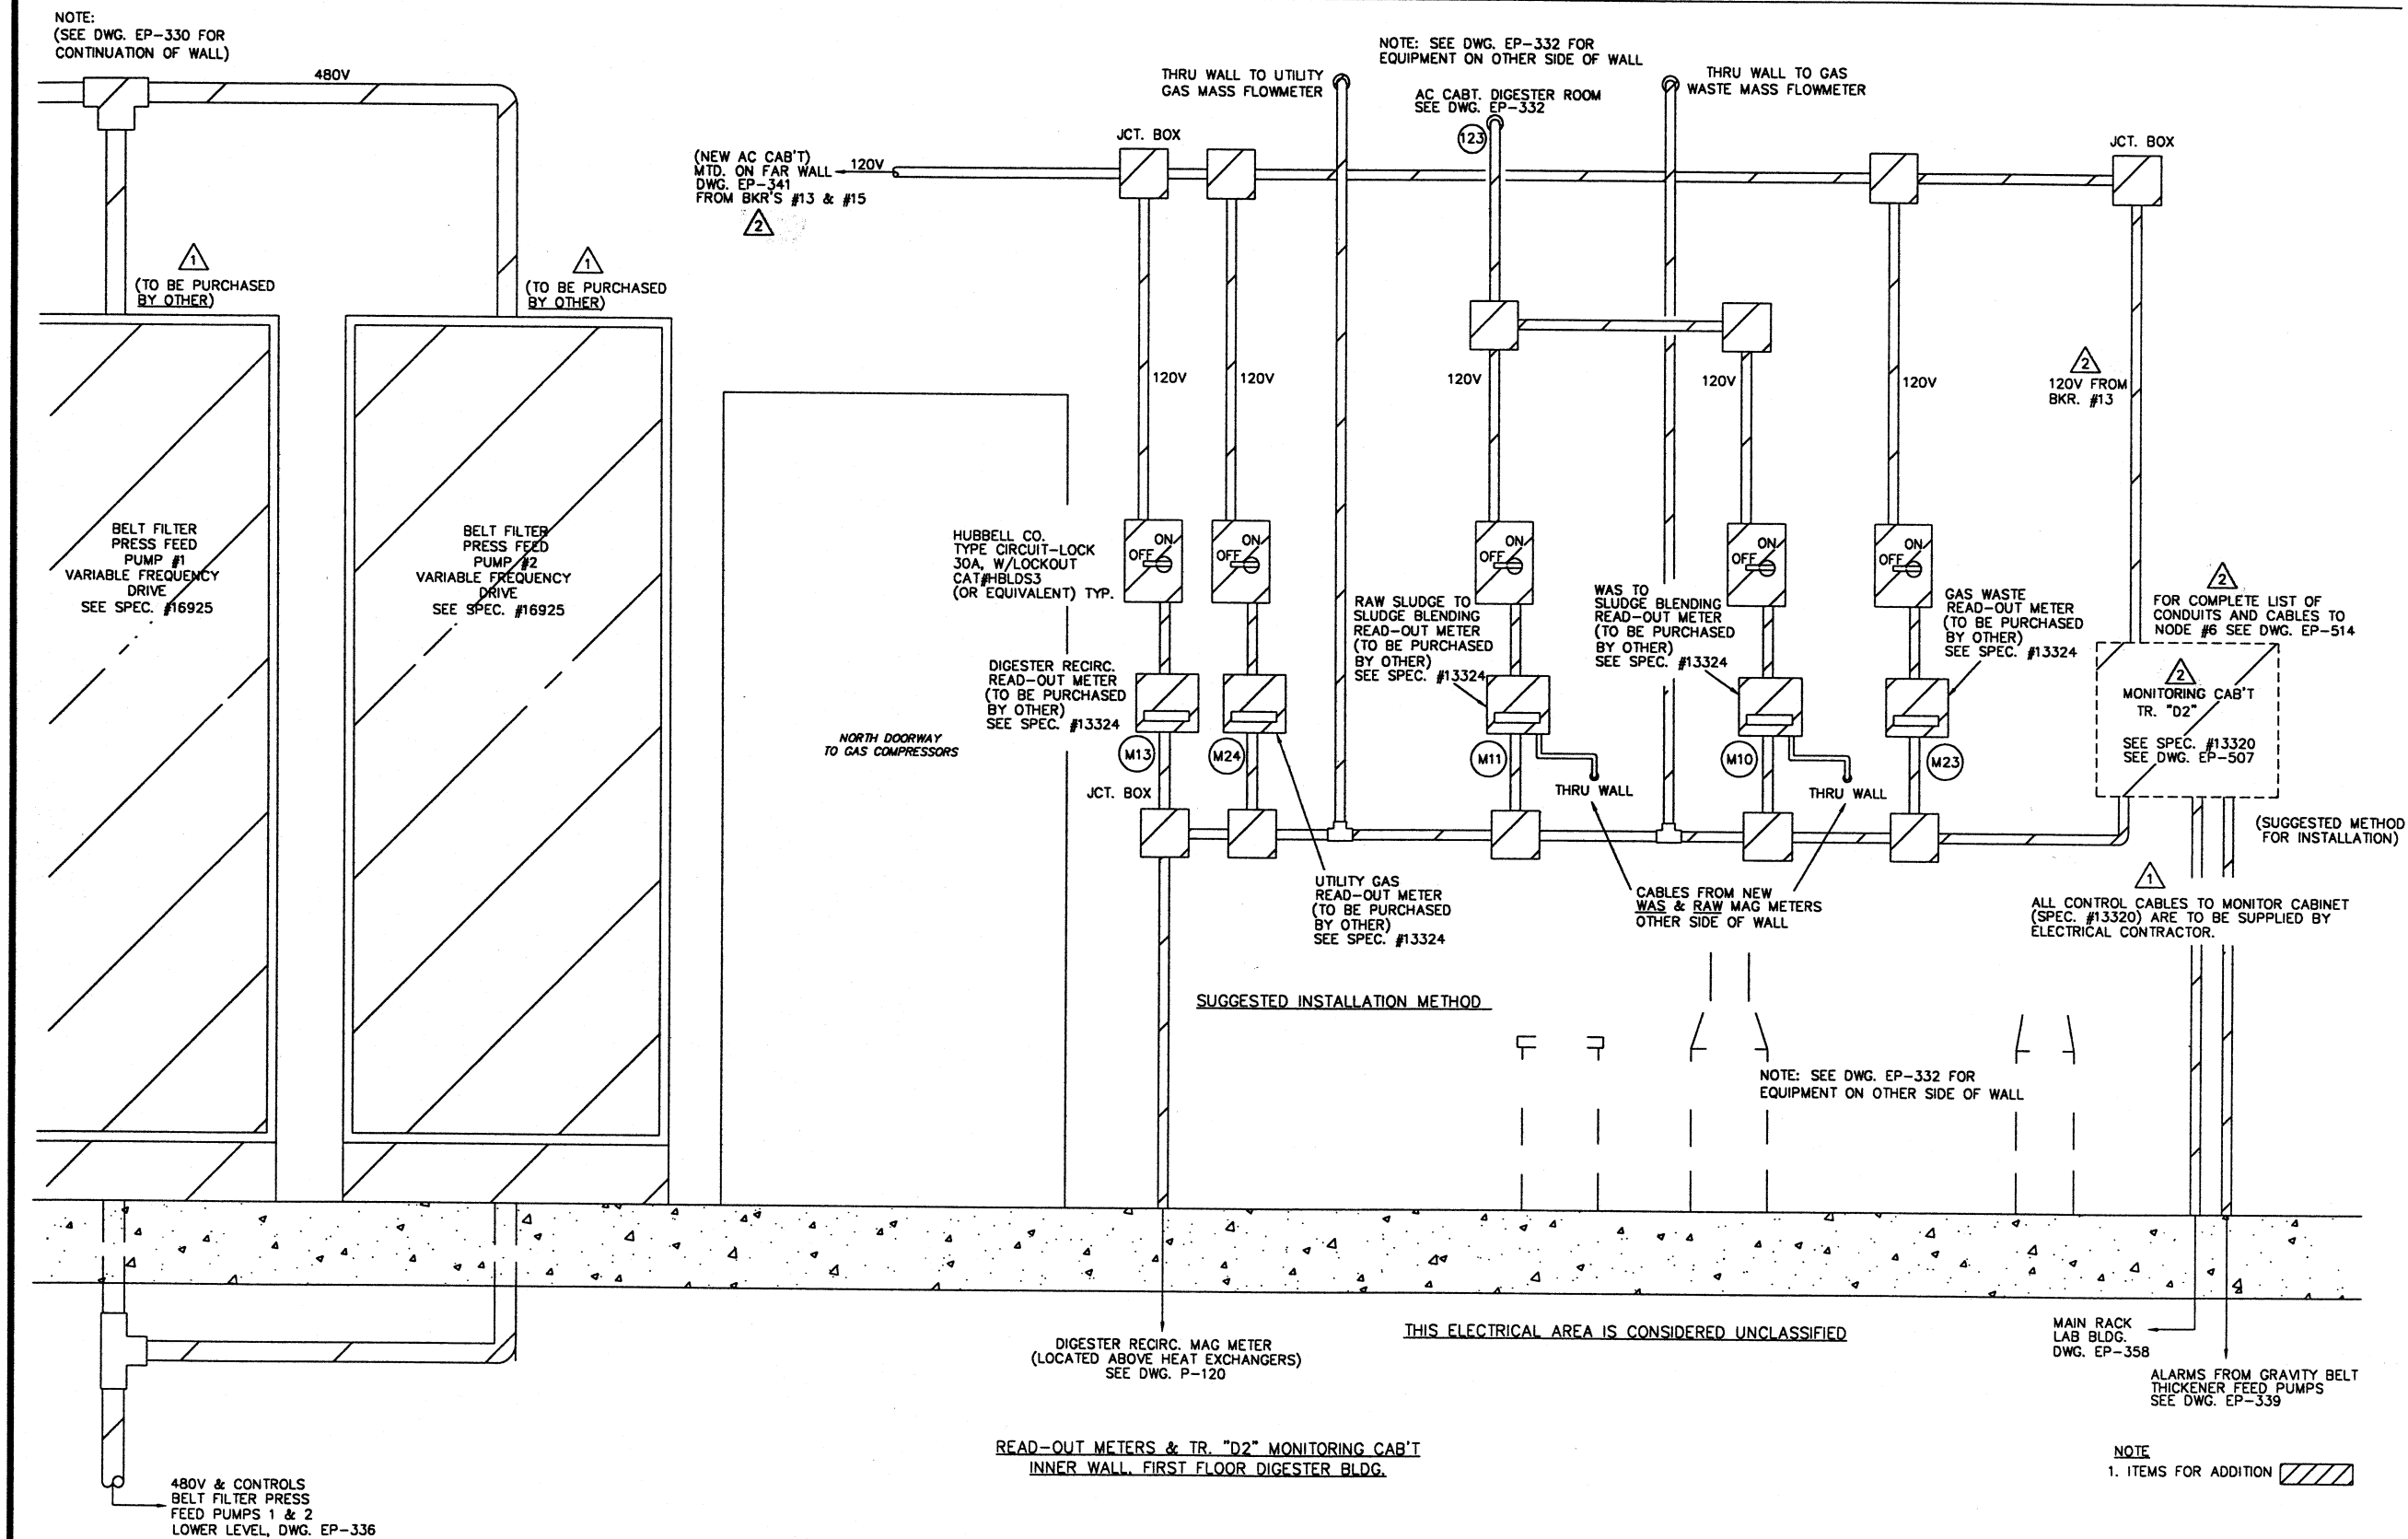

SEI TECHNOLOGIES, INC.
MASSILLON, OHIO
5674 2000 R/L

NO.	DATE	BY	APPROVED
1	9/13/01	TSS	R/L
2	1/28/01	TSS	R/L

DESIGNED BY: STI/TSS
DRAWN BY: STI/TSS
CHECKED BY: STI/TSS
APPROVED BY: STI/R/L

ENVIRONMENTAL, INC.
ENGINEERS IN WATER AND EARTH SCIENCES
UNIONTOWN, OHIO

CITY OF MASSILLON, OHIO
WWTP UPGRADE 2000
TR. "D2", MAG METER READ-OUTS & MONITORING CAB'T
FIRST FLOOR, DIGESTER BUILDING

JOB NO.
E9031
DATE
06/05/01
SCALE
1 1/2" = 12"
SHEET
EP329-2

9031SPLE329.DWG