


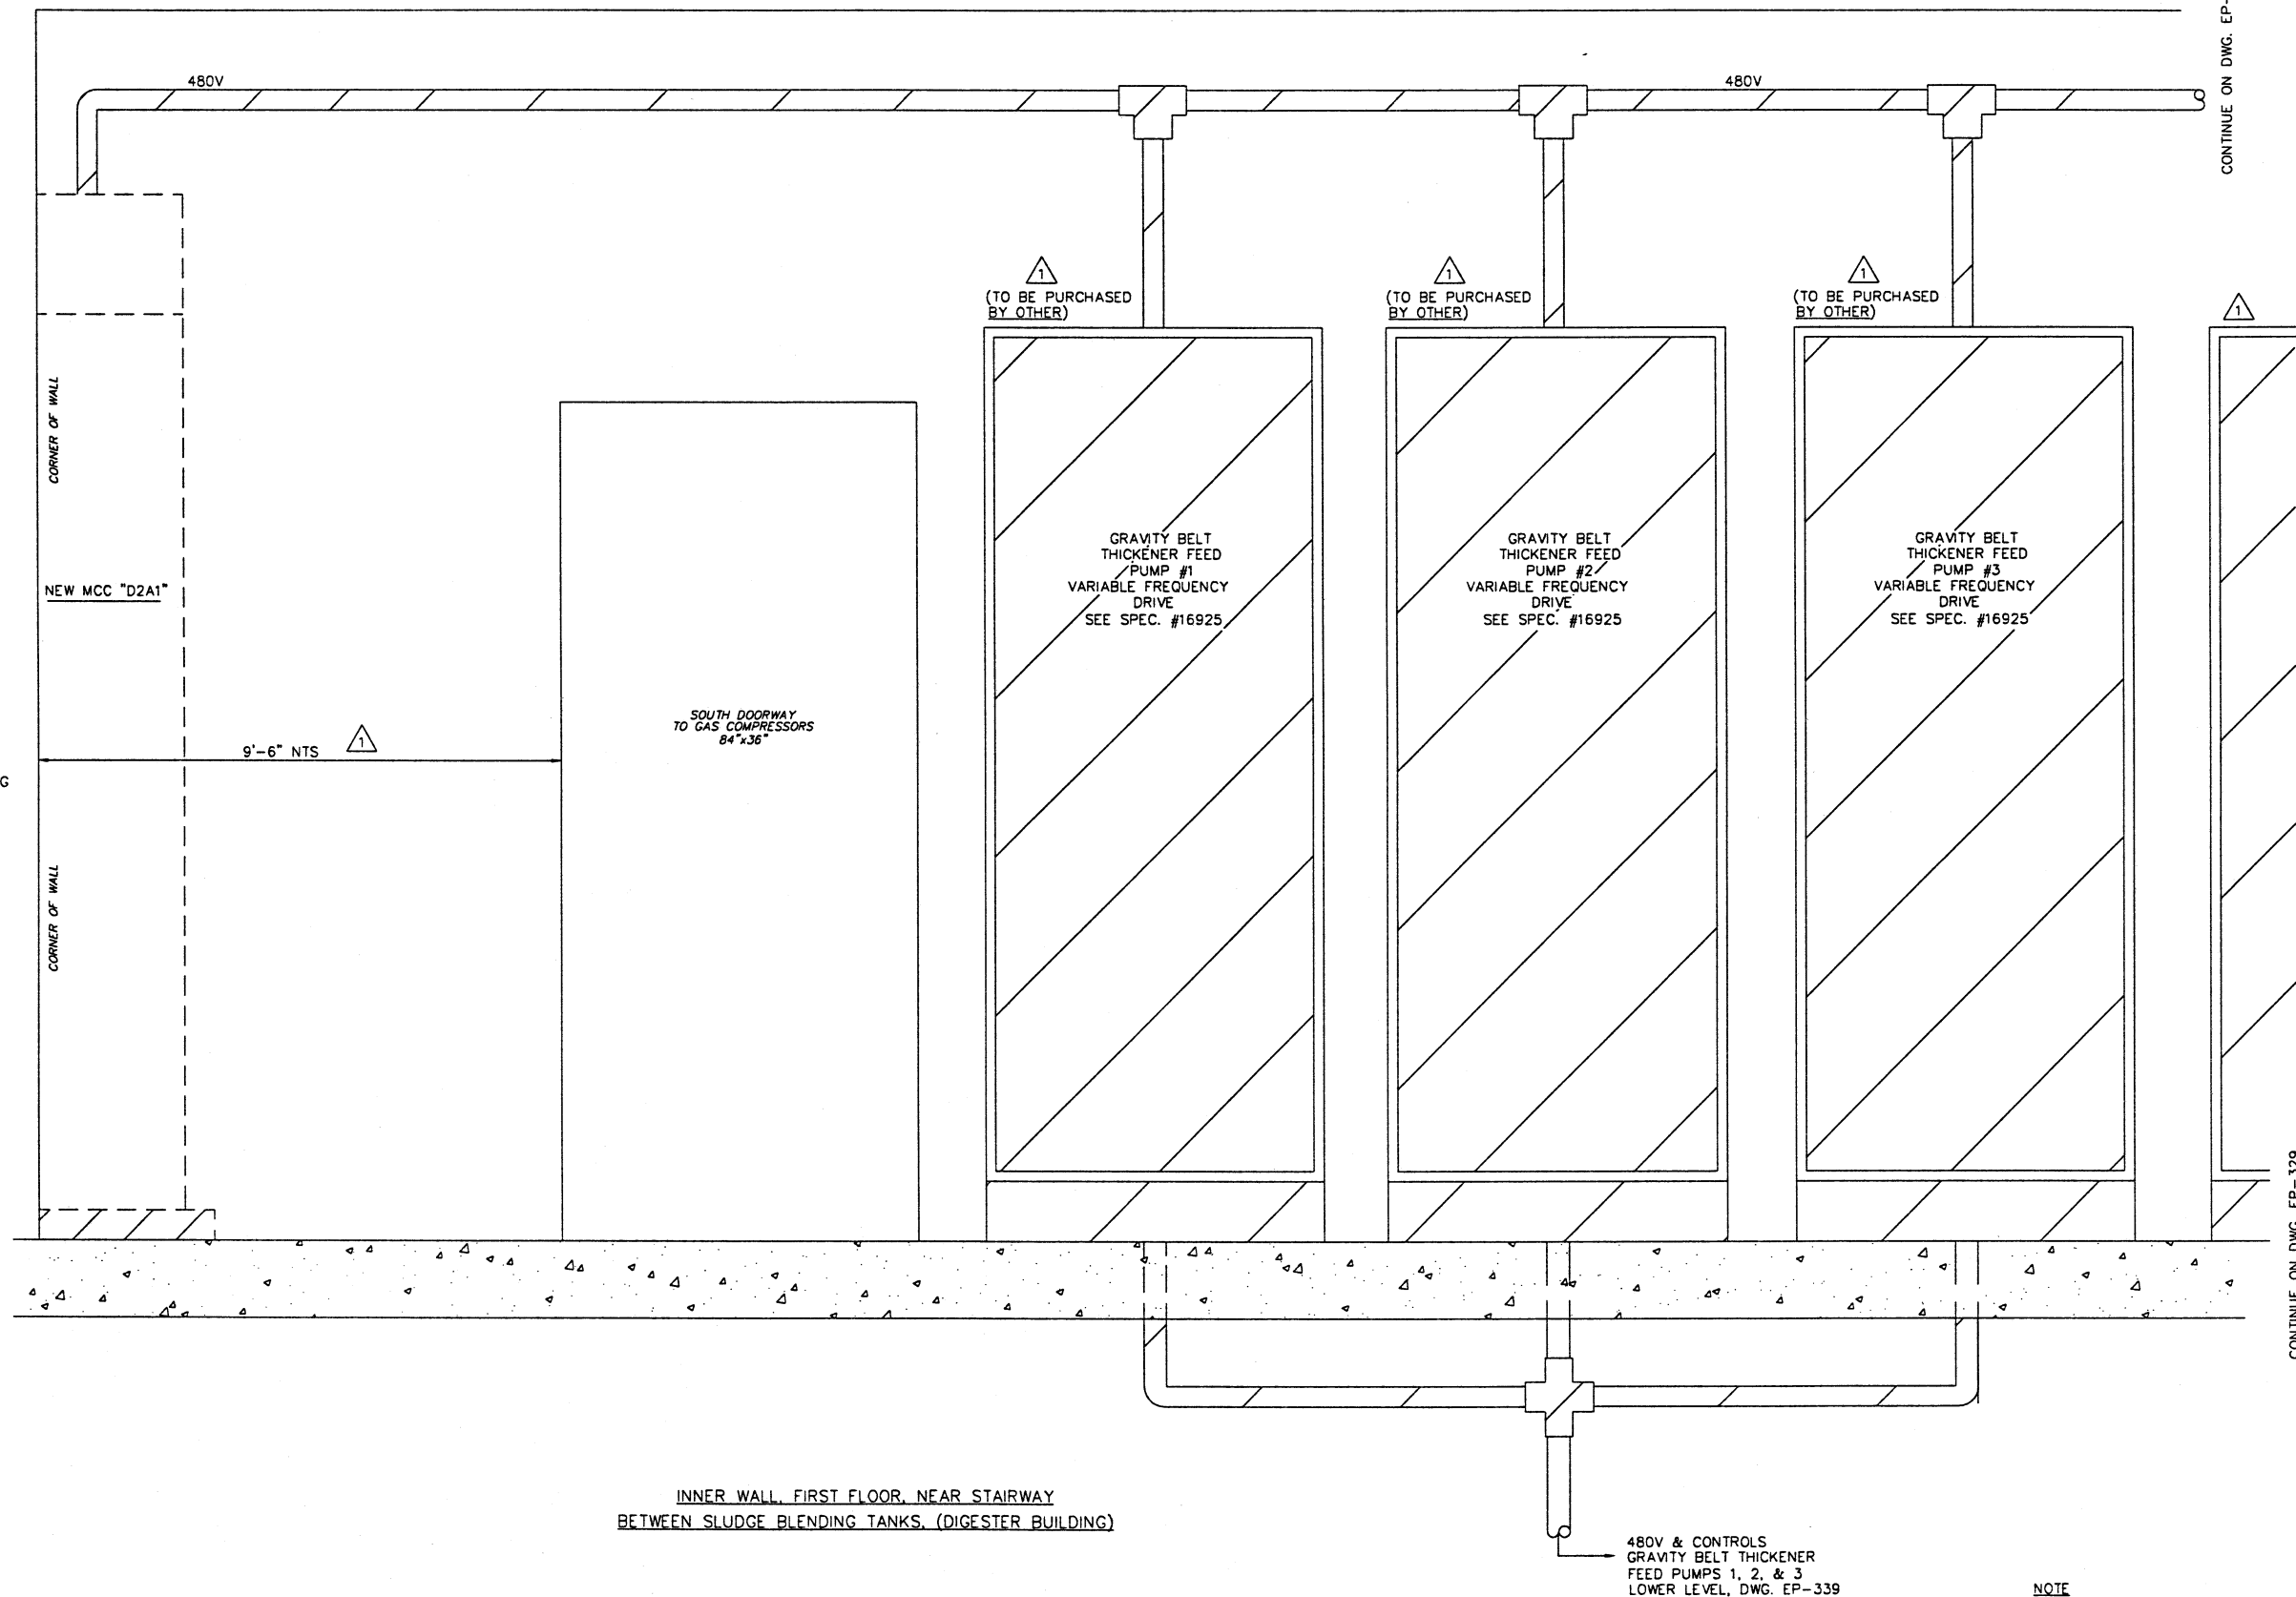

INNER WALL, FIRST FLOOR, NEAR STAIRWAY
BETWEEN SLUDGE BLENDING TANKS, (DIGESTER BUILDING)

NOTE
1. ITEMS FOR ADDITION

SHELBERT TECHNOLOGIES, INC.
MASSILLON, OHIO
TEL: 567.456.7890

DESIGNED BY
STI/TSS

DRAWN BY
STI/TSS

CHECKED BY
STI/TSS

APPROVED BY
STI/RUL

NO. 1

REVISIONS
DESCRIPTIONS
DATE BY APP'D
REVISED AS PER CONSTRUCTION 9/13/02 TSS RUL

ENVIRONMENTAL, INC.
ENGINEERS IN WATER AND EARTH SCIENCES
UNIONTOWN, OHIO

CITY OF MASSILLON, OHIO
WWTP UPGRADE 2000
TR: "D2", MCC "D2A1", & VARIABLE FREQUENCY DRIVES
INNER WALL, FIRST FLOOR, DIGESTER BUILDING

JOB NO.
E9031

DATE
6/11/01

SCALE
1 1/2" = 12"

SHEET
EP330