


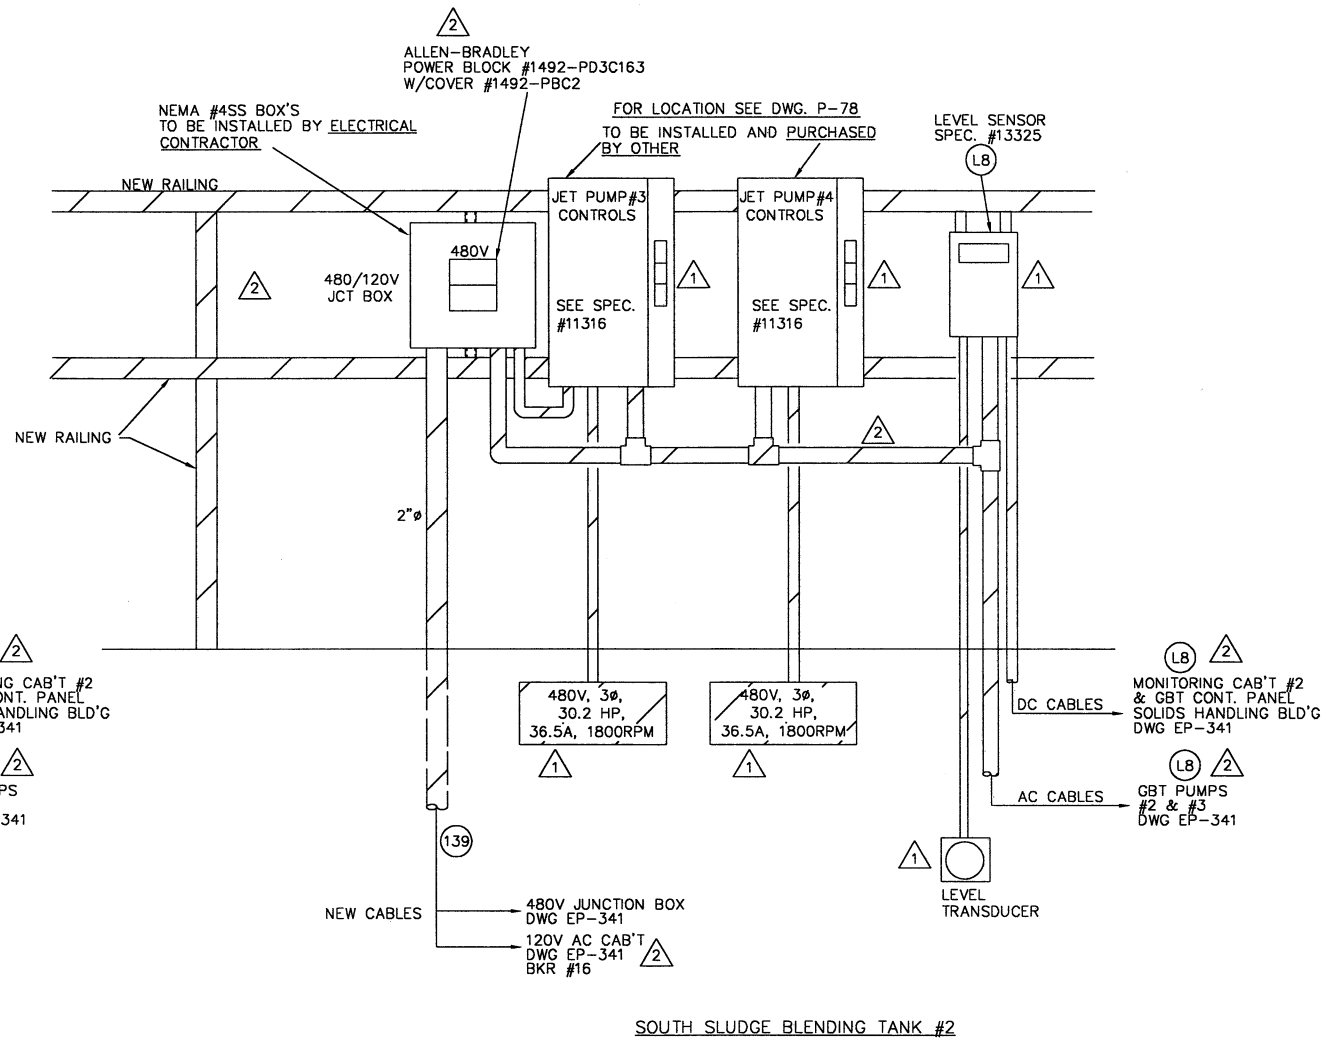

CTI ENVIRONMENTAL, INC.
ENGINEERS IN WATER AND EARTH SCIENCES
UNIONTOWN, OHIO

CITY OF MASSILLON, OHIO
WWTP UPGRADE 2000
TRANSFORMER "D2" MOTOR CONTROL CENTER
SLUDGE BLENDING TANK #1 AND #2

DESIGNED BY		REVISIONS				BY		APP'D	
NO.	DESCRIPTION	DATE	TSS	R.J.L.	TSS	R.J.L.	TSS	R.J.L.	
1	REVISED AS PER CONSTRUCTION	7/13/02							
2	REVISED AS PER CONSTRUCTION	1/29/03							
	CHECKED BY								
	STI/TSS								
	APPROVED BY								
	STI/RUL								