


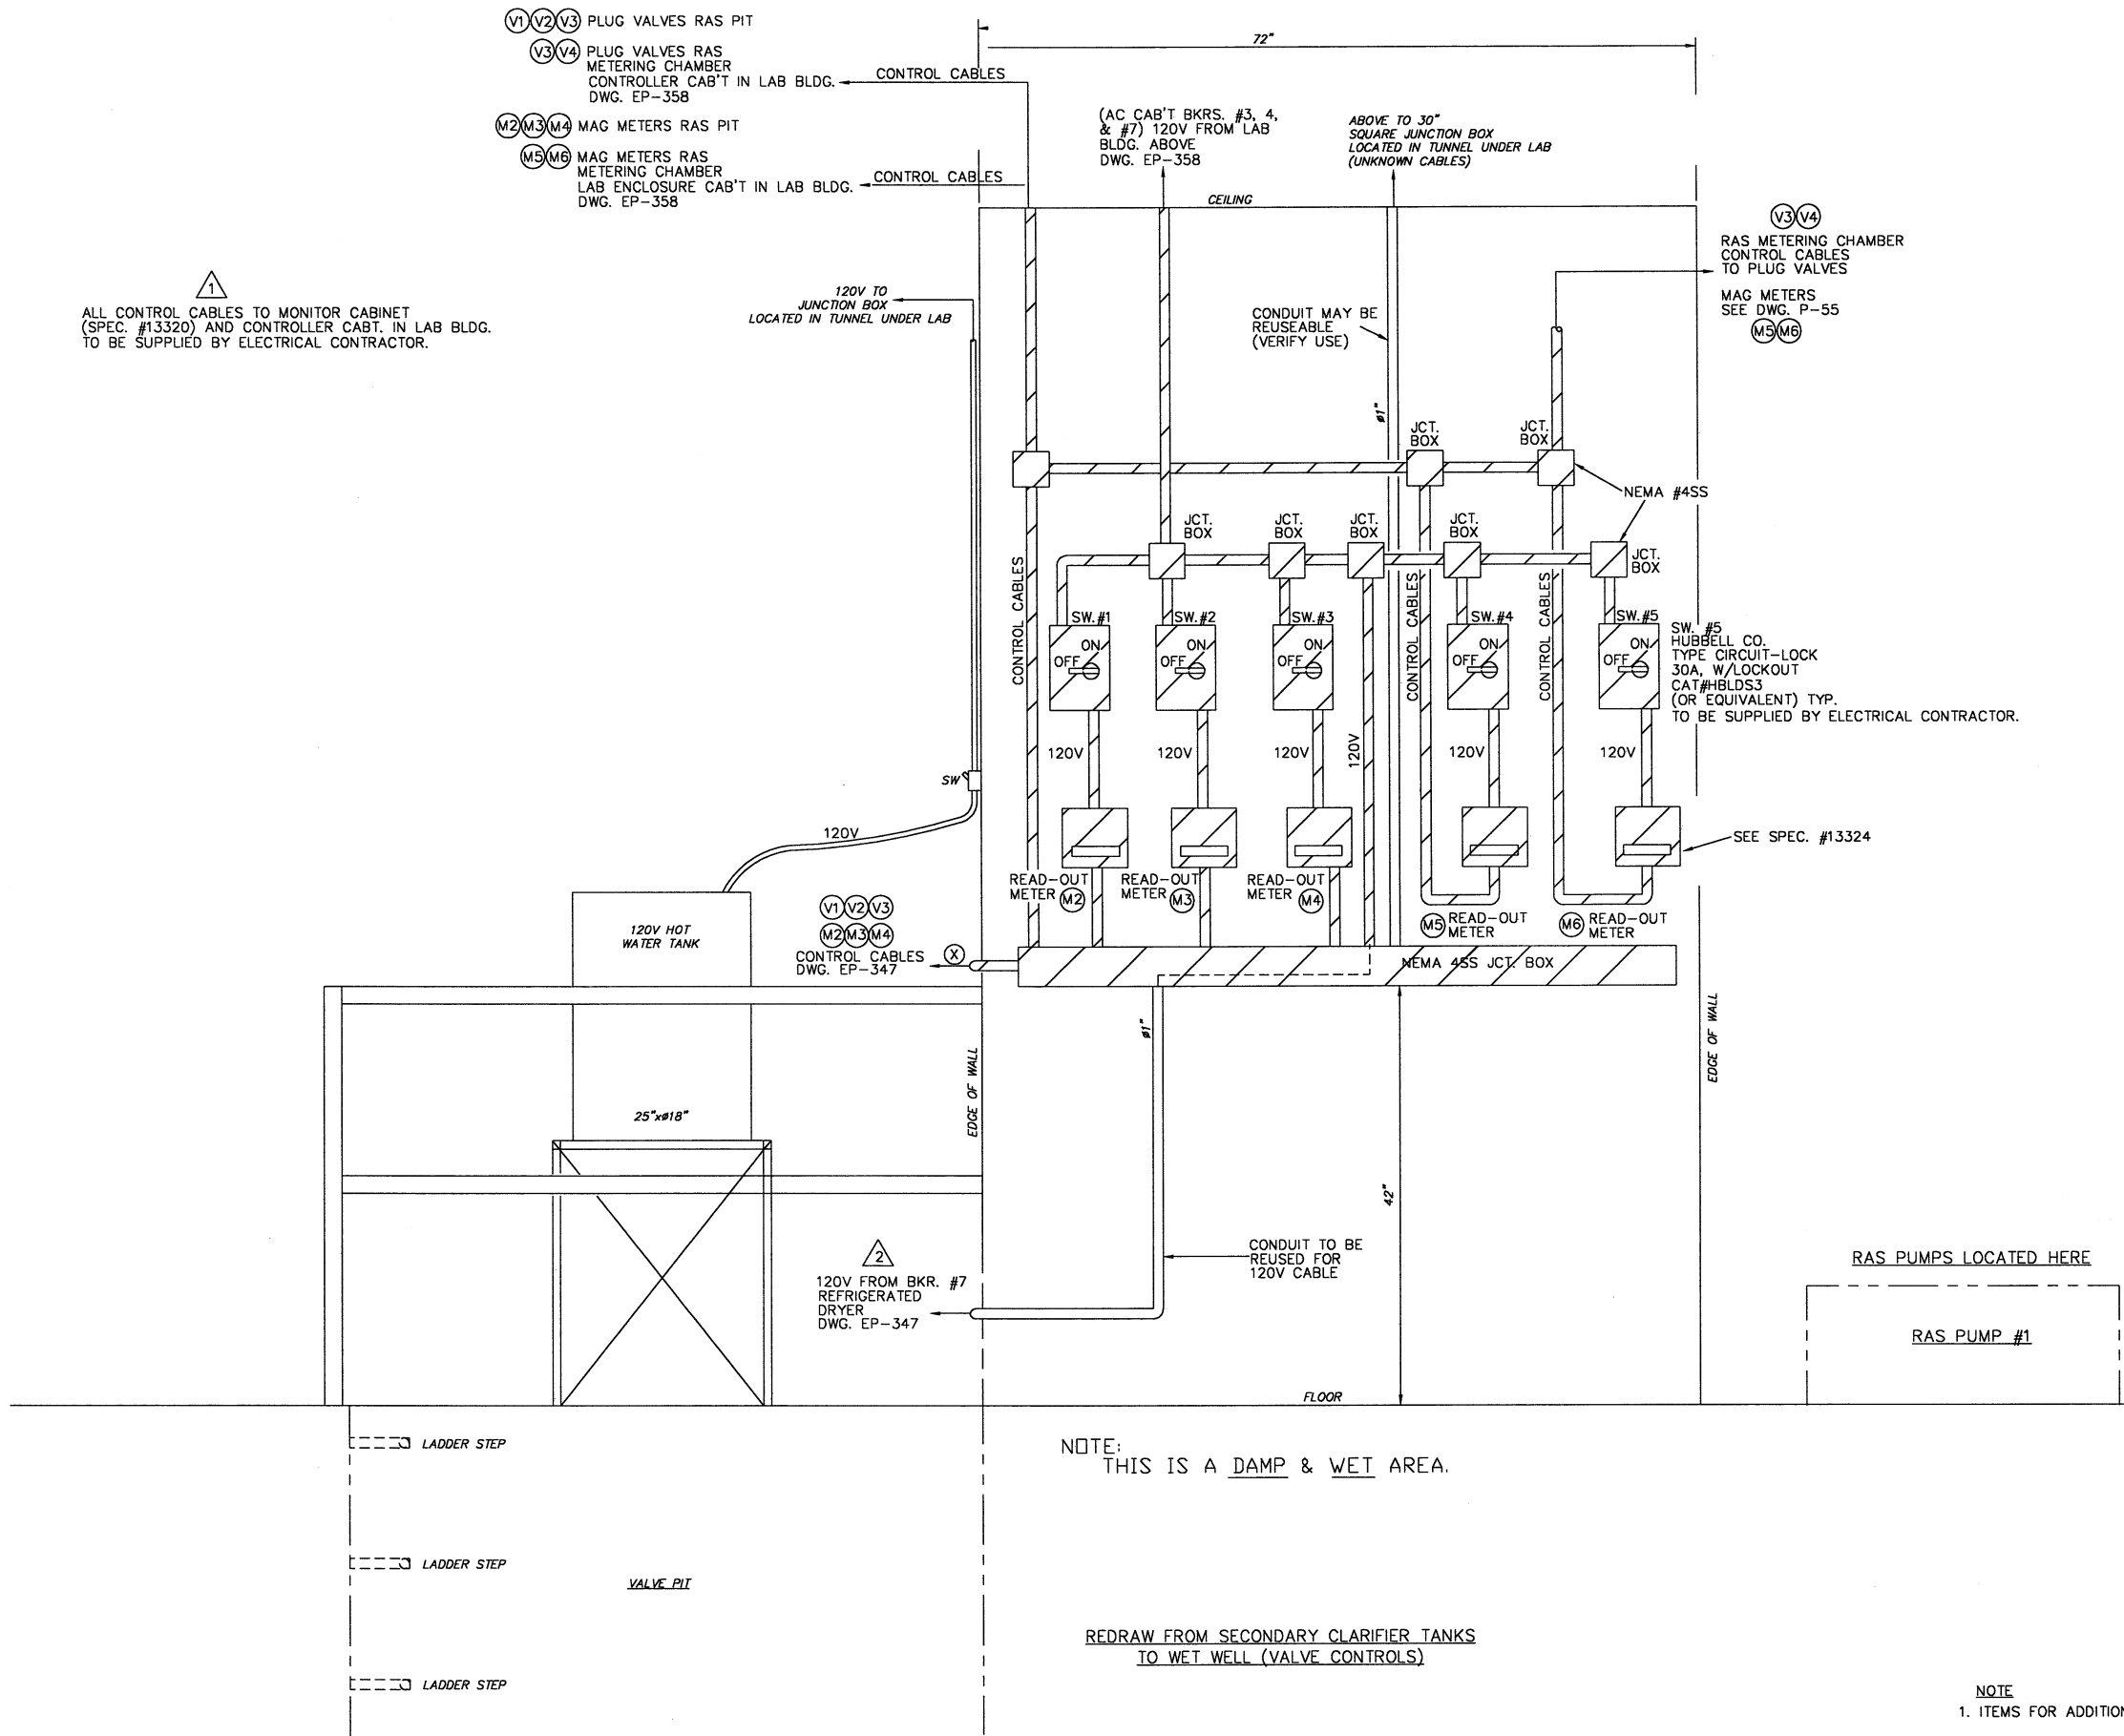

SHIPT TECHNOLOGIES, INC.
MASSILLON, OHIO
DWG. NO. 5674
REV. 01

DESIGNED BY: STI/TSS
DRAWN BY: STI/TSS
CHECKED BY: STI/TSS
APPROVED BY: STI/RL

REVISIONS
NO. DESCRIPTIONS DATE BY APP'D
1 ADDED CONTROL CABLE NOTE 5/7/01 TSS R/L
2 REVISED AS PER CONSTRUCTION 1/3/03 TSS R/L

ENVIRONMENTAL, INC.
ENGINEERS IN WATER AND EARTH SCIENCES
UNIONTOWN, OHIO
CITY OF MASSILLON, OHIO
WWTP UPGRADE 2000
TR. "D2", VALVE & METER CONTROLS #1 THRU #5
FOR SECONDARY SLUDGE (LOCATED BY RAS PUMPS)

JOB NO.
E9031
DATE
5/7/01
SCALE
1 1/2" = 12"
SHEET
EP346-2

9031SPLE346.DWG