



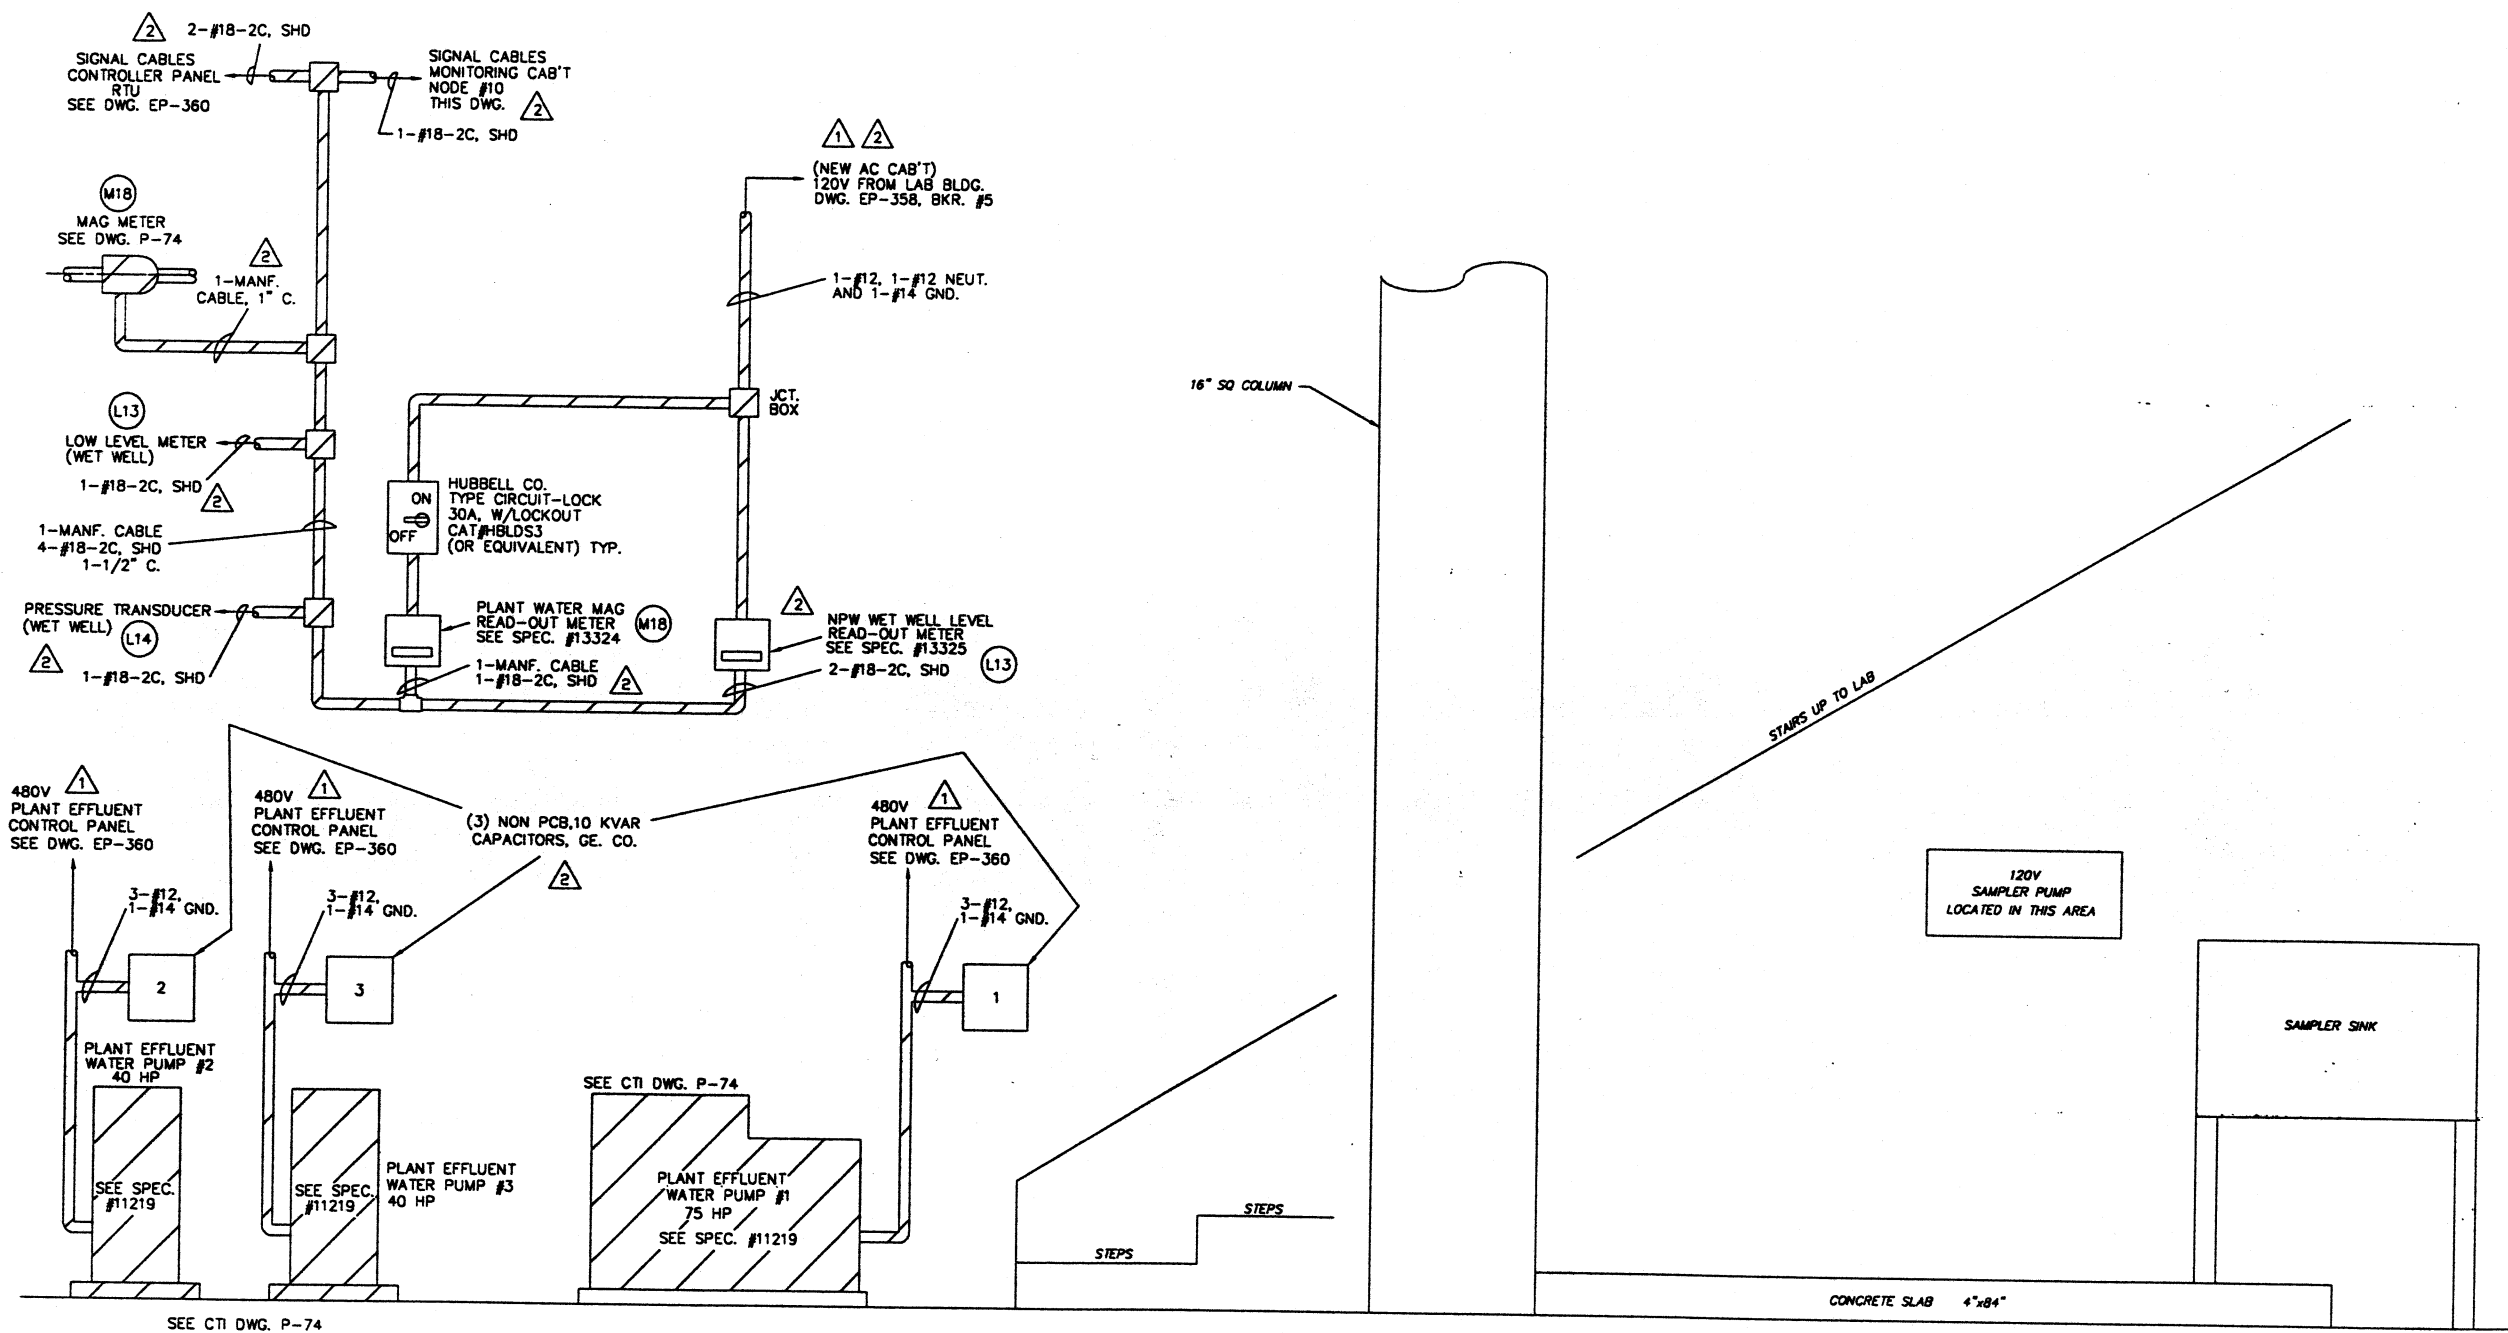

THIS ELECTRICAL AREA IS CONSIDERED UNCLASSIFIED

PLANT EFFLUENT WATER PUMP #1
LOCATED NEAR RAS PUMPS
UNDER LAB BUILDING

NOTE
1. ITEMS FOR ADDITION

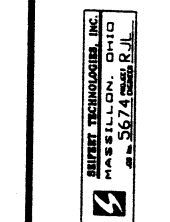

DESIGNED BY	NO.	DESCRIPTIONS	DATE	BY	APP'D
STI/TSS	1	REVISED AS PER CONSTRUCTION	9/10/00	TSS	R.L.
STI/TSS	2	REVISED AS PER CONSTRUCTION	4/10/01	TSS	R.L.
STI/TSS					
STI/TSS					
STI/TSS					

ENVIRONMENTAL, INC.
ENGINEERS IN WATER AND EARTH SCIENCES
UNIONTOWN, OHIO
CITY OF MASSILLON, OHIO
WWTP UPGRADE 2000
TR. "D2", PLANT EFFLUENT WATER PUMP #1
LOCATED UNDER LAB BUILDING

JOB NO.	E9031
DATE	03/05/01
SCALE	1 1/2" = 12"
SHEET	EP349-2

9031SPLE349.DWG